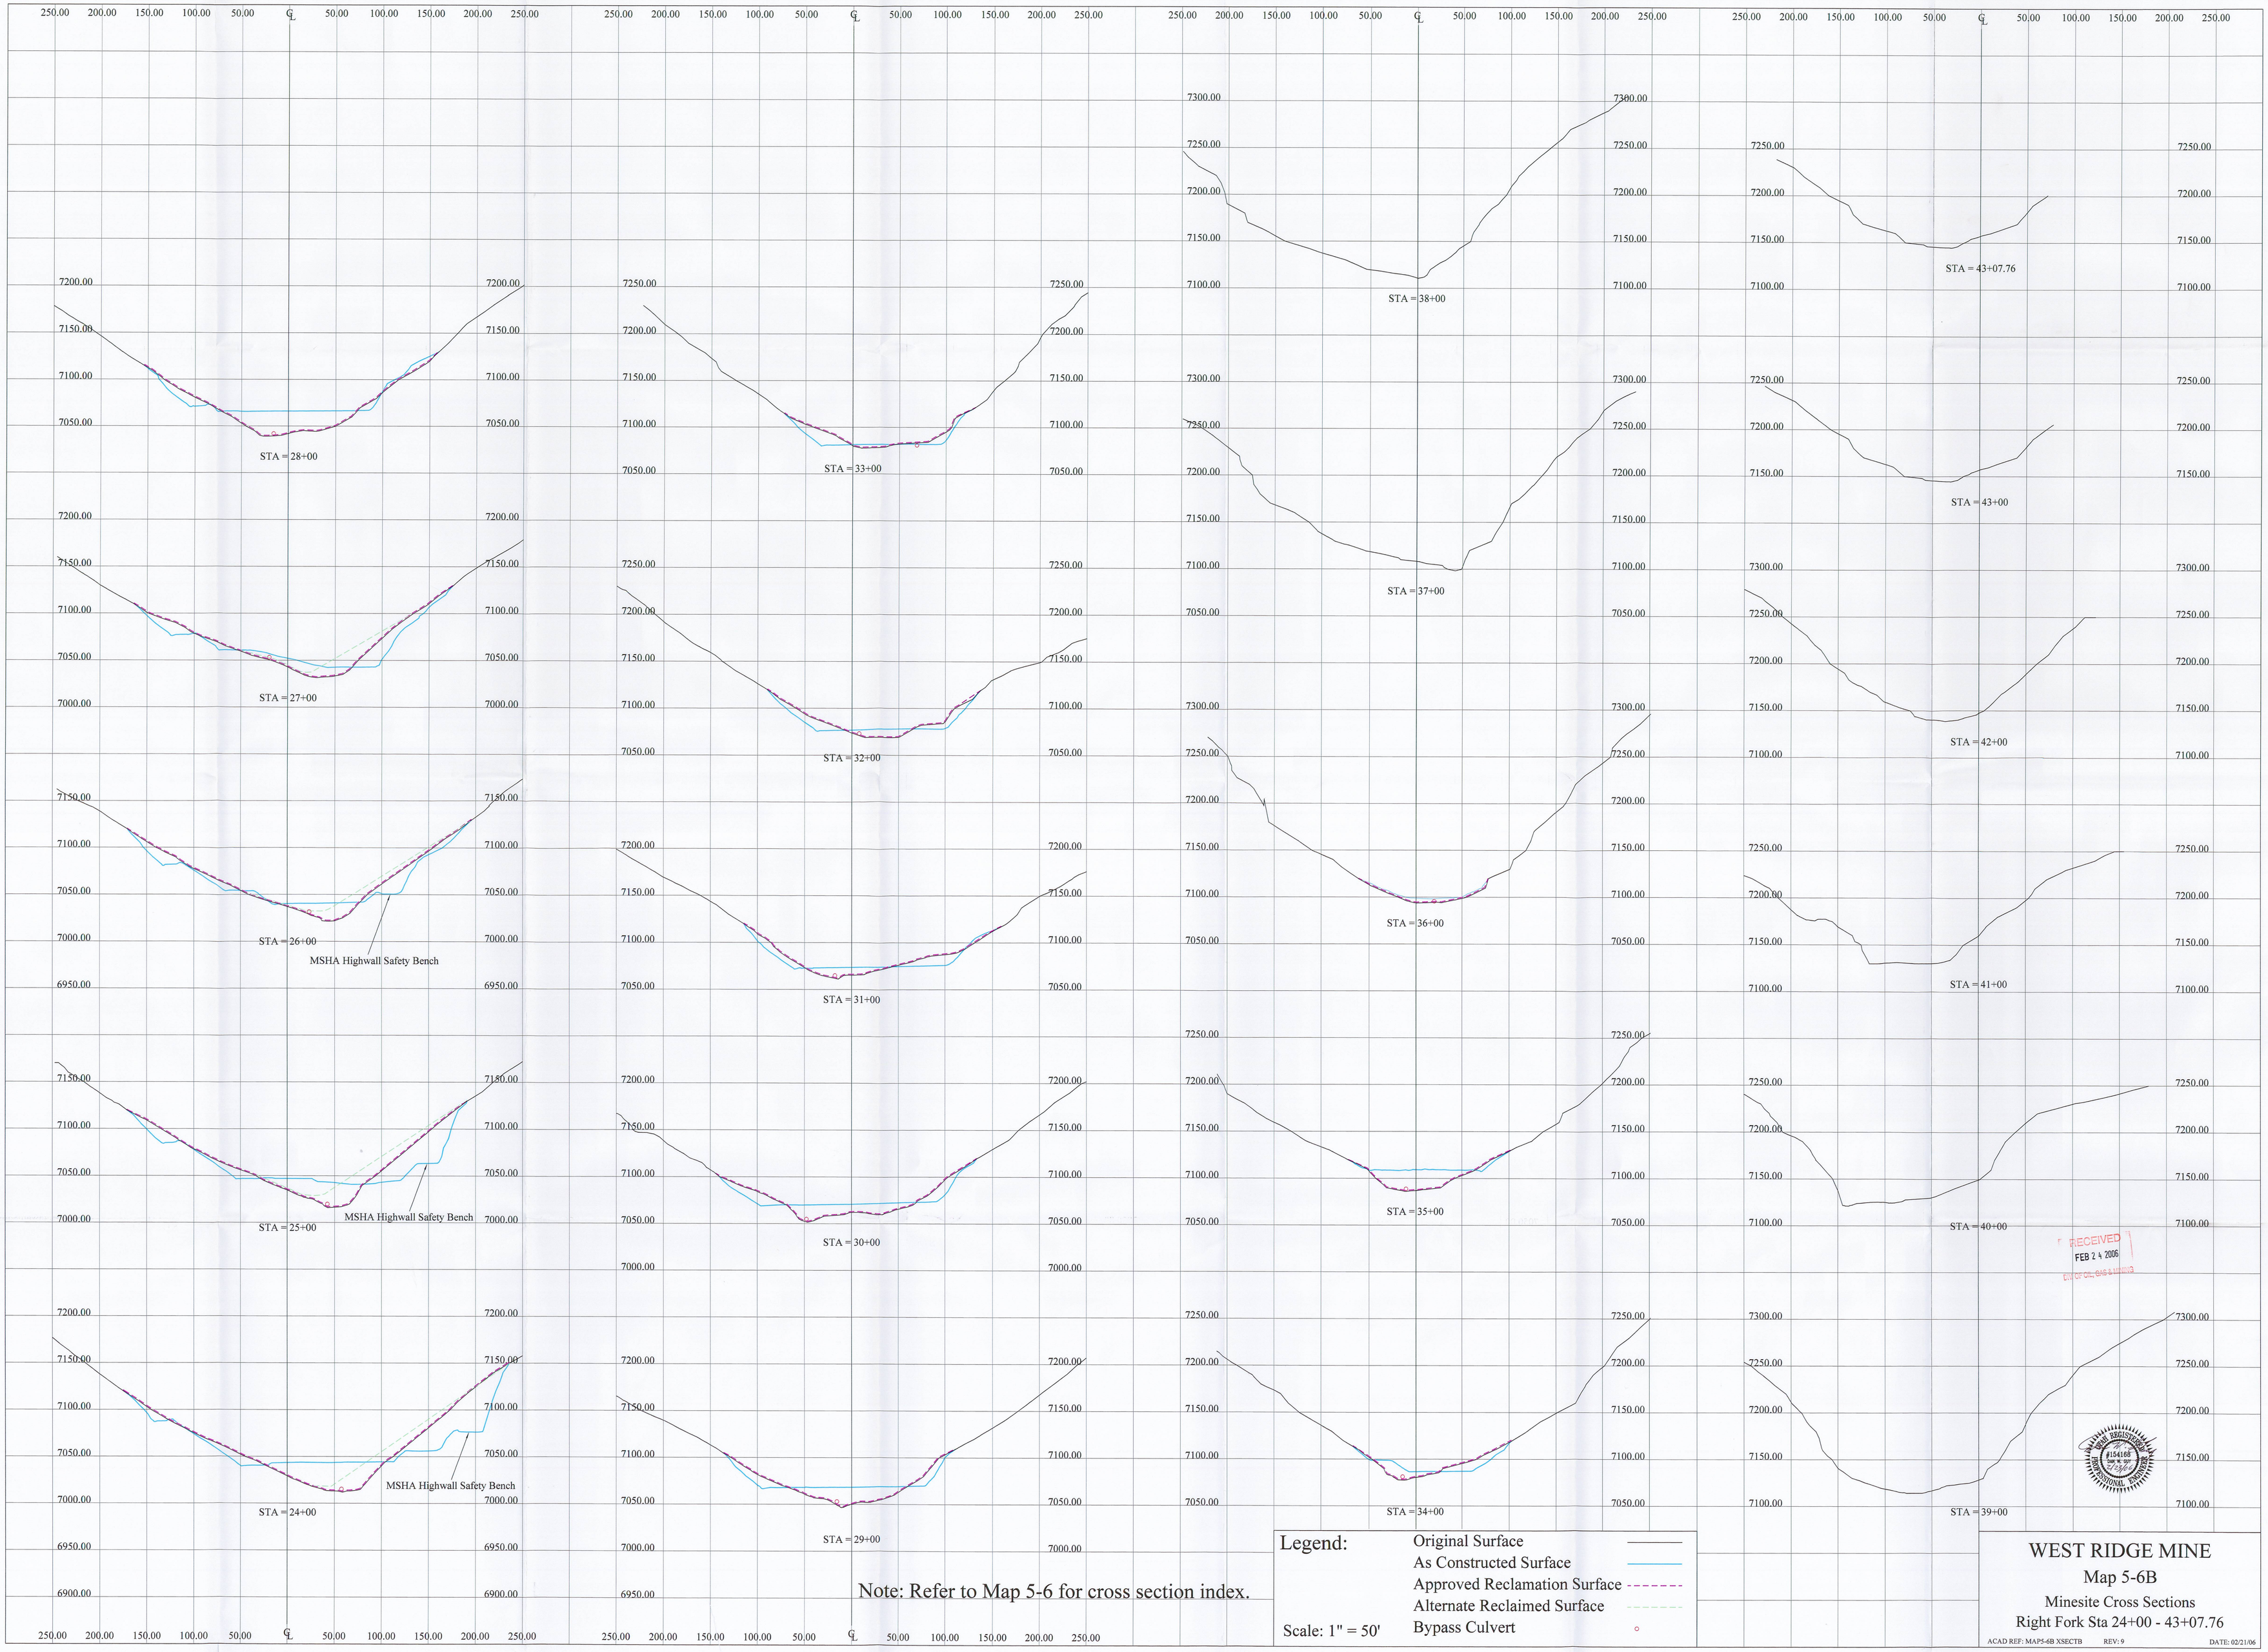
STA = 24+00
STA = 25+00
STA = 26+00
STA = 27+00
STA = 28+00
STA = 29+00
STA = 30+00
STA = 31+00
STA = 32+00
STA = 33+00
STA = 34+00
STA = 35+00
STA = 36+00
STA = 37+00
STA = 38+00
STA = 39+00
STA = 40+00
STA = 41+00
STA = 42+00
STA = 43+00
STA = 43+07.76
MSHA Highwall Safety Bench
MSHA Highwall Safety Bench
Legend:
Original Surface
As Constructed Surface
Approved Reclamation Surface
Alternate Reclaimed Surface
Bypass Culvert
Scale: 1" = 50'
Note: Refer to Map 5-6 for cross section index.
RECEIVED
FEB 24 2006
DIV OF OIL, GAS & MINING
#154168
WEST RIDGE MINE
Map 5-6B
Minesite Cross Sections
Right Fork Sta 24+00 - 43+07.76
ACAD REF: MAP5-6B XSECTB
REV: 9
DATE: 02/21/06