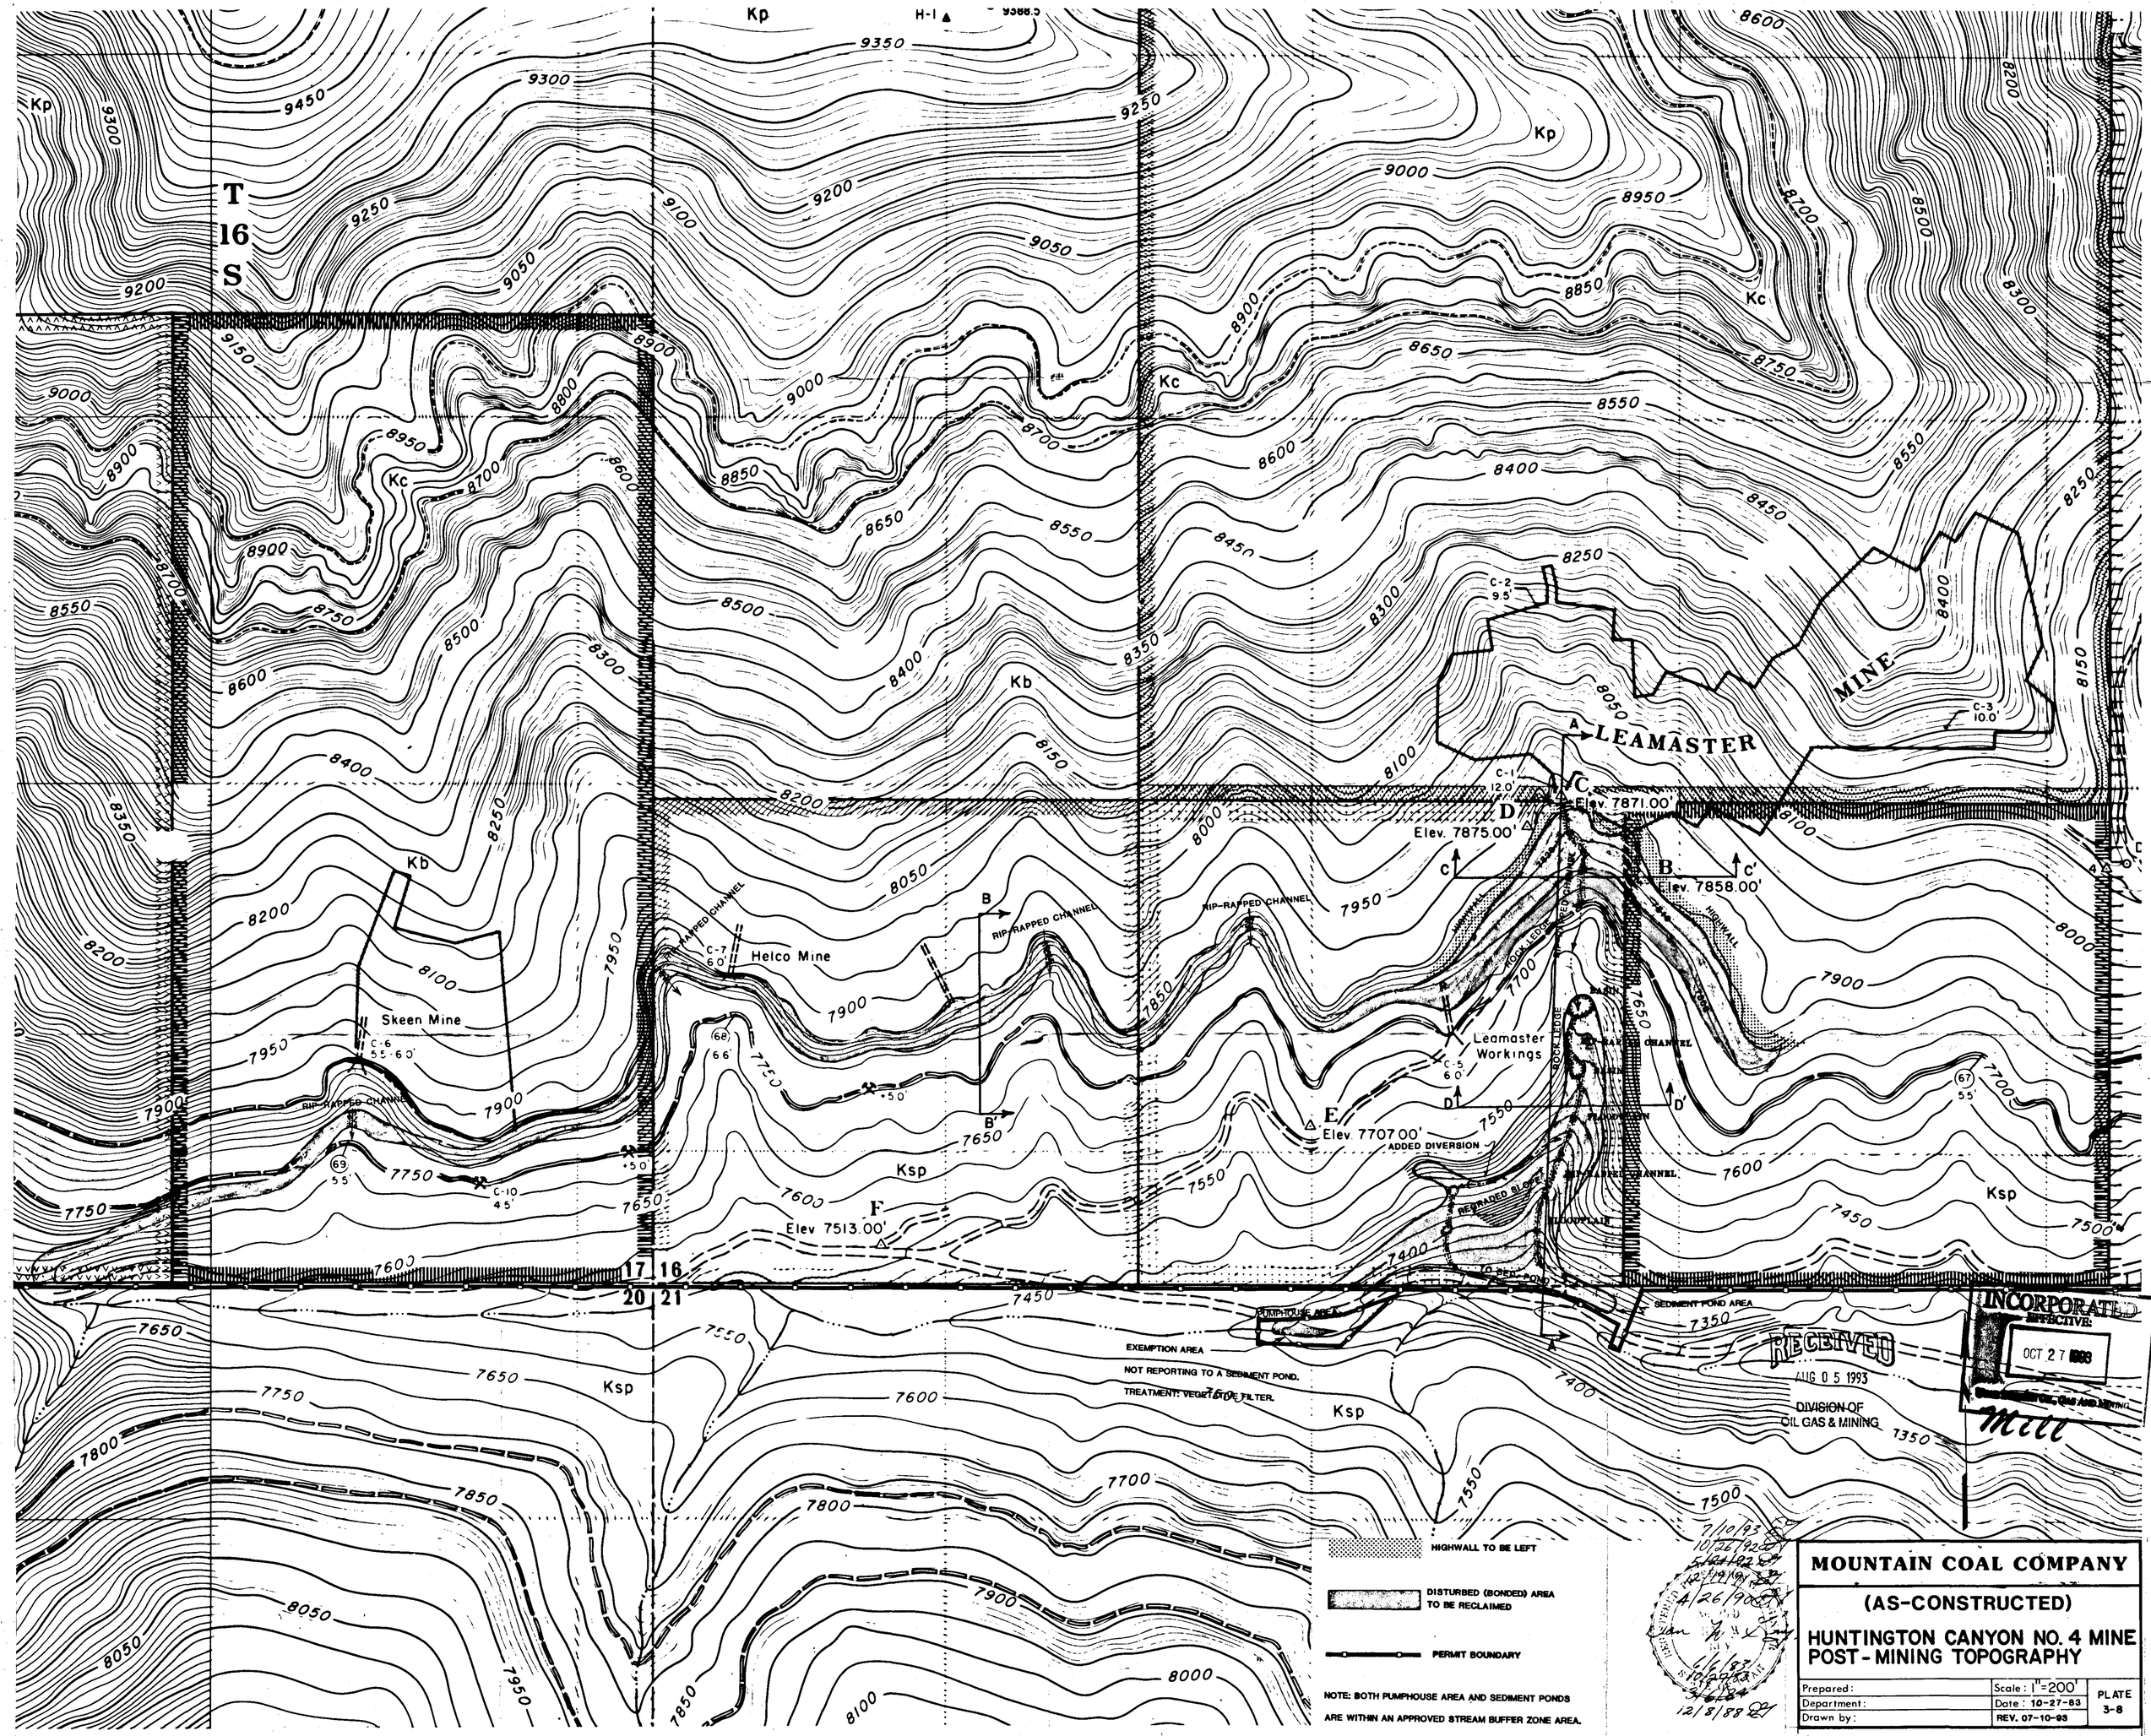

RECEIVED
AUG 05 1993
DIVISION OF OIL GAS & MINING

INCORPORATED
EFFECTIVE:
OCT 27 1993
DIVISION OF OIL, GAS AND MINING

MOUNTAIN COAL COMPANY

(AS-CONSTRUCTED)

HUNTINGTON CANYON NO. 4 MINE
POST-MINING TOPOGRAPHY

Prepared:	Scale: 1"=200'	PLATE 3-8
Department:	Date: 10-27-83	
Drawn by:	REV. 07-10-93	