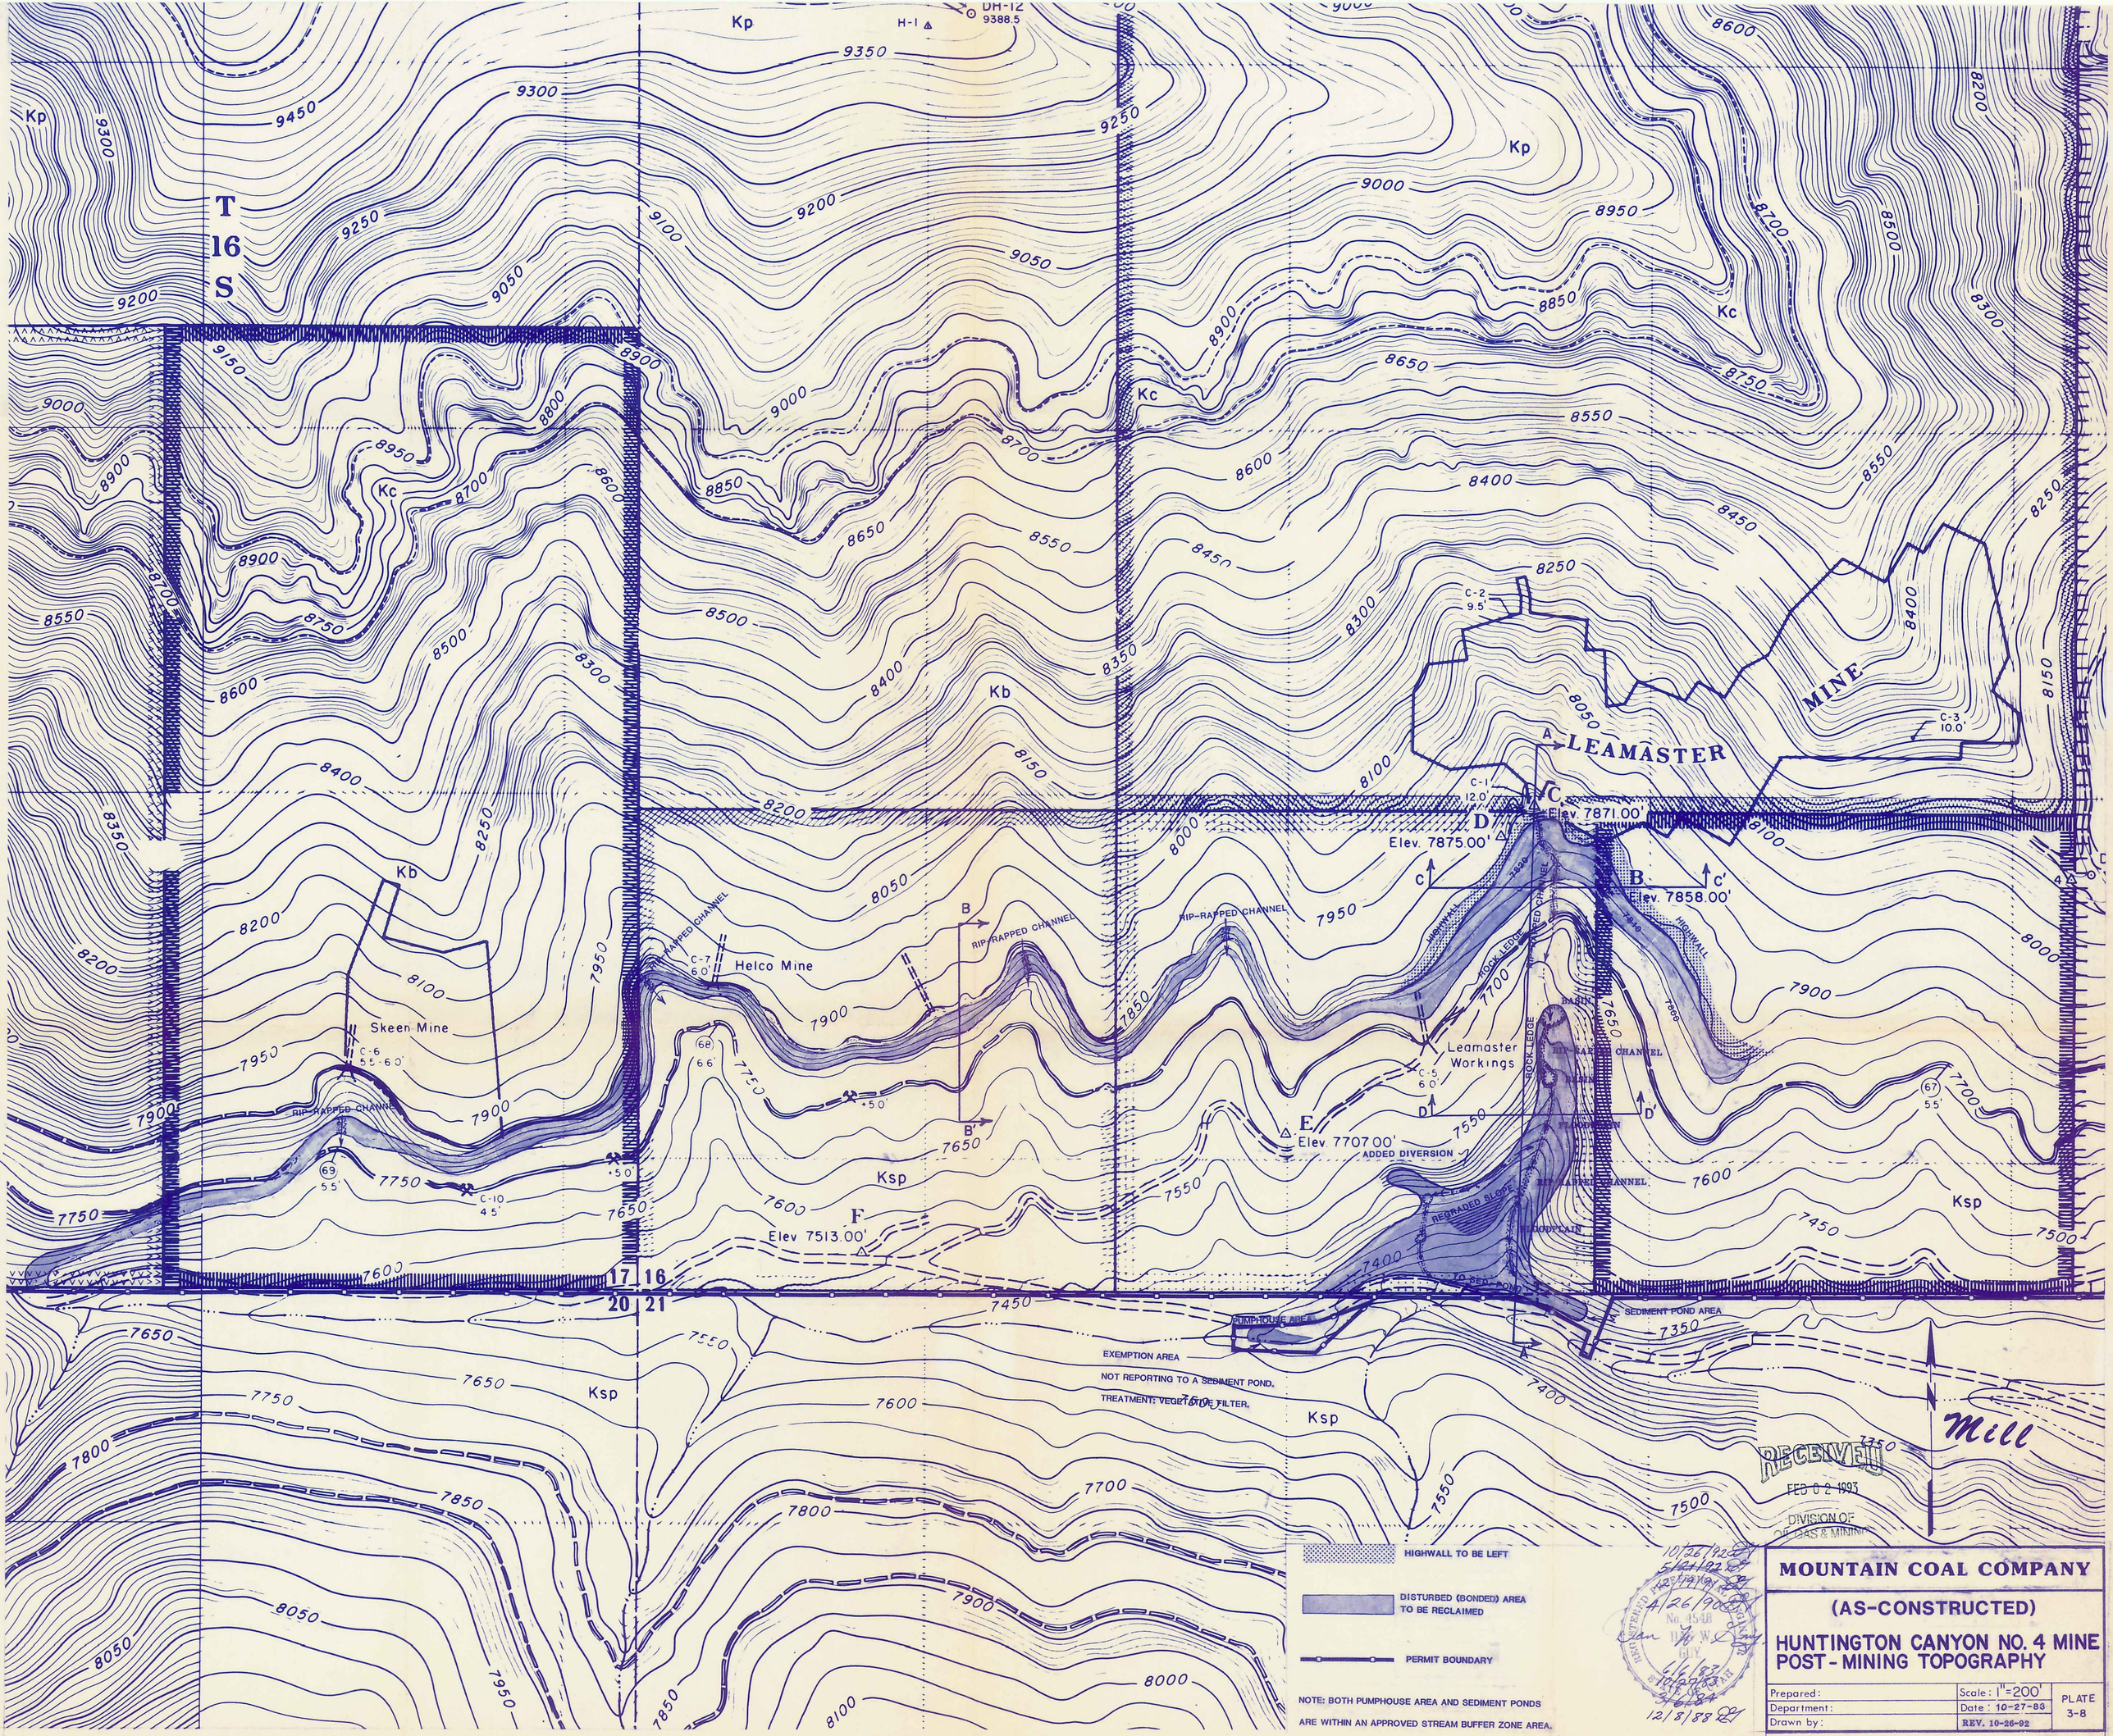
T 16 S
Kp
Kc
Kb
Ksp
DH-12
9388.5
H-1
LEAMASTER MINE
C-1 12.0'
C-2 9.5'
C-3 10.0'
C-5 6.0'
C-6 55-60'
C-7 6.0'
C-10 4.5'
Elev. 7871.00'
Elev. 7875.00'
Elev. 7858.00'
Elev 7707.00'
Elev 7513.00'
Helco Mine
Skeen Mine
Leamaster Workings
RIP-RAPPED CHANNEL
HIGHWALL
ROCK LEDGE
BASIN
ADDED DIVERSION
REGRADED SLOPE
TO SED. POND
PUMPHOUSE AREA
SEDIMENT POND AREA
EXEMPTION AREA
NOT REPORTING TO A SEDIMENT POND.
TREATMENT: VEGETATIVE FILTER.
17 16
20 21
Mill
RECEIVED
FEB 0 2 1993
DIVISION OF
OIL, GAS & MINING
HIGHWALL TO BE LEFT
DISTURBED (BONDED) AREA TO BE RECLAIMED
PERMIT BOUNDARY
NOTE: BOTH PUMPHOUSE AREA AND SEDIMENT PONDS ARE WITHIN AN APPROVED STREAM BUFFER ZONE AREA.
MOUNTAIN COAL COMPANY
(AS-CONSTRUCTED)
HUNTINGTON CANYON NO. 4 MINE
POST-MINING TOPOGRAPHY
Prepared:
Department:
Drawn by:
Scale: 1"=200'
Date: 10-27-83
REV. 10-26-92
PLATE 3-8