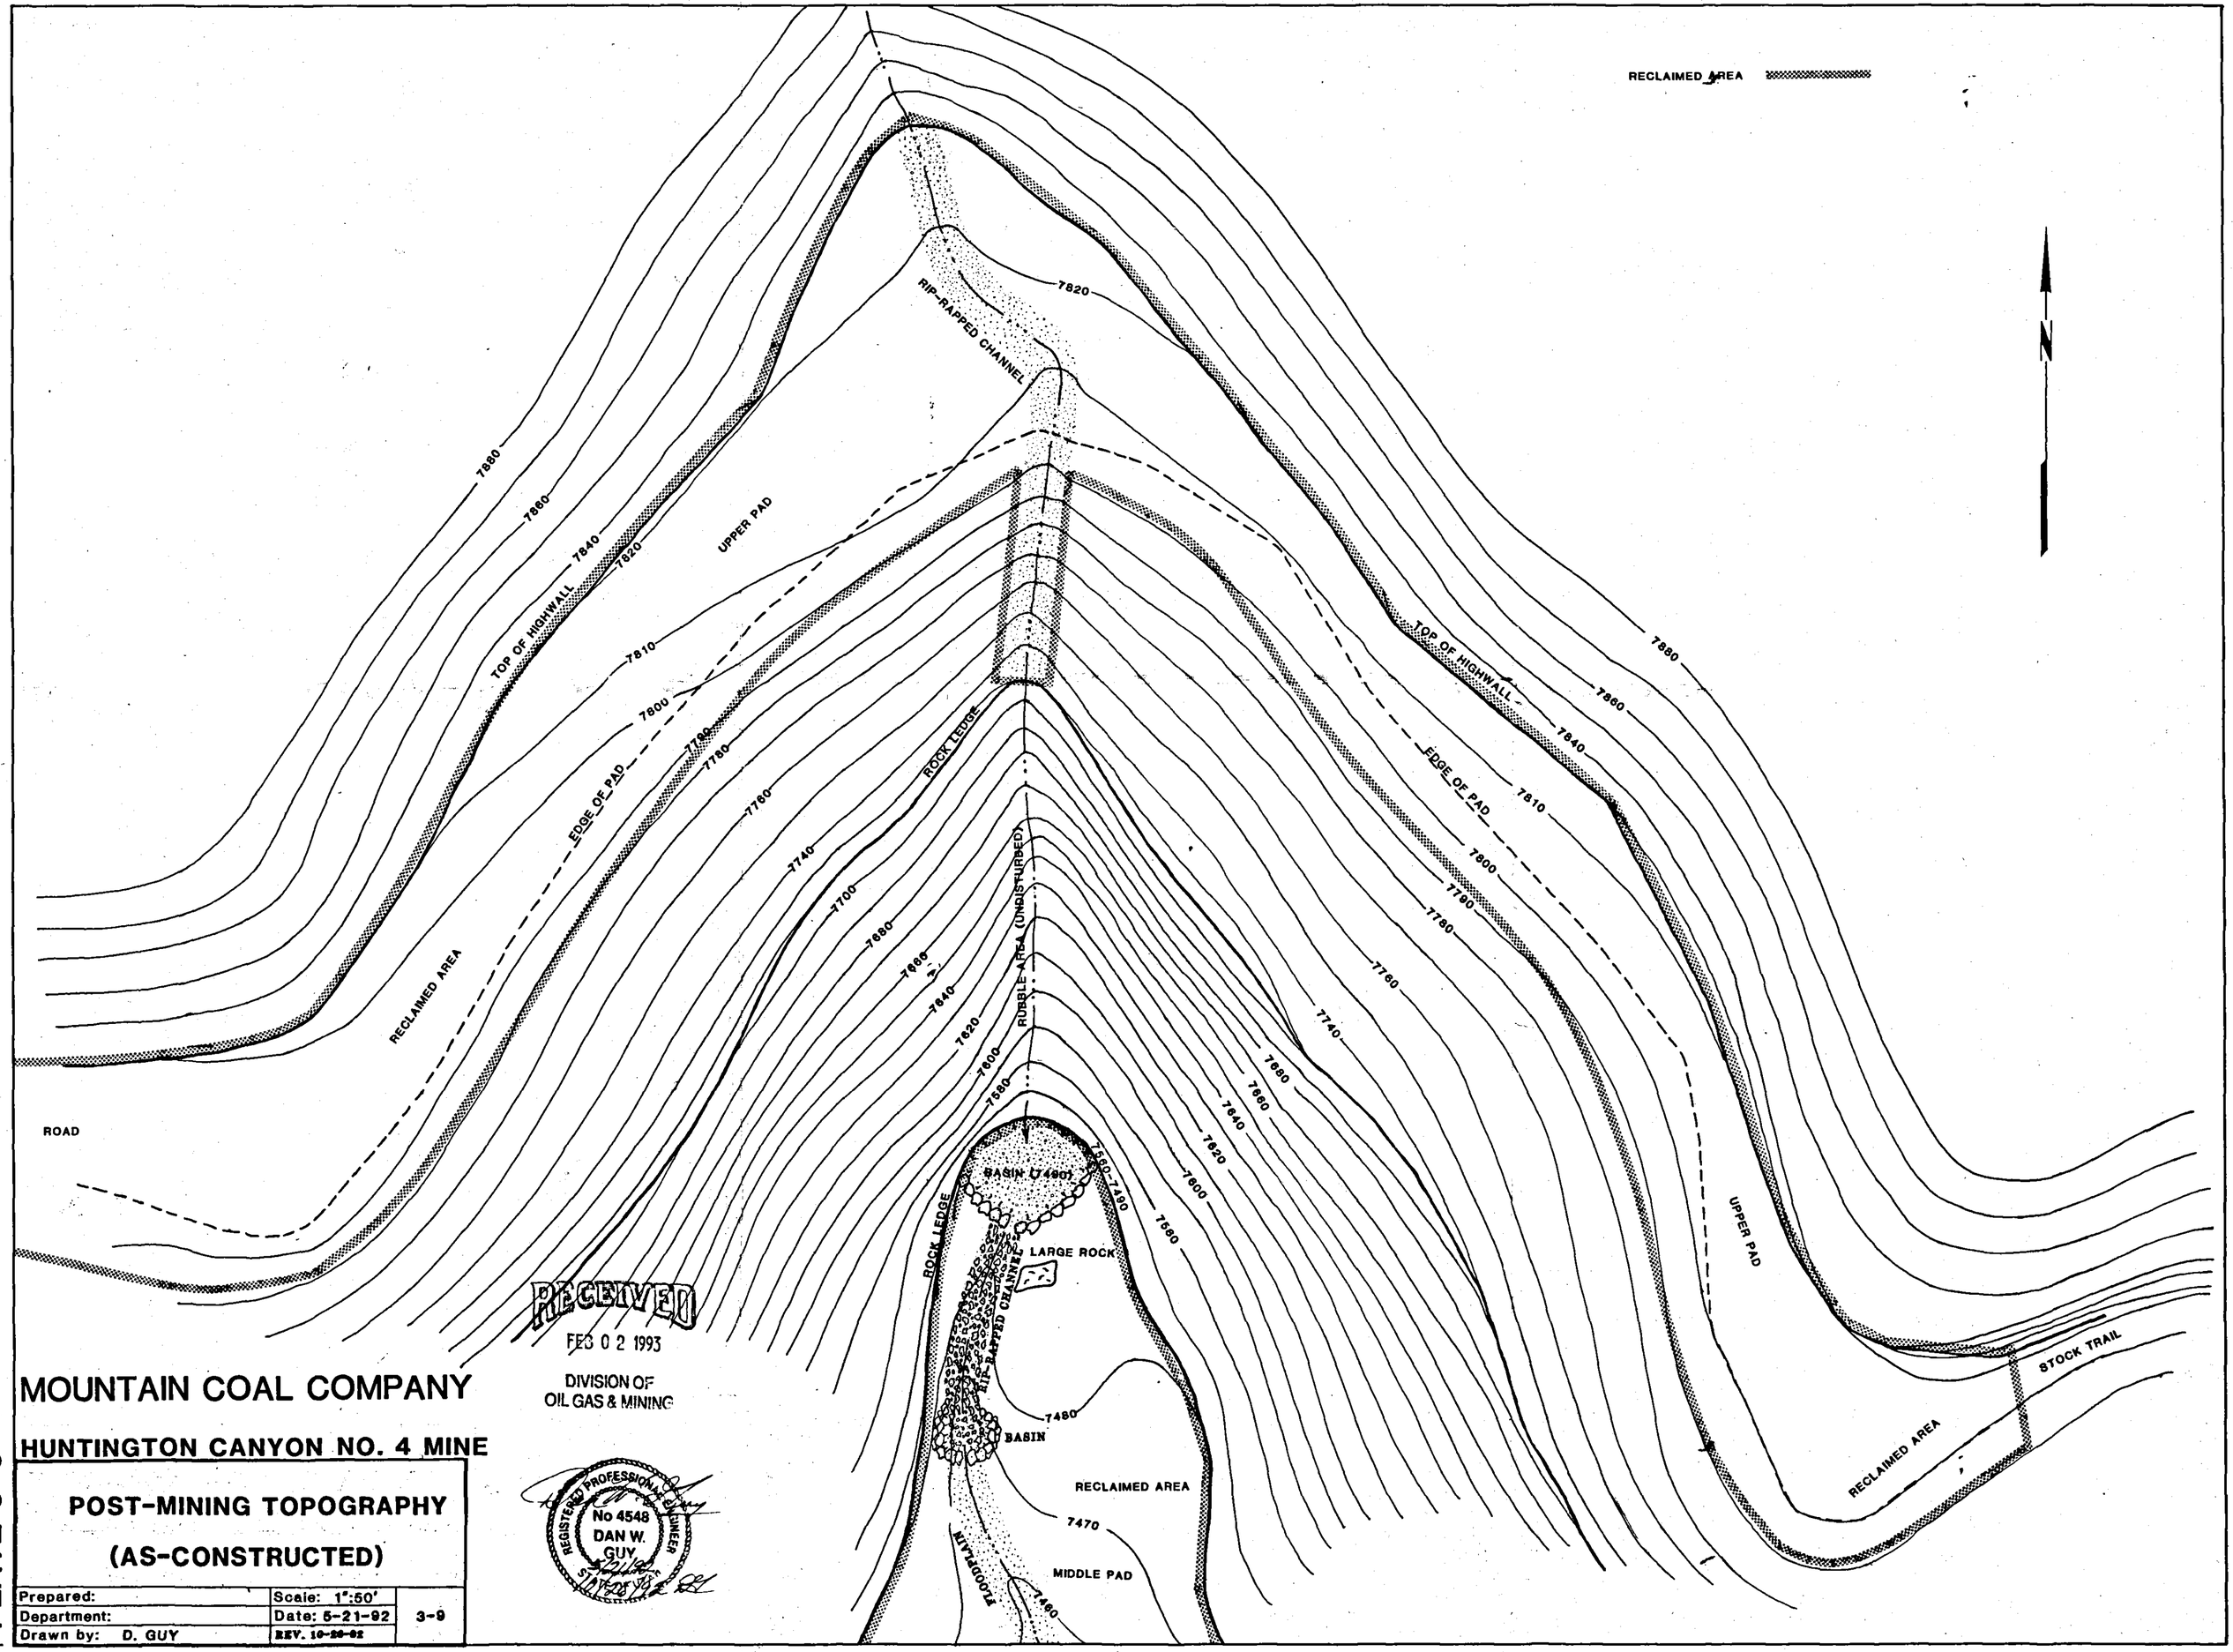

RECEIVED
FEB 0 2 1993
DIVISION OF
OIL GAS & MINING

REGISTERED PROFESSIONAL ENGINEER
No 4548
DAN W.
GUY
STATE OF UTAH

MOUNTAIN COAL COMPANY

HUNTINGTON CANYON NO. 4 MINE

POST-MINING TOPOGRAPHY
(AS-CONSTRUCTED)

Prepared:	Scale: 1":50'	3-9
Department:	Date: 5-21-92	
Drawn by: D. GUY	REV. 10-28-92	

PLATE 3-9