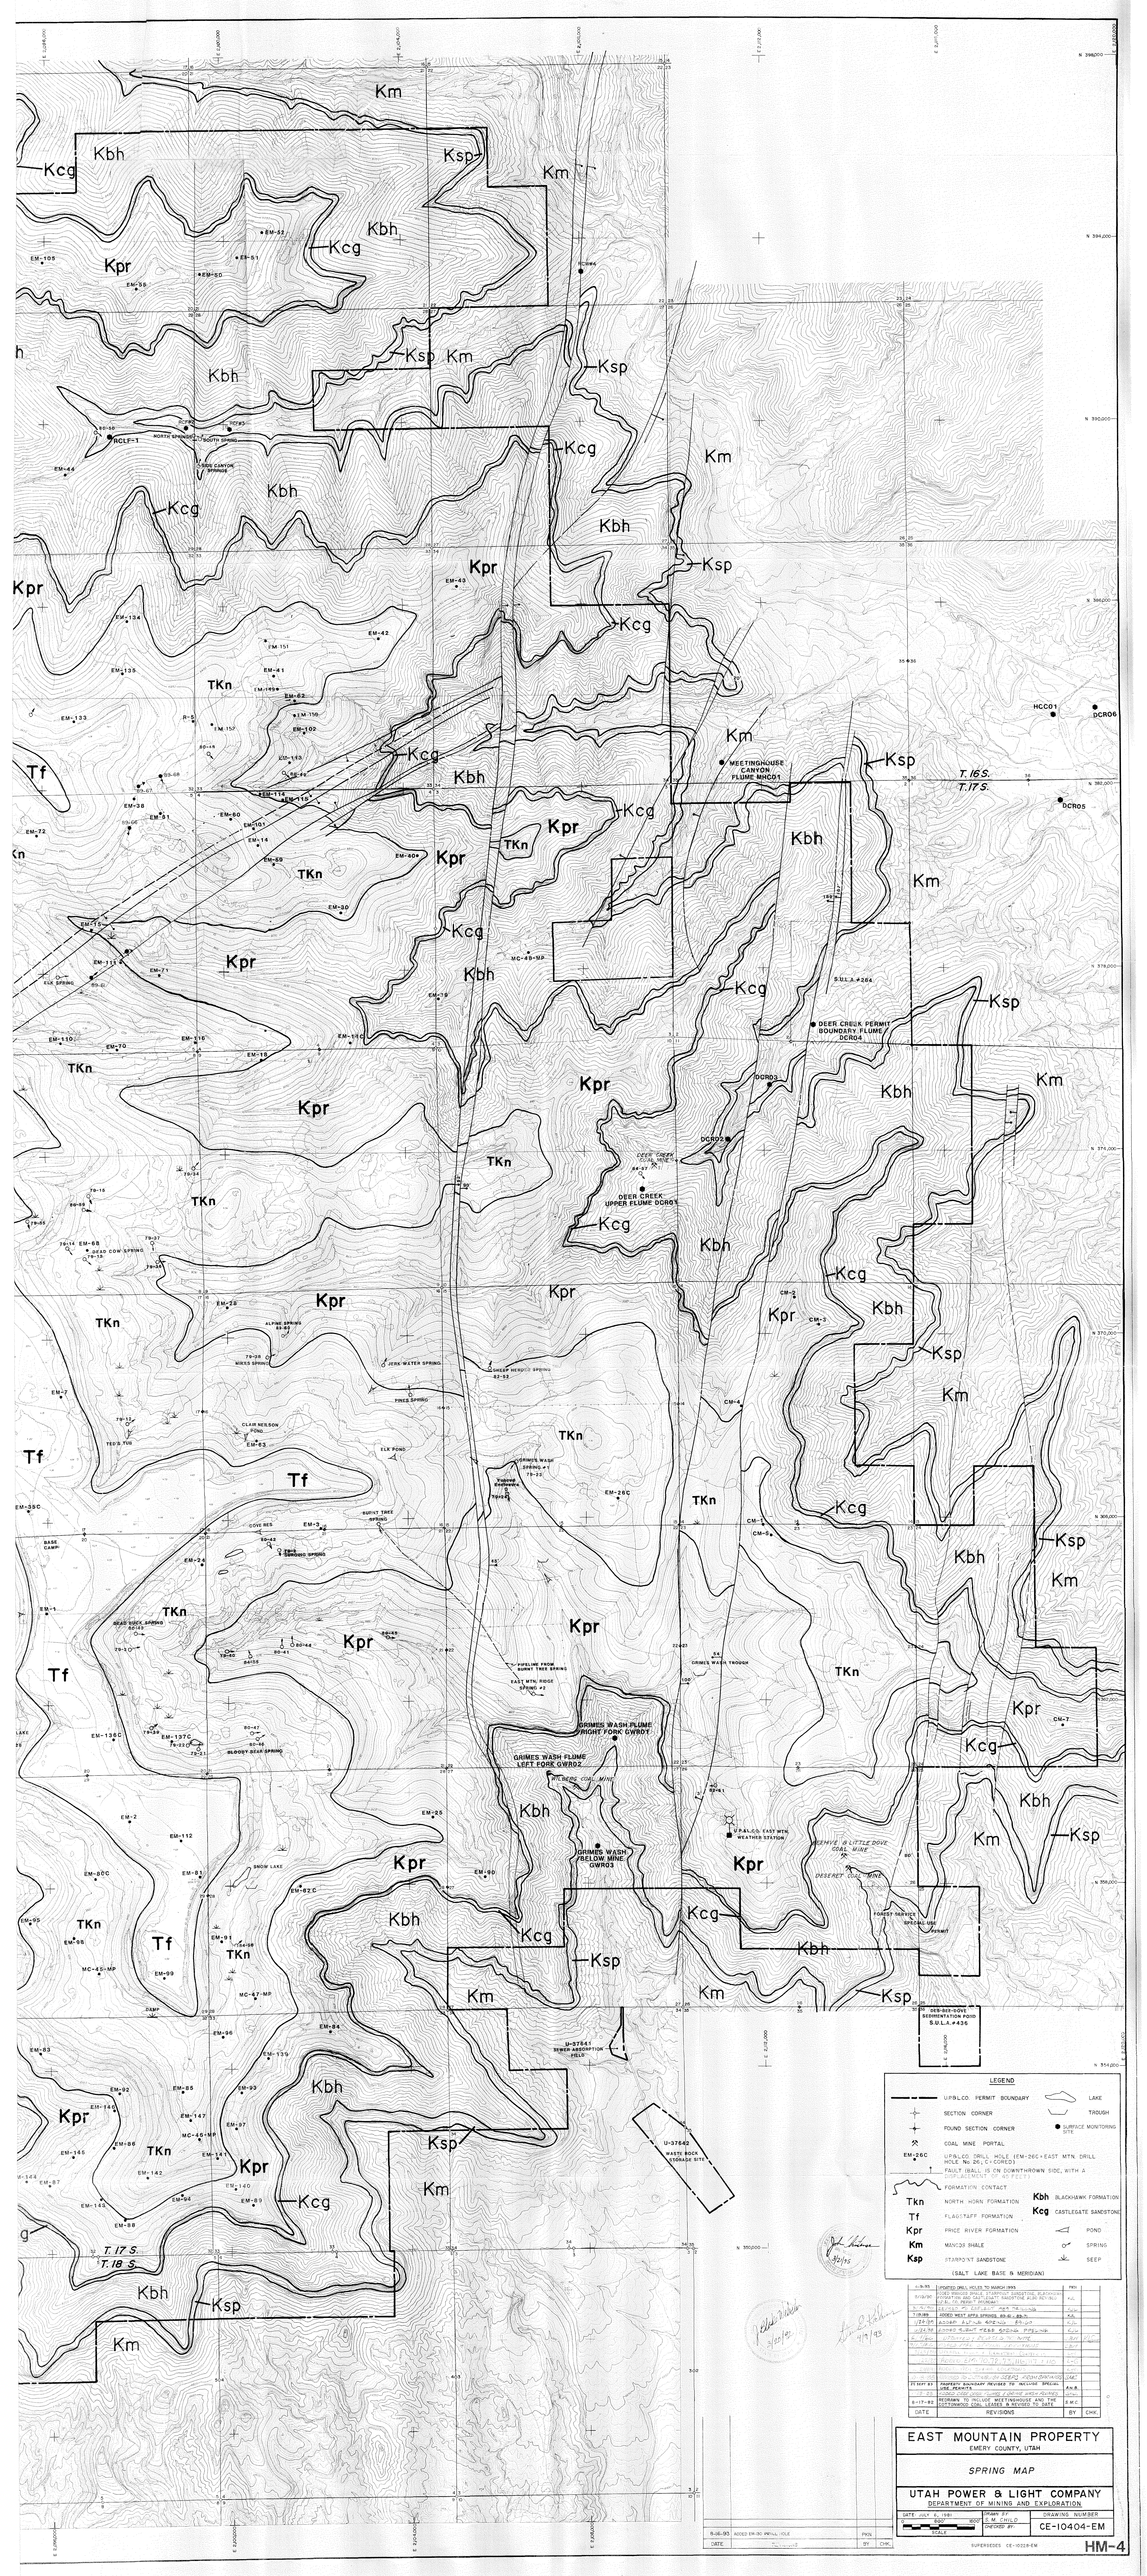
Km
Kbh
Kcg
Ksp
Kpr
TKn
Tf
T. 16 S.
T. 17 S.
T. 17 S.
T. 18 S.
EM-105
EM-55
EM-52
EM-51
EM-50
EM-44
EM-43
EM-134
EM-42
EM-139
EM-41
EM-133
EM-82
EM-102
EM-38
EM-81
EM-72
EM-14
EM-69
EM-40A
EM-30
EM-111
EM-71
EM-110
EM-70
EM-15
EM-26
EM-7
EM-63
EM-35C
EM-3
EM-24
EM-1
EM-135C
EM-137C
EM-2
EM-112
EM-80C
EM-81
EM-92C
EM-92
EM-91
EM-99
EM-83
EM-96
EM-84
EM-139
EM-93
EM-88
EM-147
EM-87
EM-146
EM-86
EM-142
EM-140
EM-94
EM-89
EM-148
EM-28
EM-29
EM-31
EM-32
RCLF-1
NORTH SPRING
SOUTH SPRING
SAGE CANYON SPRING
MEETINGHOUSE CANYON FLUME MHC01
HCC01
DCR06
DCR05
DEER CREEK PERMIT BOUNDARY FLUME DCR04
DCR03
DCR02
DEER CREEK UPPER FLUME DCR01
DEER CREEK LOWER FLUME
SULA #284
GRIMES WASH FLUME RIGHT FORK GWR02
GRIMES WASH FLUME LEFT FORK GWR02
GRIMES WASH FLUME BELOW MINE GWR03
GRIMES WASH TROUGH
PIPELINE FROM BURNT TREE SPRING
EAST MTN. RIDGE SPRING #2
PALCO EAST MTN. WEATHER STATION
SERVICE & LITTLE DOVE COAL MINE
DESERET COAL MINE
FOREST SERVICE SPECIAL USE PERMIT
DER-SUE-GOVE RECREATION POND S.U.L.A.#426
U-37641 SEWER ABSORPTION FIELD
U-37641 WASTE ROCK STORAGE SITE
ALPINE SPRING 80-83
MIKES SPRING
JERK WATER SPRING
CHEESE BOX SPRING 82-53
FIRES SPRING
CLAIR NELSON POND
TED'S TUB
ELK POND
DEAD COW SPRING 79-13
ELK SPRING
SQUIRT TENT SPRING
COVE SPRING
SNOW SPRING
ROCK SPRING 80-43
BLOODY BEAR SPRING
SNOW LAKE
BASE CAMP
DAMP
LAKE
TROUGH
SECTION CORNER
FOUND SECTION CORNER
COAL MINE PORTAL
SURFACE MONITORING SITE
UP&LCO DRILL HOLE (EM-26C=EAST MTN. DRILL HOLE No.26, C=CORED)
FAULT (BALL IS ON DOWNTHROWN SIDE, WITH A FORMATION NAME)
FORMATION CONTACT
Kbh BLACKHAWK FORMATION
Kcg CASTLEGATE SANDSTONE
Tkn NORTH HORN FORMATION
Tf FLAGSTAFF FORMATION
Kpr PRICE RIVER FORMATION
Km MANCOS SHALE
Ksp STARPOINT SANDSTONE
POND
SEEP
SPRING
(SALT LAKE BASE & MERIDIAN)
LEGEND
UPDATED DRILL HOLES TO MARCH 1995
REVISED LEASE AREA, STARPOINT SANDSTONE, ELEVATION AND CULTURAL ADDITIONS PER REV. AERIAL PHOTOGRAPHY
REVISED AS-BUILT PIPELINE
ADDED WEST MTN SPRING, 89-91, 89-1.
REVISED AS-BUILT AND ADDED ROAD
ADDED BURNT TREE SPRING PIPELINE
UPDATED PERMIT AREA TO MINE
REVISED SPRING LOCATIONS
ADDED SPRINGS 89-1 THRU 89-5
REVISED TO REFLECT AS-BUILT PIPELINE
PROPERTY BOUNDARY REVISED TO INCLUDE SPECIAL USE PERMITS
REVISED TO REFLECT MEETINGHOUSE AND THE DER-SUE-GOVE COAL LEASES & REVISED TO DATE
DATE
REVISIONS
BY
CHK
EAST MOUNTAIN PROPERTY
EMERY COUNTY, UTAH
SPRING MAP
UTAH POWER & LIGHT COMPANY
DEPARTMENT OF MINING AND EXPLORATION
DATE: JULY 6, 1981
SCALE: 1" = 2000'
DRAWN BY: S.M.D.
CHECKED BY:
DRAWING NUMBER
CE-10404-EM
SUPERSEDES CE-10018-EM
HM-4