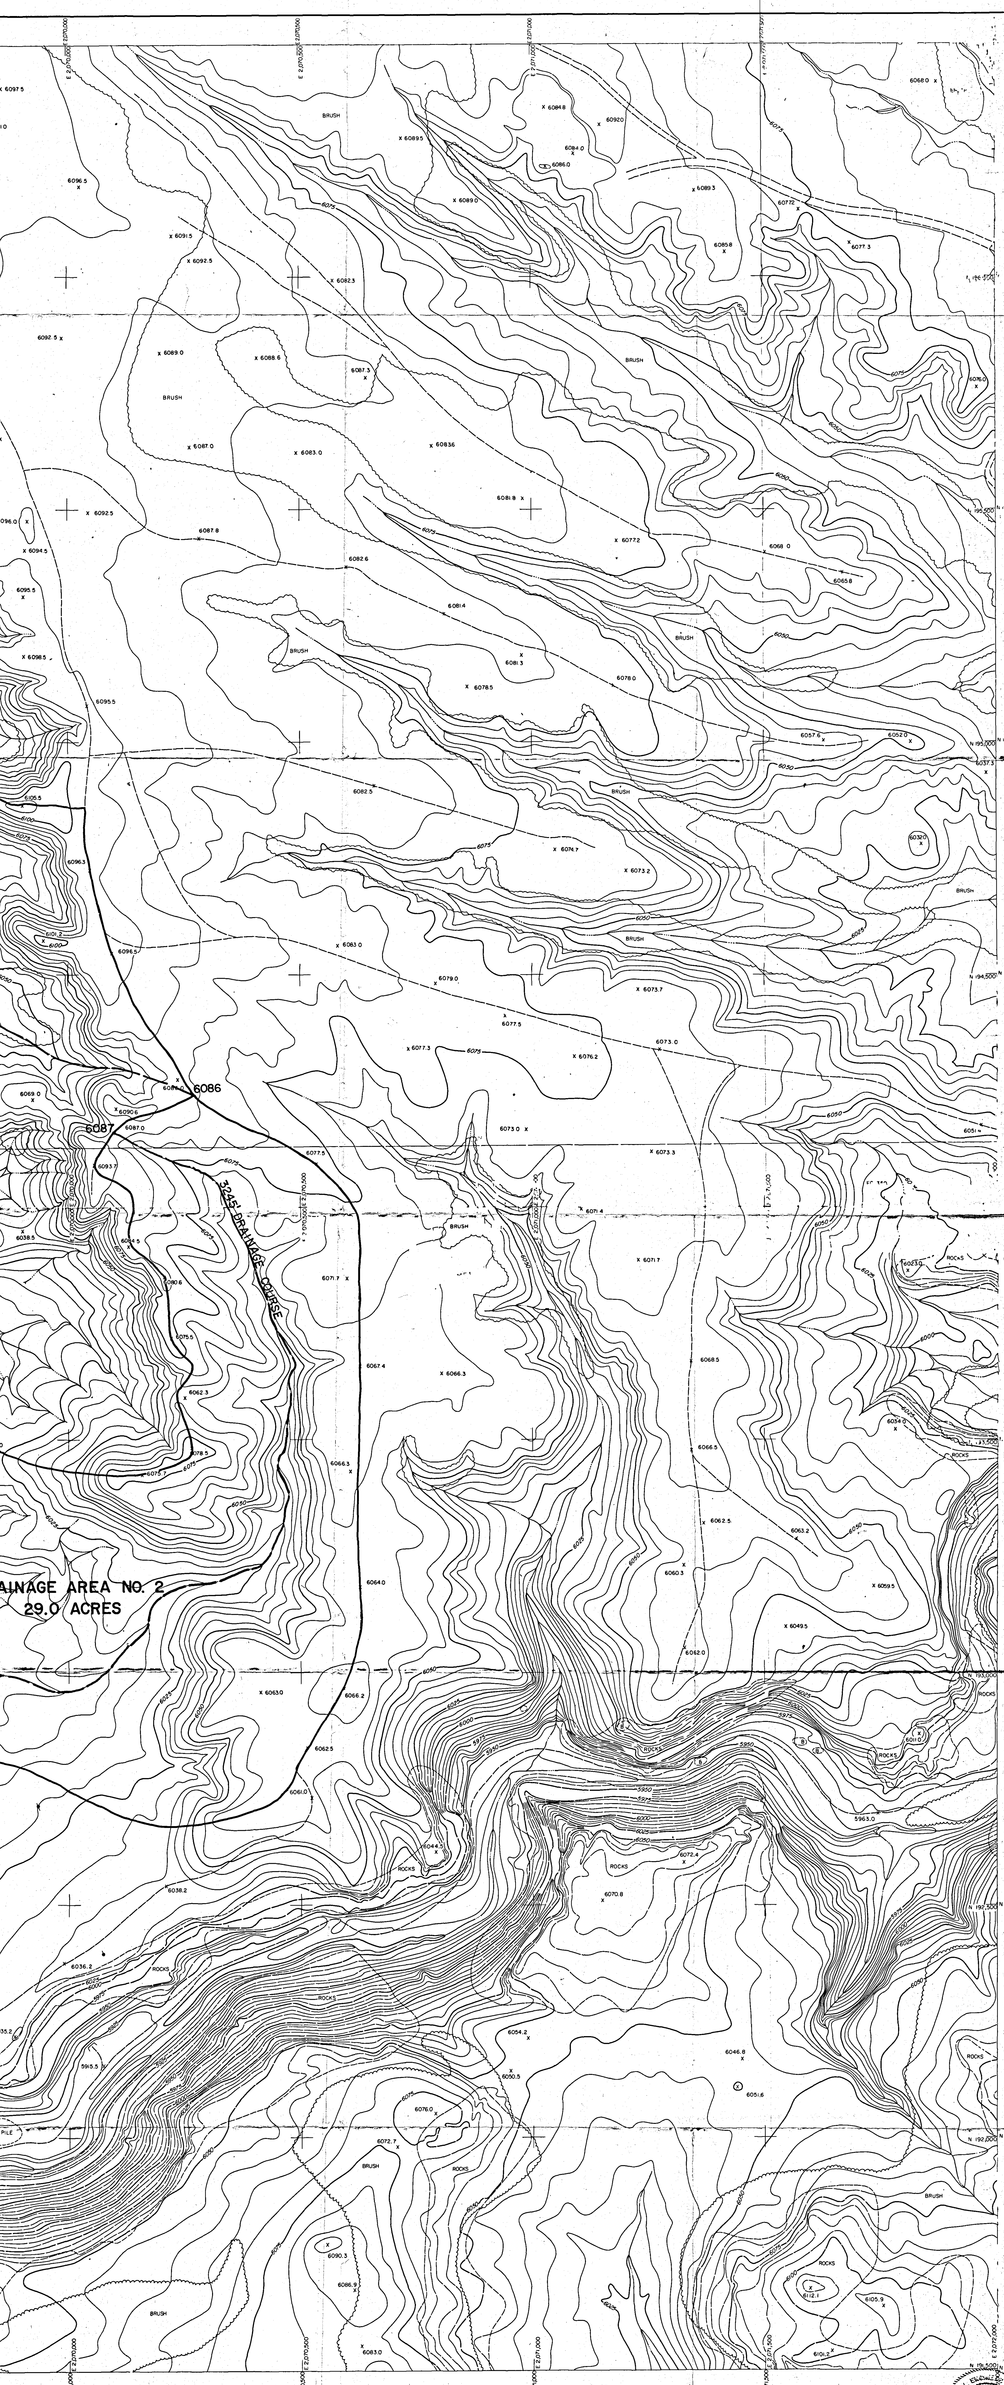

TREES AND BRUSH
DAM
CULVERTS
UTILITY POLES
CONTOURS
DEPRESSION CONTOURS
SPOT ELEVATION
SECTION CORNERS
SECTION LINE
CONTROL POINT
DRILL HOLE

RECEIVED
MAY 2 1988
DIVISION OF
OIL, GAS & MINING

NO.	DATE	BY	REVISIONS

CONSOLIDATION COAL COMPANY
MIDCONTINENT REGION
12755 OLIVE BLVD, ST. LOUIS, MO. 63141

AS-BUILT CERTIFICATION OF DOWN DRAIN INLET STRUCTURES SEDIMENTATION POND 05

MINE	EMERY	DATE	4-22-88
CHKD	D.B.R.	SCALE	1" = 100'
APPD	J.J.H.	DRAWING NO.	PLATE 15-9A
DRAWN	A.B.B.	SHEET OF	REV.