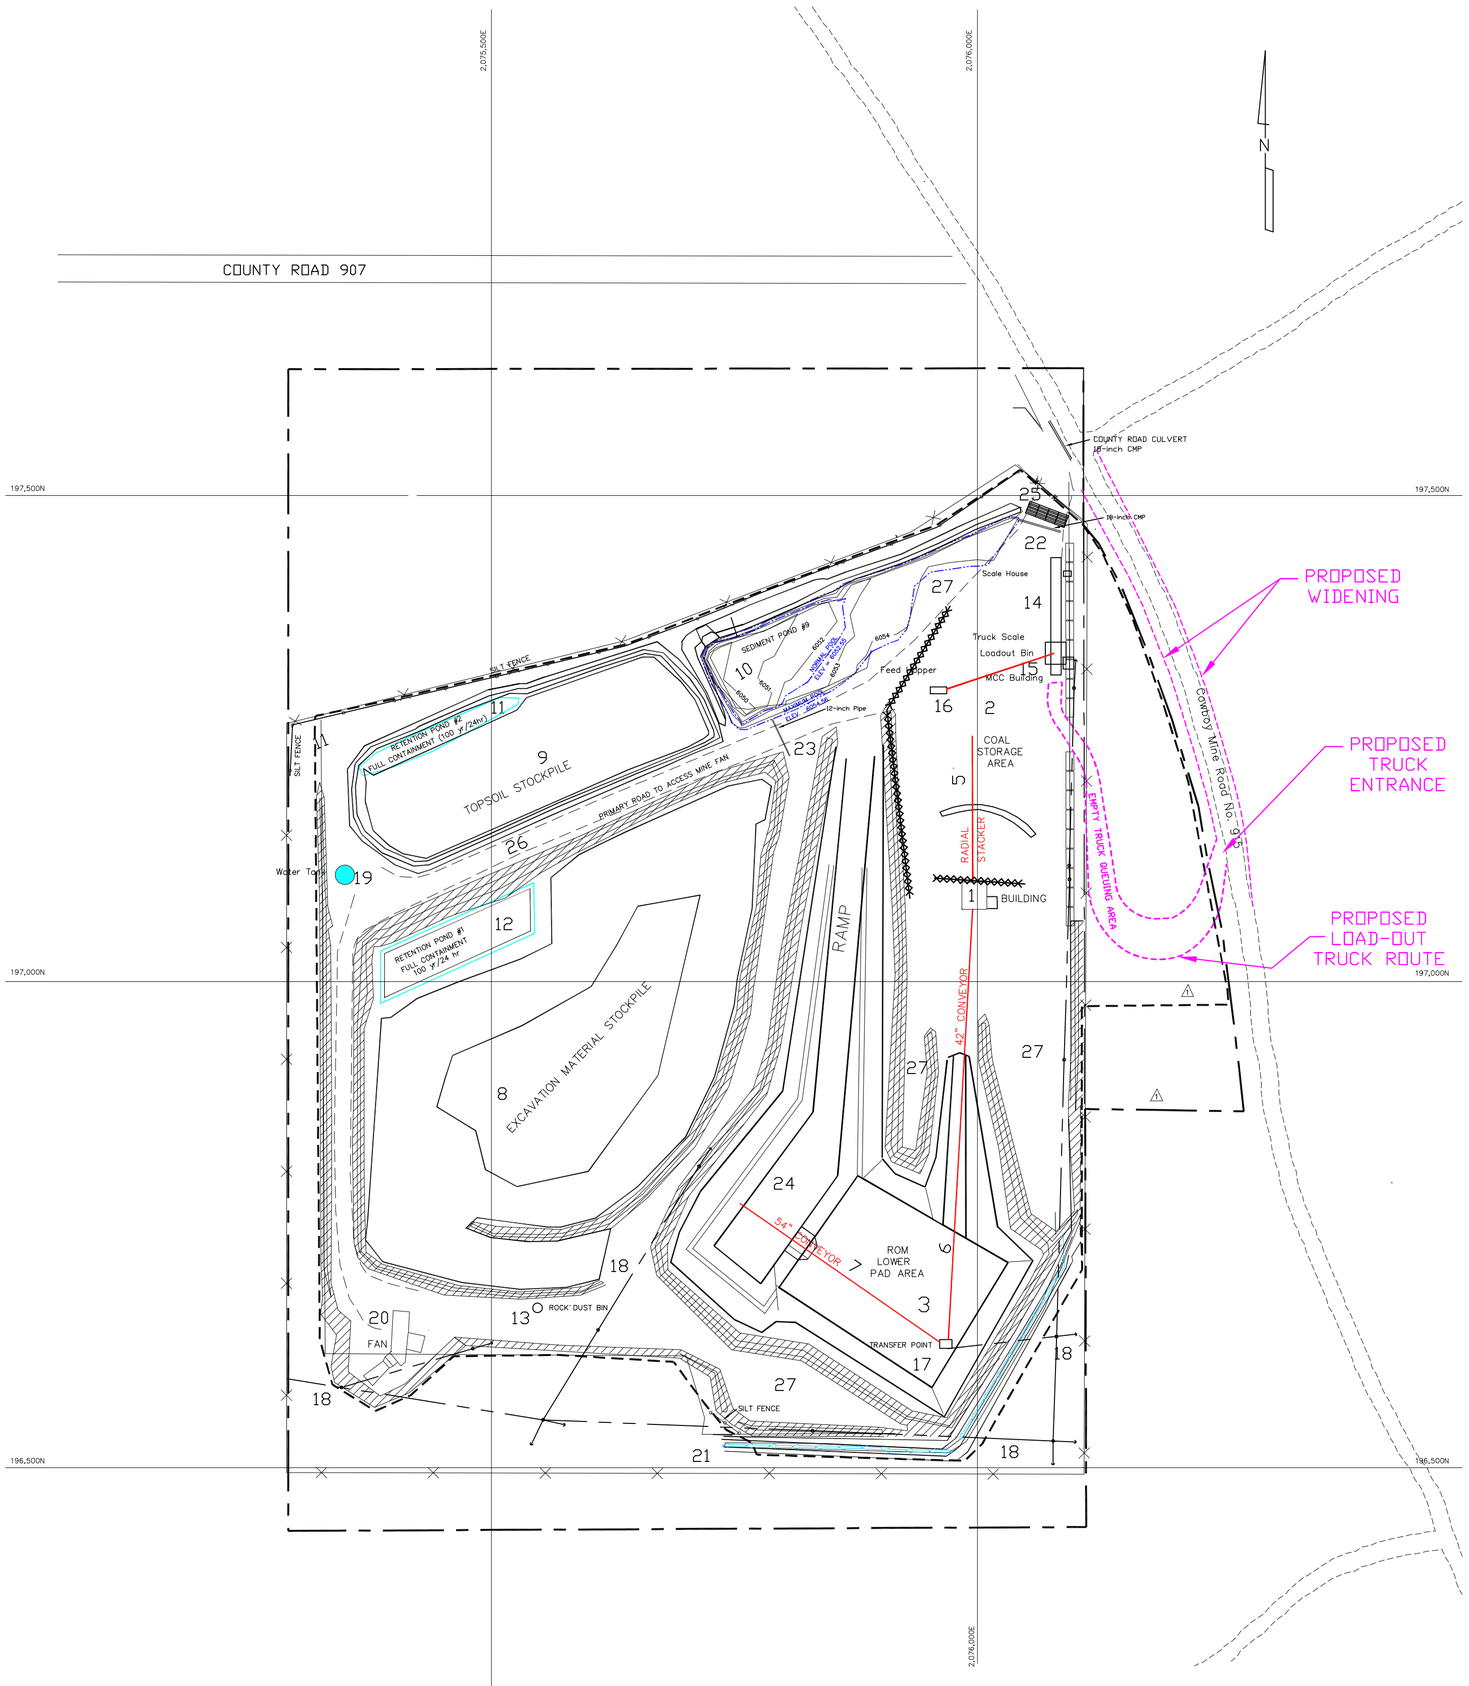

1 CRUSHER/SCREEN BUILDING
2 10,000 TON COAL STOCKPILE
3 2,600 TON COAL STOCKPILE
4
5 42-inch STACKER CONVEYOR
6 42-inch CONVEYOR
7 54-inch CONVEYOR
8 EXCAVATION MATERIAL STOCKPILE
9 TOPSOIL STOCKPILE
10 SEDIMENT BASIN #9
11 RETENTION BASIN #2
12 RETENTION BASIN #1
13 ROCK DUST BIN
14 TRUCK SCALE
15 TRUCK LOADOUT
16 COAL FEED HOPPER
17 BELTLINE TRANSFER POINT
18 POWERLINE
19 WATER TANK
20 AIRSHAFT (16' Dia.)
21 TEMPORARY STREAM DIVERSION
22 CORRUGATED METAL PIPE (18-inch diam.)
23 CORRUGATED METAL PIPE (12-inch diam.)
24 3- ENTRY PORTALS
25 CATTLE GUARD
26 PRIMARY ACCESS ROAD TO FAN
27 SUPPLY YARD

PERMIT BOUNDARY
STREAM DIVERSION (UNAFFECTED DRAINAGE)
BERM
DISTURBANCE AREA (SURFACE AFFECTED)
FENCE
SILT FENCE
STRAW/HAY BALES
WIND FENCE

SCALE: 1" = 100'
100 0 100 200 300

PLAN VIEW

REV.	DATE	COMMENTS
1	8/03	ADD 1.5 AC. OF PERMIT AREA OF WHICH 1.0 AC. IS SURFACE DISTURBED AMEND 4th EAST PORTAL CONFIGURATION & STRUCTURES WITH AS-BUILT DRAWING

CONSOLIDATION COAL COMPANY
SESSER ENGINEERING
P.O. BOX 566, SESSER, IL 62884

4 EAST PORTAL SURFACE FACILITIES

MINE EMERY MINE	DATE 10-16-02	REV. 9-04-03
CHKD. TDK	SCALE AS NOTED	
APPD.	DRAWING NO.	FILE
DRAWN TDK SHEET 1 OF 1	PLATE II-3	II-3 4thEastFacilities.dwg