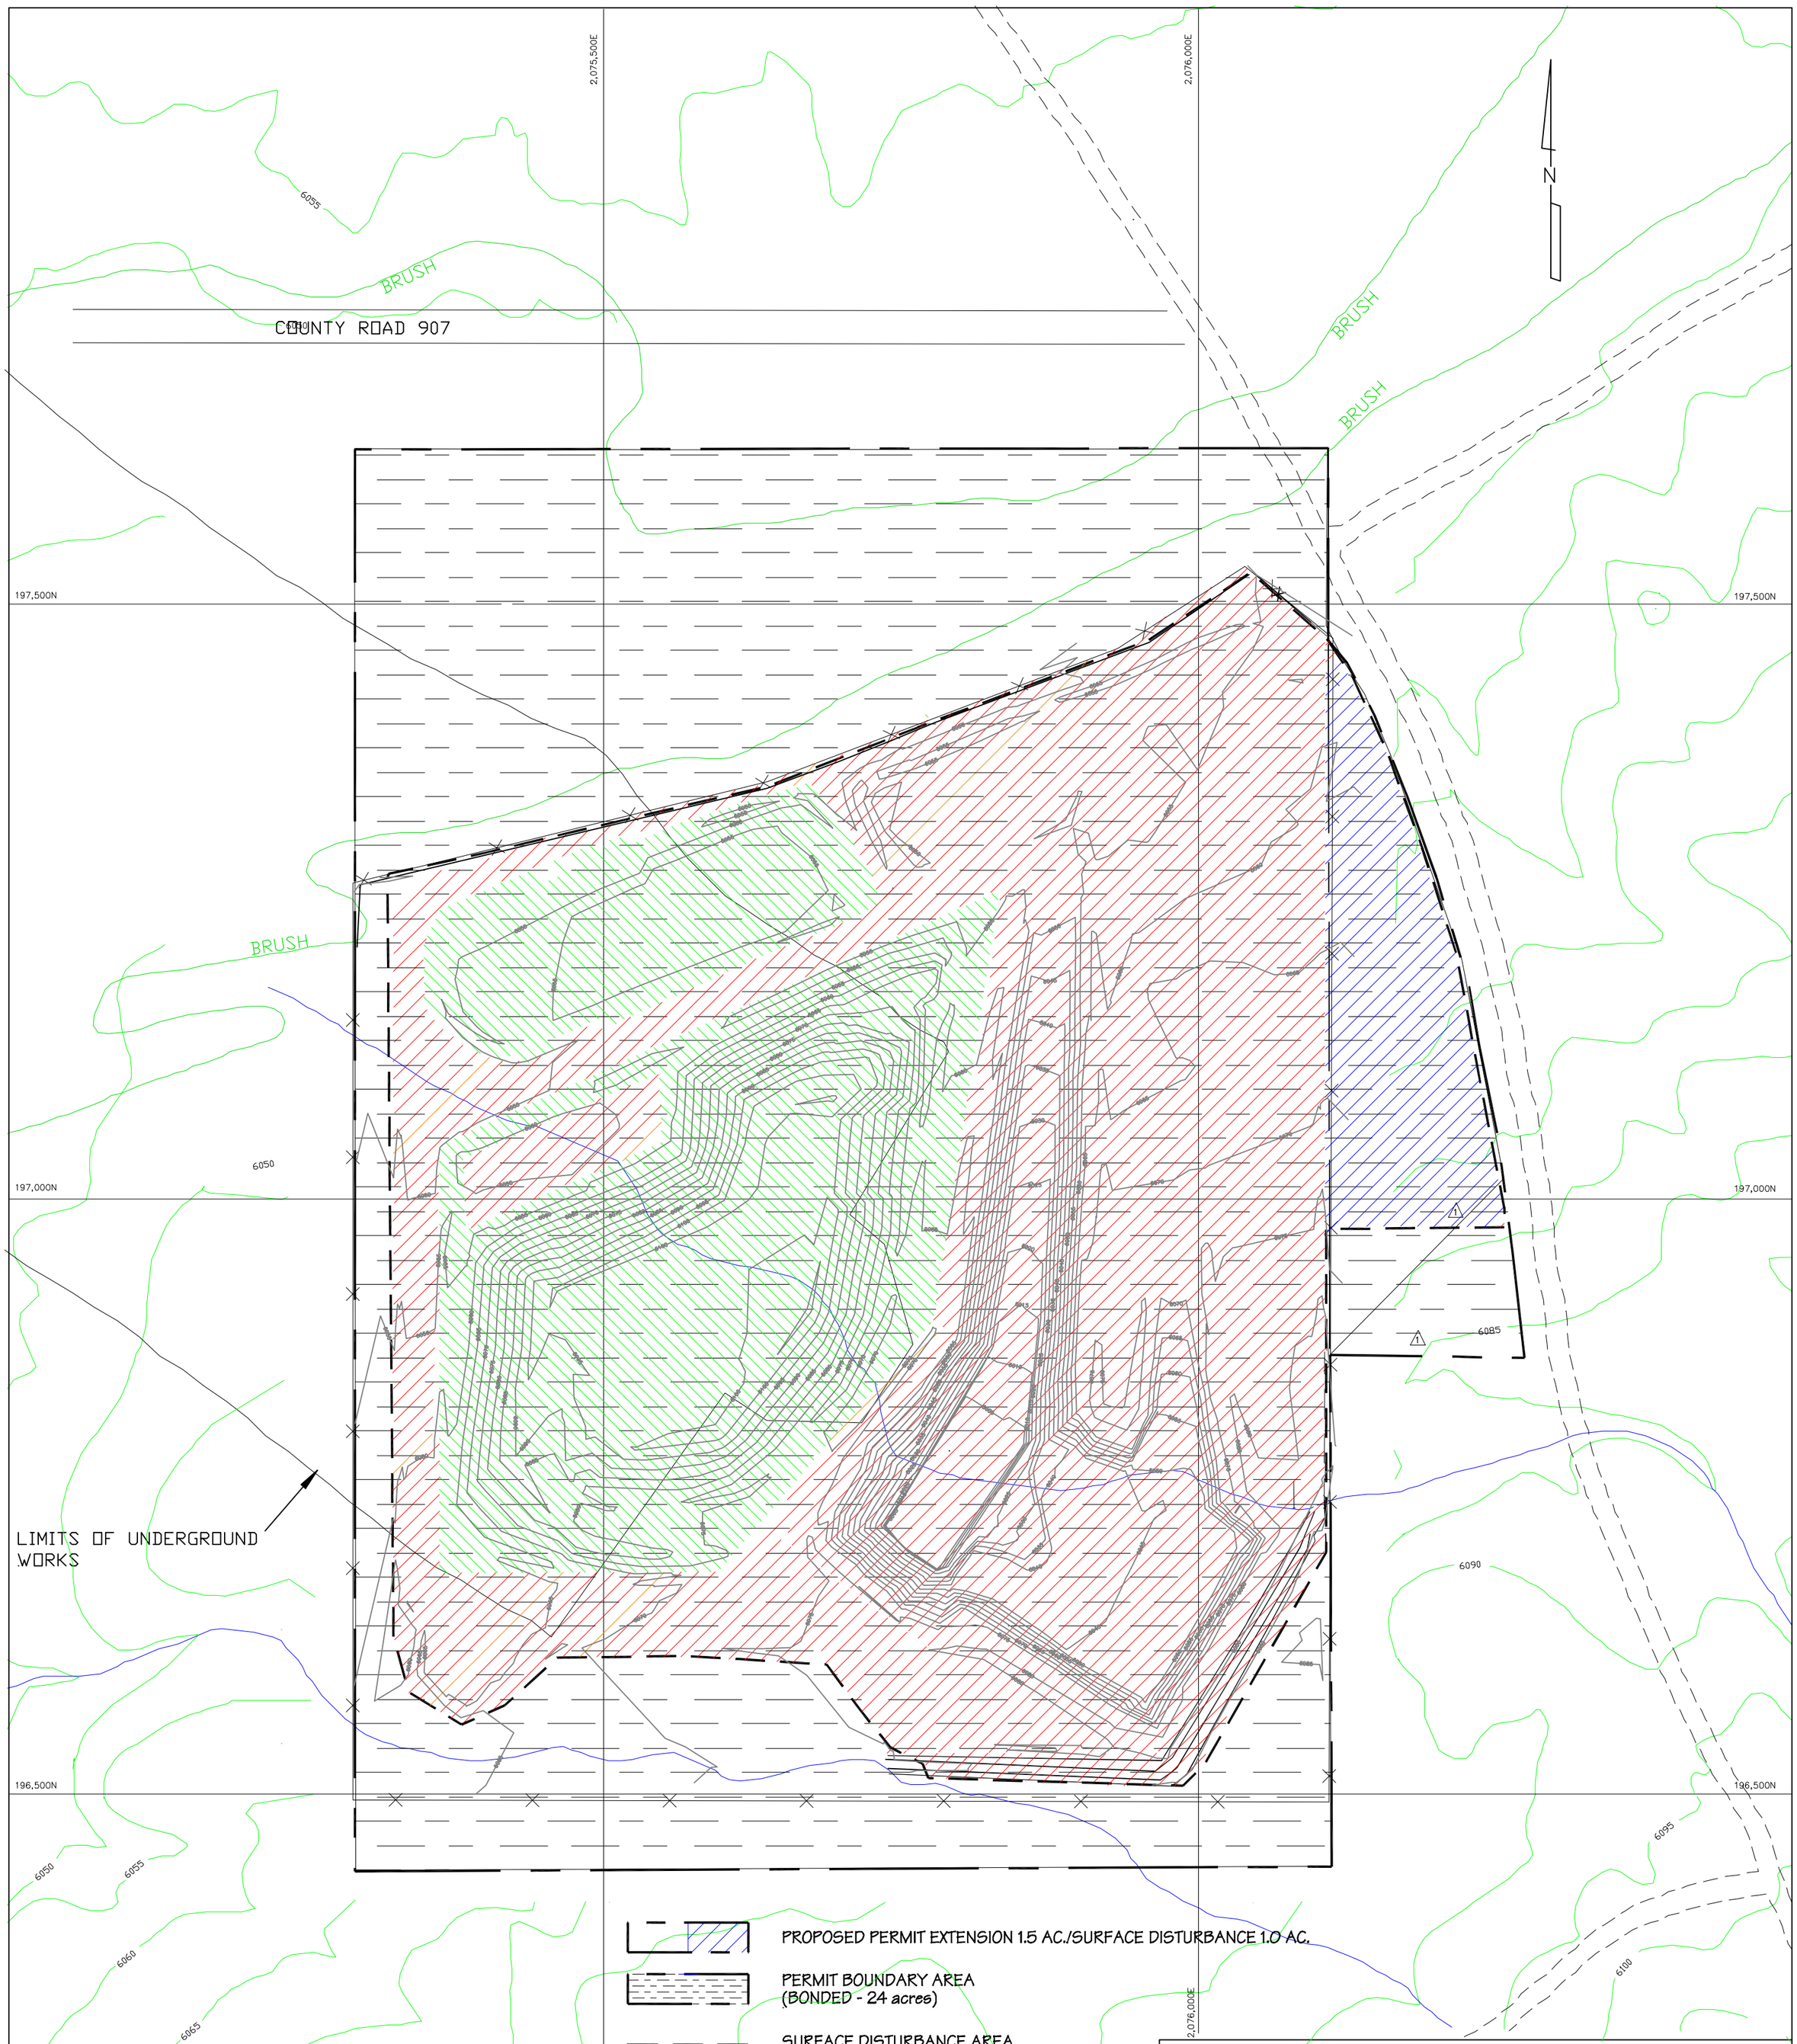


PROPOSED PERMIT EXTENSION 1.5 AC./SURFACE DISTURBANCE 1.0 AC.

PERMIT BOUNDARY AREA (BONDED - 24 acres)

SURFACE DISTURBANCE AREA (AFFECTED VEGETATION 16 ac.)

FENCE

AREAS OF TOPSOIL REMOVAL (10 ac.)

AREAS OF TOPSOIL STORED IN-PLACE (5.0 ac.)

CONTOUR INTERVAL 5 ft

SCALE: 1" = 100'

100 0 100 200 300

| REV. | DATE | COMMENTS |
|---|---|---|
| 1 | 8/03 | ADD 1.5 AC. OF PERMIT AREA OF WHICH 1.0 AC. IS SURFACE DISTURBED<br>AMEND 4th EAST PORTAL CONFIGURATION & STRUCTURES WITH AS-BUILT DRAWING |

**CONSOLIDATION COAL COMPANY**
SESSER ENGINEERING
P.O. BOX 566, SESSER, IL 62884

# 4 EAST PORTAL DISTURBANCE AREA

| | | |
|---|---|---|
| MINE EMERY MINE | DATE 10-16-02 REV. 08-26-03 | |
| CHKD. TDK | SCALE AS NOTED | |
| APPD. | DRAWING NO. | FILE |
| DRAWN TDK SHEET 1 OF 1 | PLATE III-1 | III-1 4thEastDisturbance |