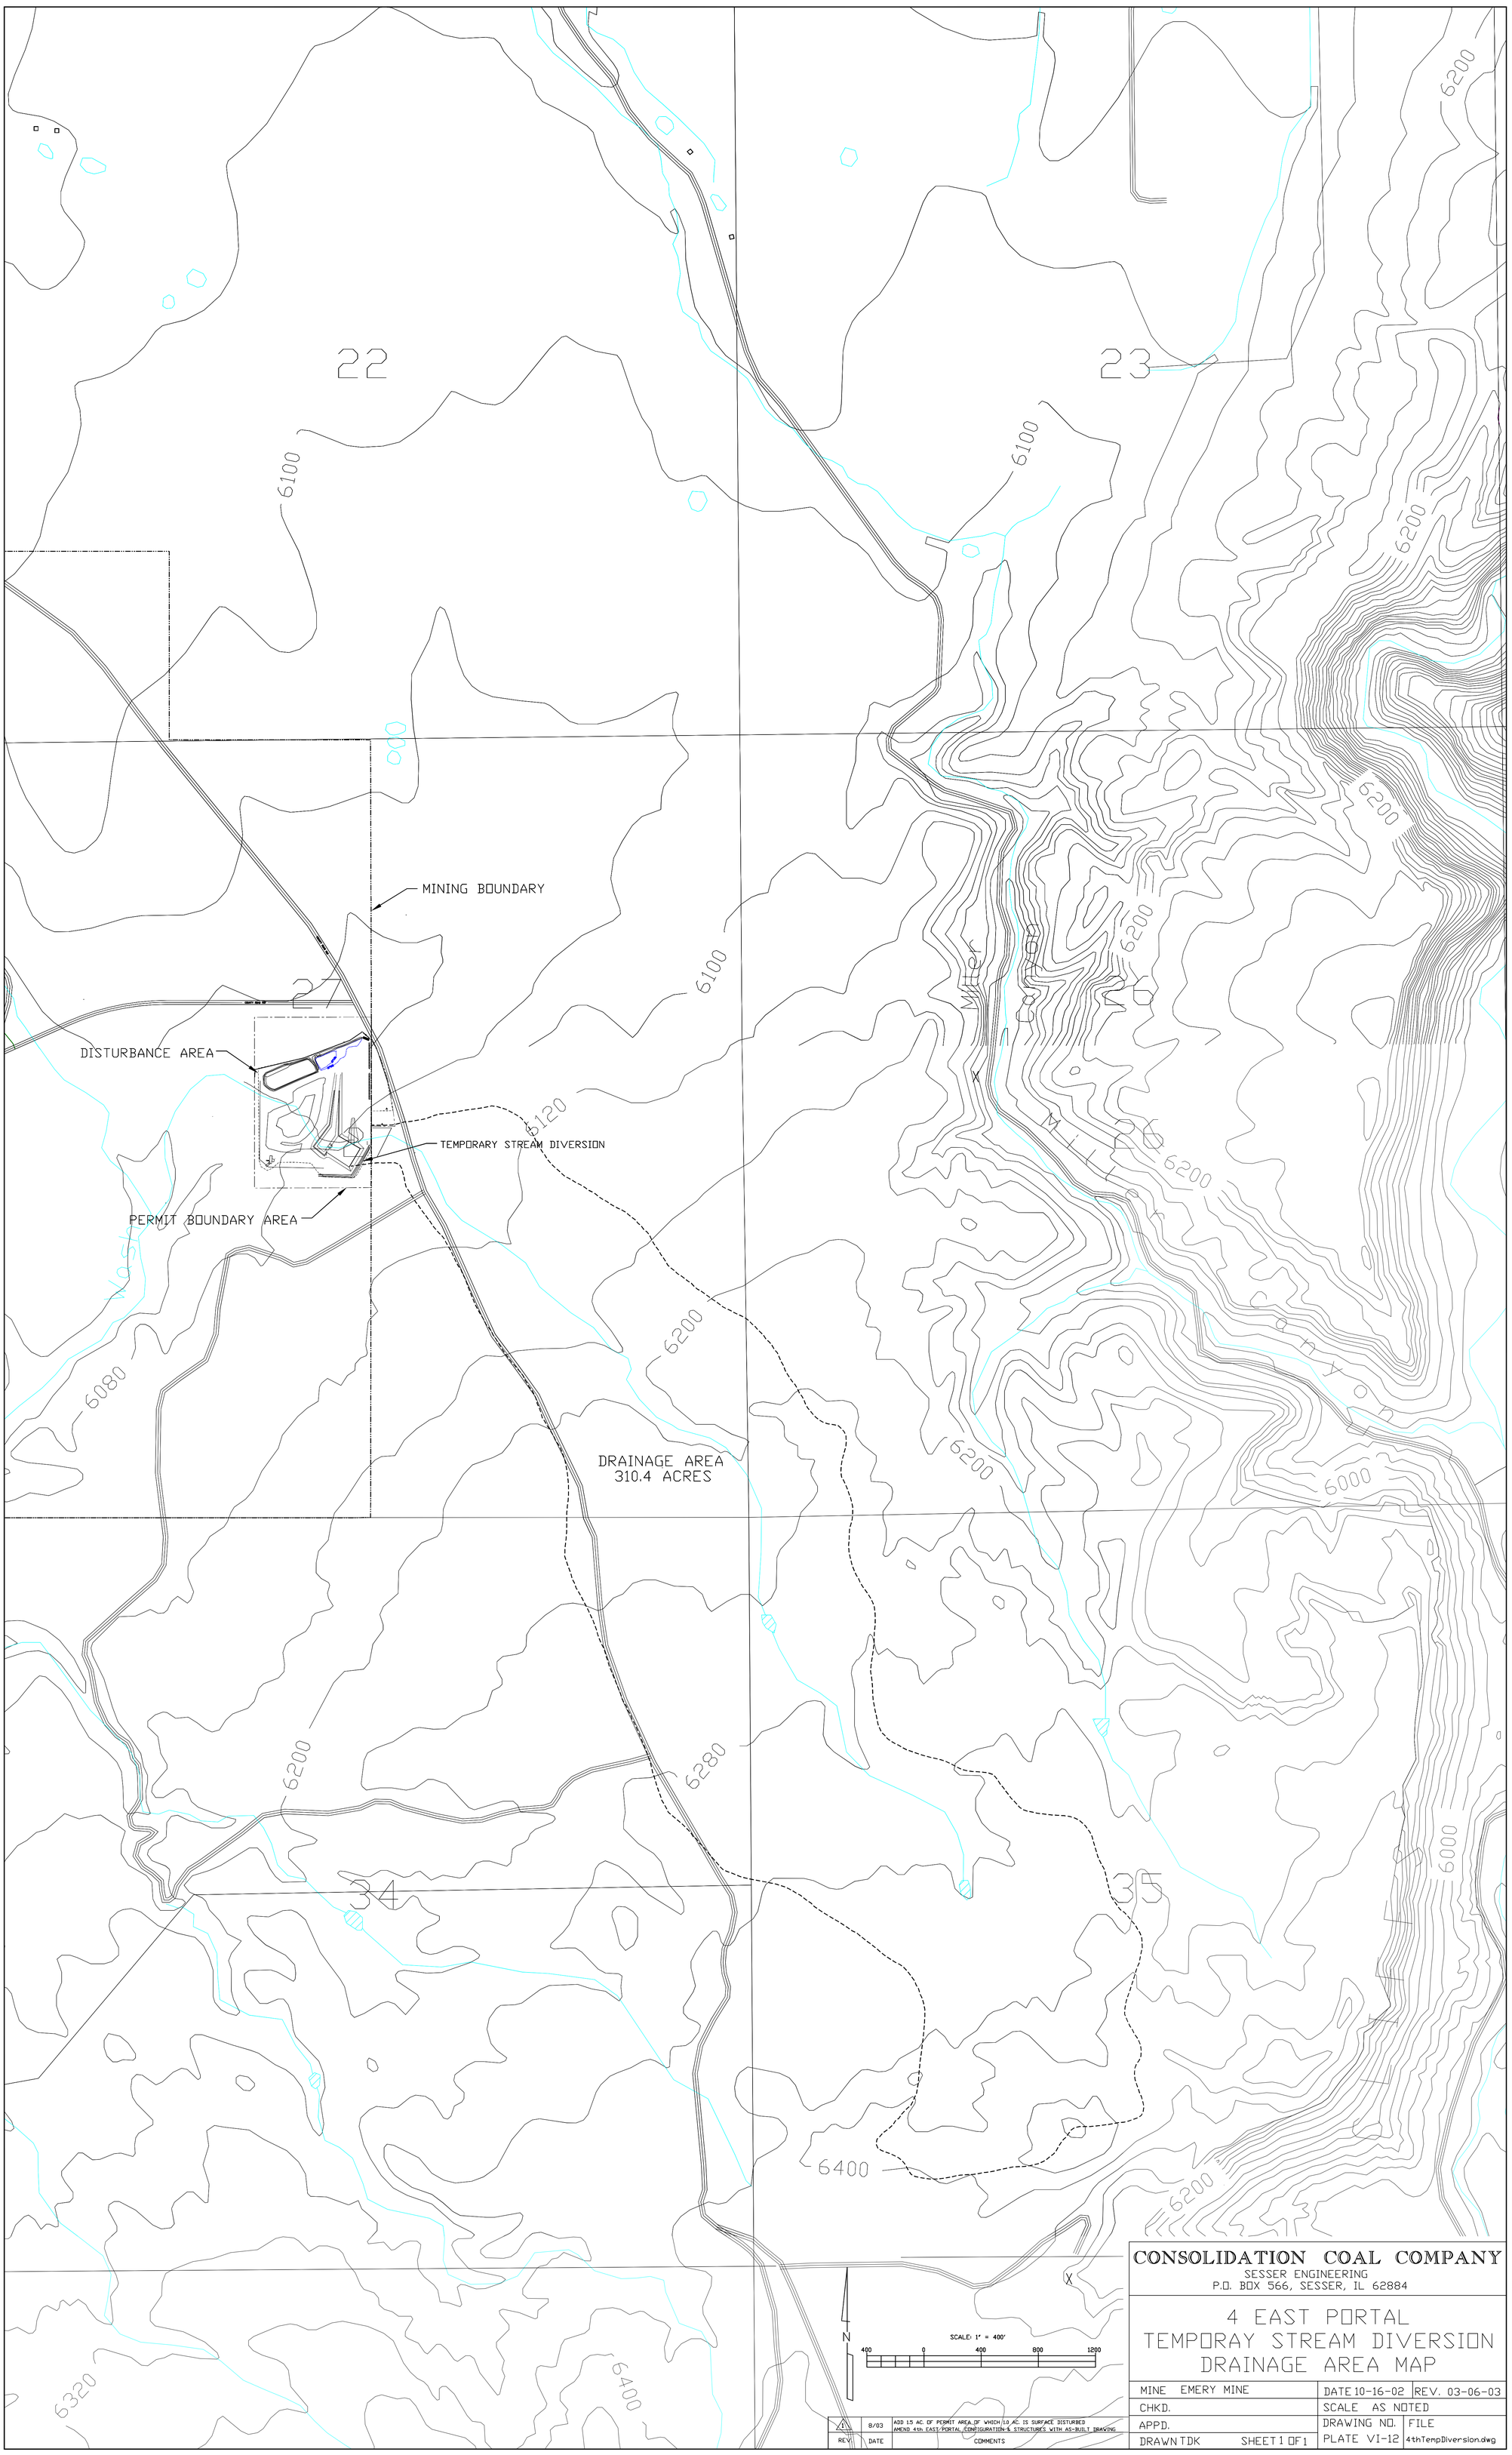

REV.	DATE	COMMENTS
1	8/03	ADD 1.5 AC. OF PERMIT AREA OF WHICH 1.0 AC. IS SURFACE DISTURBED AMEND 4th EAST PORTAL CONFIGURATION & STRUCTURES WITH AS-BUILT DRAWING

CONSOLIDATION COAL COMPANY
SESSER ENGINEERING
P.O. BOX 566, SESSER, IL 62884

4 EAST PORTAL TEMPORAY STREAM DIVERSION DRAINAGE AREA MAP

MINE EMERY MINE	DATE 10-16-02	REV. 03-06-03
CHKD.	SCALE AS NOTED	
APPD.	DRAWING NO.	FILE
DRAWN TDK SHEET 1 OF 1	PLATE VI-12	4thTempDiversion.dwg