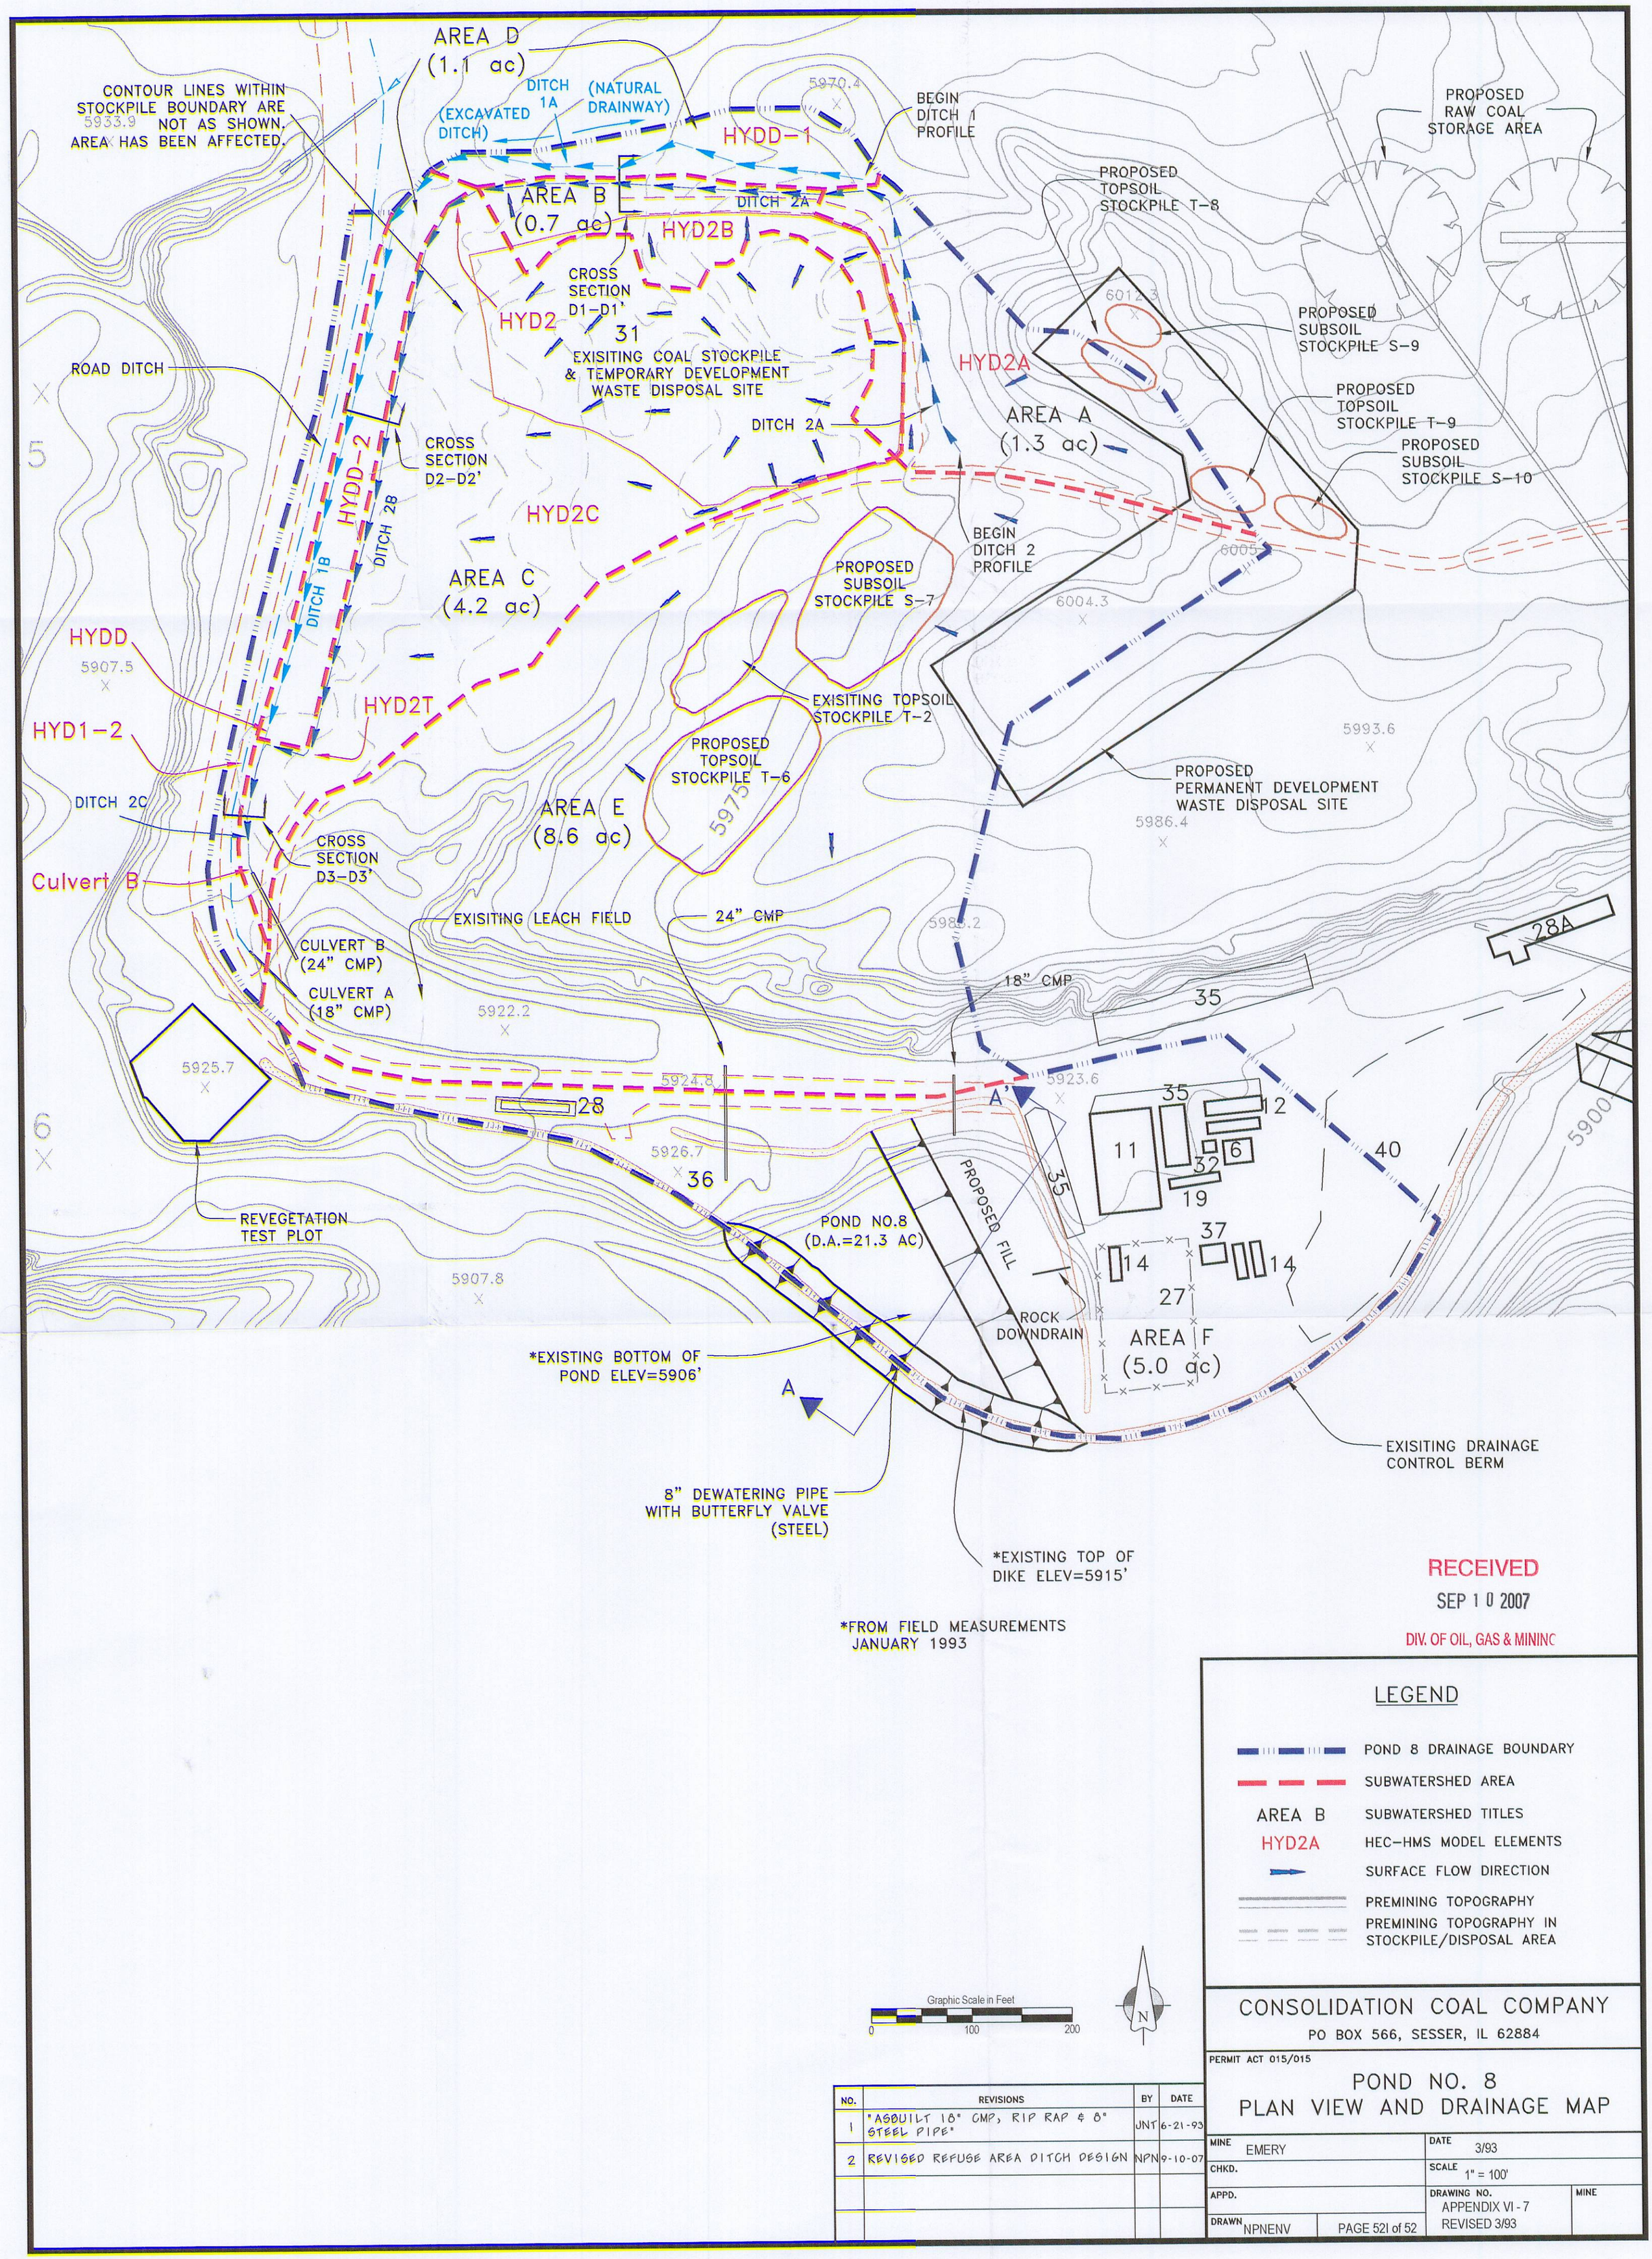

RECEIVED
SEP 1 0 2007
DIV. OF OIL, GAS & MININC

LEGEND

	POND 8 DRAINAGE BOUNDARY
	SUBWATERSHED AREA
AREA B	SUBWATERSHED TITLES
HYD2A	HEC-HMS MODEL ELEMENTS
	SURFACE FLOW DIRECTION
	PREMINING TOPOGRAPHY
	PREMINING TOPOGRAPHY IN STOCKPILE/DISPOSAL AREA

NO.	REVISIONS	BY	DATE
1	"ASBUILT 18" CMP, RIP RAP & 8" STEEL PIPE"	JNT	6-21-93
2	REVISED REFUSE AREA DITCH DESIGN	NPN	9-10-07

CONSOLIDATION COAL COMPANY
PO BOX 566, SESSER, IL 62884

PERMIT ACT 015/015

POND NO. 8
PLAN VIEW AND DRAINAGE MAP

MINE EMERY		DATE 3/93	
CHKD.		SCALE 1" = 100'	
APPD.		DRAWING NO. APPENDIX VI - 7 REVISED 3/93	MINE
DRAWN NPNENV	PAGE 52I of 52		