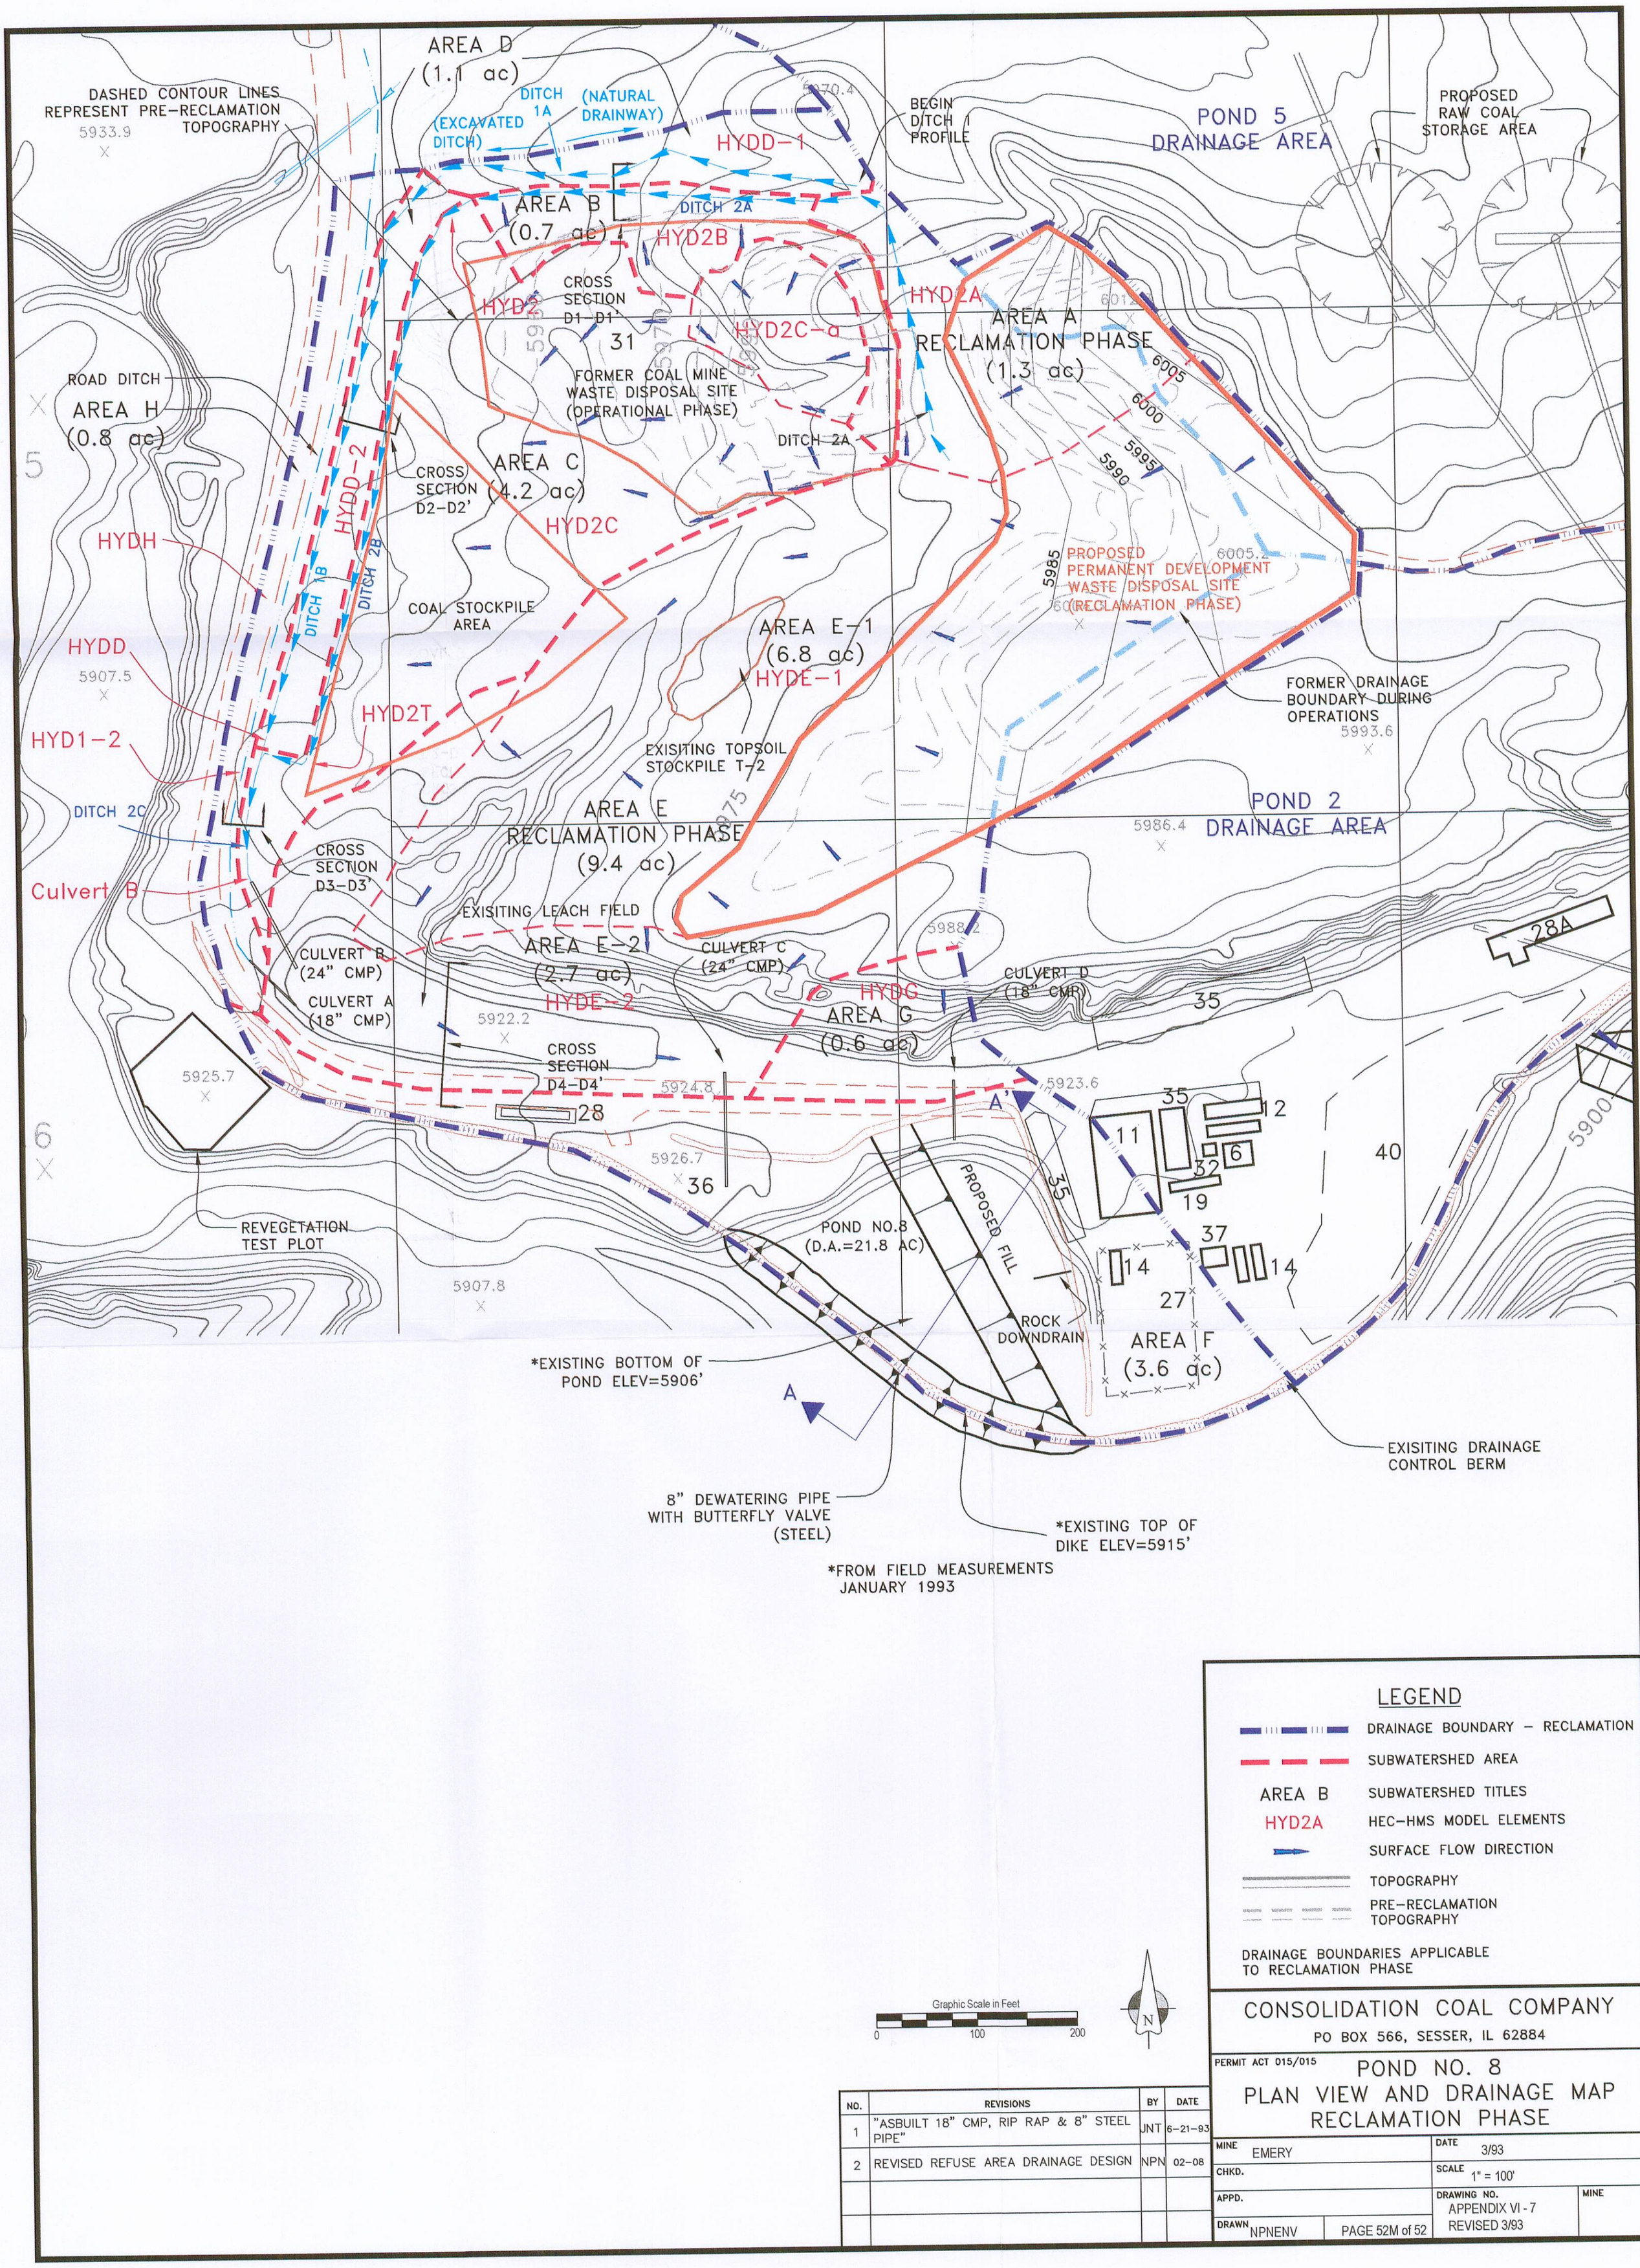

LEGEND

- DRAINAGE BOUNDARY – RECLAMATION
- SUBWATERSHED AREA
- AREA B — SUBWATERSHED TITLES
- HYD2A — HEC–HMS MODEL ELEMENTS
- SURFACE FLOW DIRECTION
- TOPOGRAPHY
- PRE–RECLAMATION TOPOGRAPHY

DRAINAGE BOUNDARIES APPLICABLE TO RECLAMATION PHASE

Graphic Scale in Feet
0 100 200

N

NO.	REVISIONS	BY	DATE
1	"ASBUILT 18" CMP, RIP RAP & 8" STEEL PIPE"	JNT	6-21-93
2	REVISED REFUSE AREA DRAINAGE DESIGN	NPN	02-08

CONSOLIDATION COAL COMPANY
PO BOX 566, SESSER, IL 62884

PERMIT ACT 015/015

POND NO. 8
PLAN VIEW AND DRAINAGE MAP RECLAMATION PHASE

MINE EMERY		DATE 3/93	
CHKD.		SCALE 1" = 100'	
APPD.		DRAWING NO. APPENDIX VI - 7 REVISED 3/93	MINE
DRAWN NPNENV	PAGE 52M of 52		