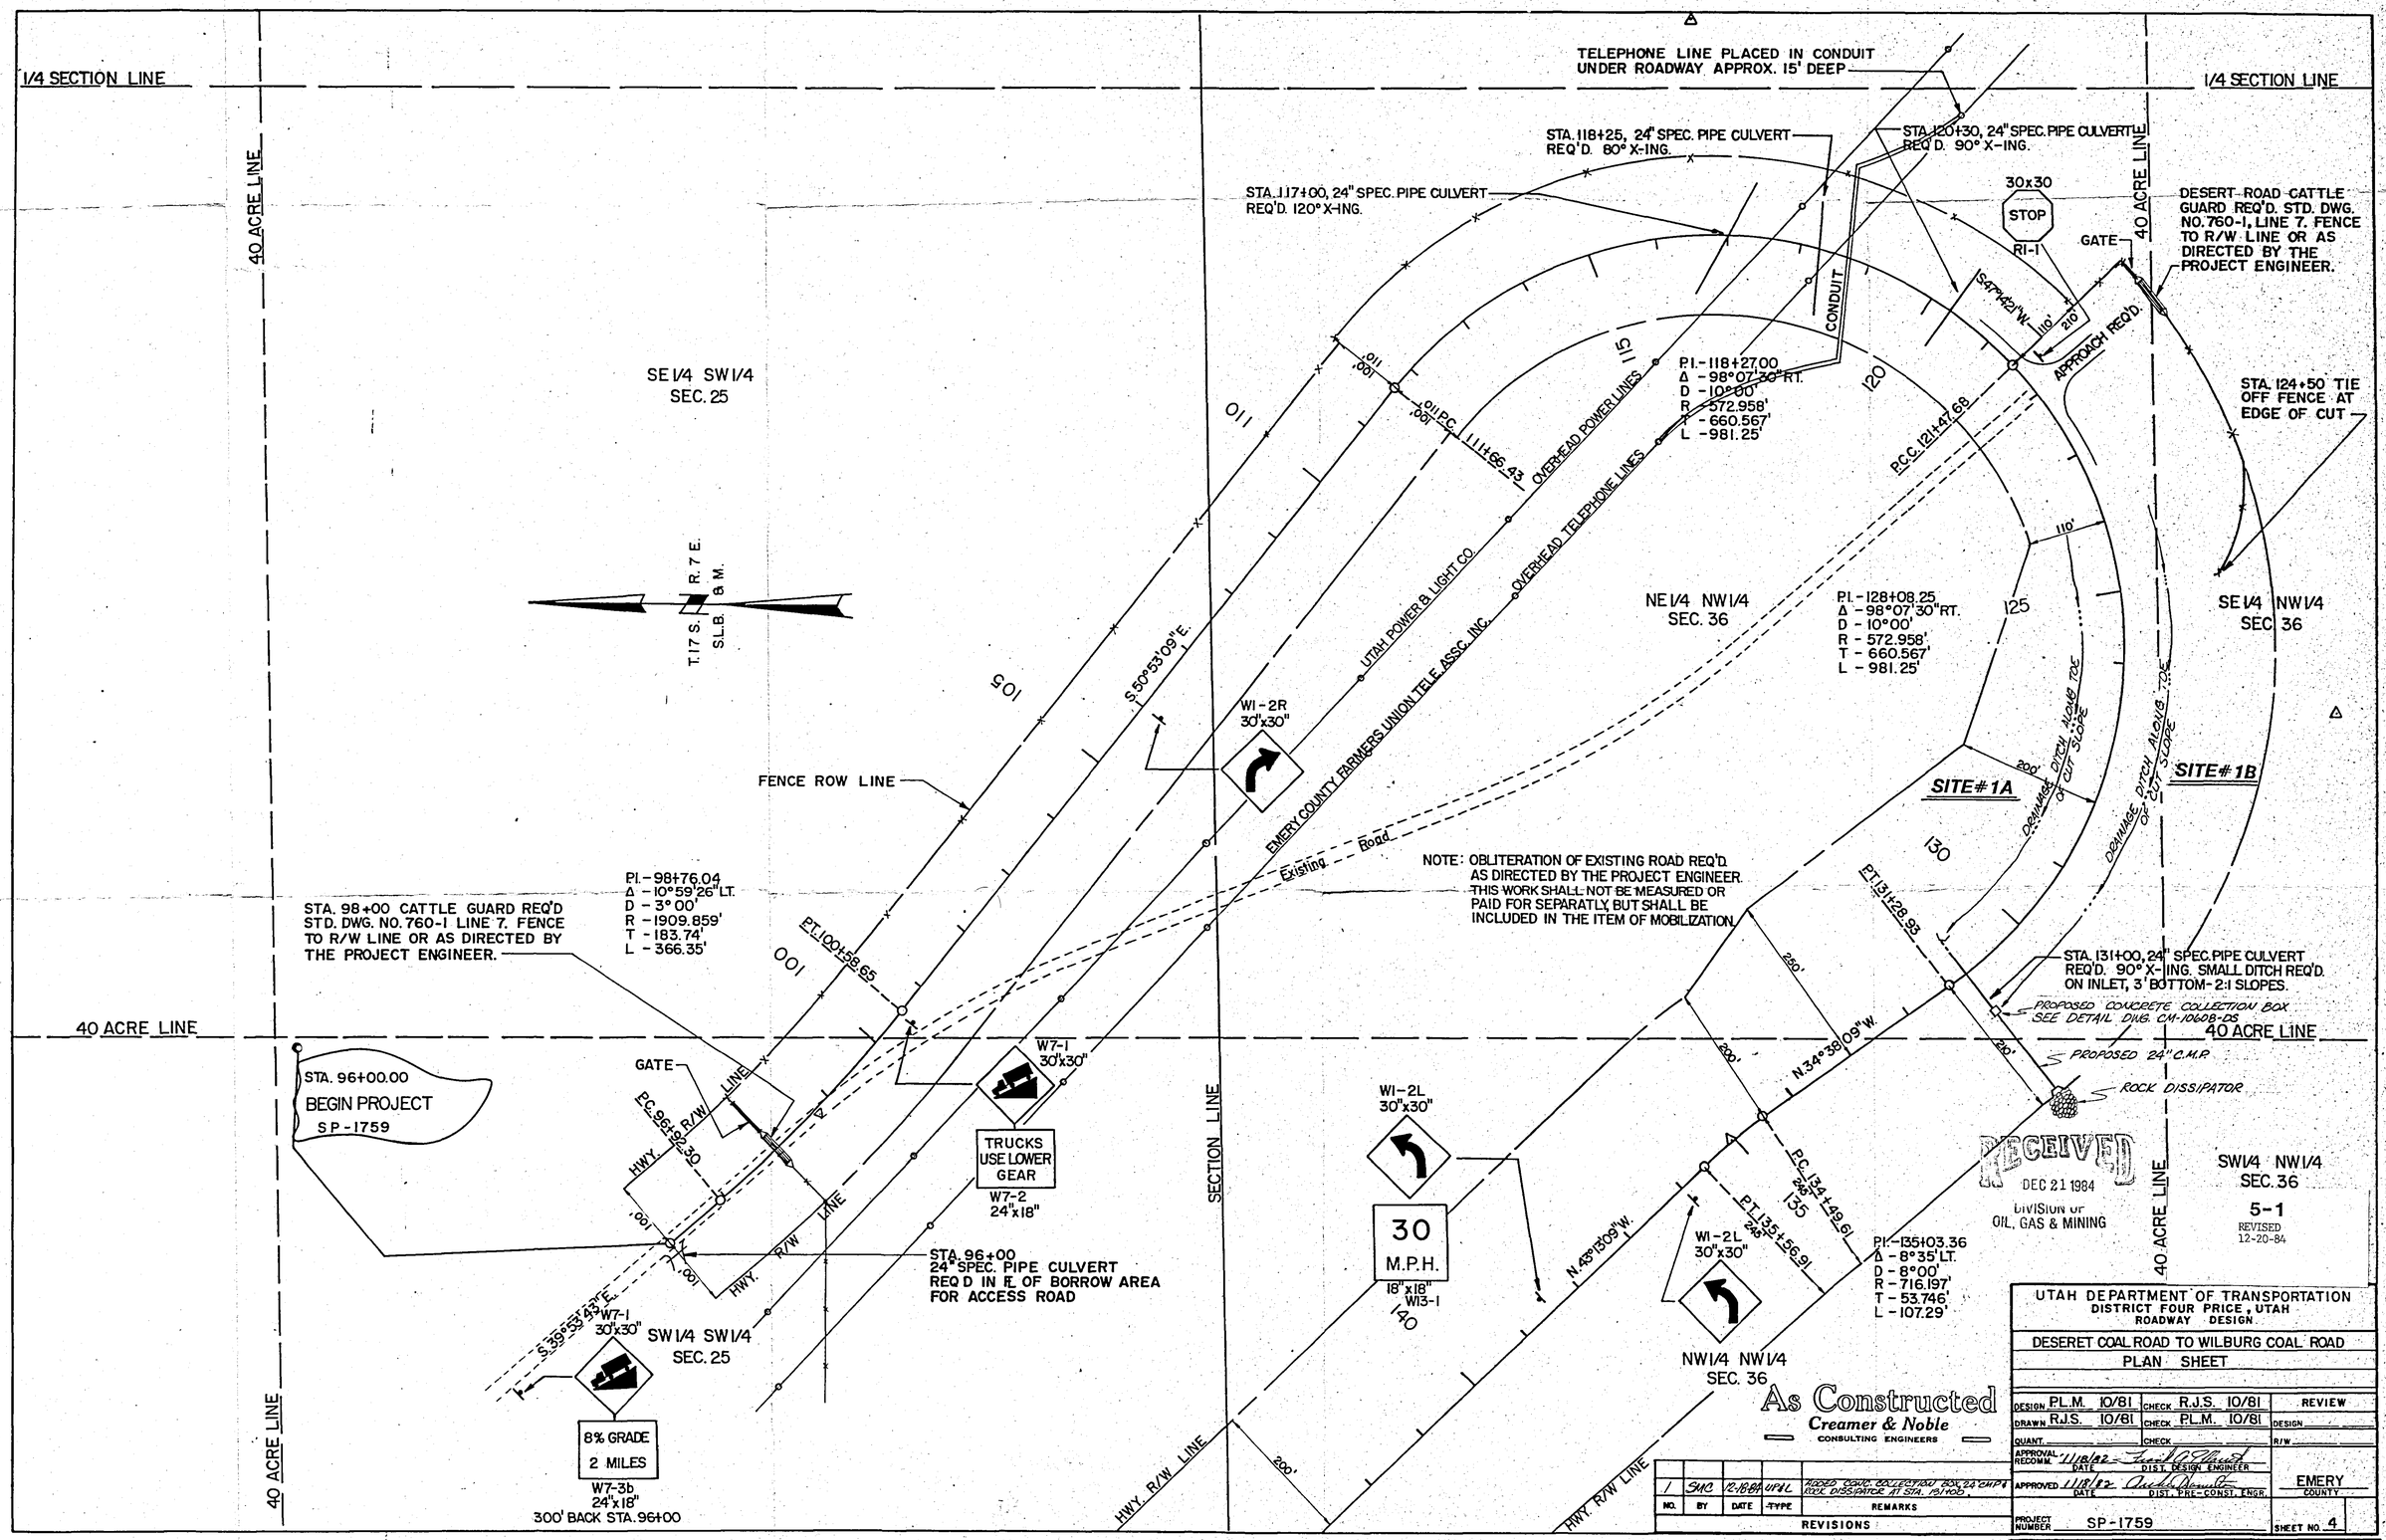

RECEIVED DEC 21 1984 DIVISION OF OIL, GAS & MINING

As Constructed
Creamer & Noble
CONSULTING ENGINEERS

NO.	BY	DATE	TYPE	REMARKS
1	SMC	12-18-84	UP&L	ADDED CONC. COLLECTION BOX, 24" CMP & ROCK DISSIPATOR AT STA. 131+00.

REVISIONS

UTAH DEPARTMENT OF TRANSPORTATION
DISTRICT FOUR PRICE, UTAH
ROADWAY DESIGN

DESERET COAL ROAD TO WILBURG COAL ROAD
PLAN SHEET

DESIGN	P.L.M. 10/81	CHECK	R.J.S. 10/81	REVIEW	
DRAWN	R.J.S. 10/81	CHECK	P.L.M. 10/81	DESIGN	
QUANT.		CHECK		R/W	
APPROVAL RECOMM.	1/18/82 DATE	DIST. DESIGN ENGINEER			
APPROVED	1/18/82 DATE	DIST. PRE-CONST. ENGR.		EMERY COUNTY	
PROJECT NUMBER	SP-1759			SHEET NO. 4	

UTAH POWER & LIGHT COMPANY
DEPARTMENT OF MINING & EXPLORATION

Sheet 8 of 38 | AWB 8/9/84 | Dwg.# CM-10584-DS