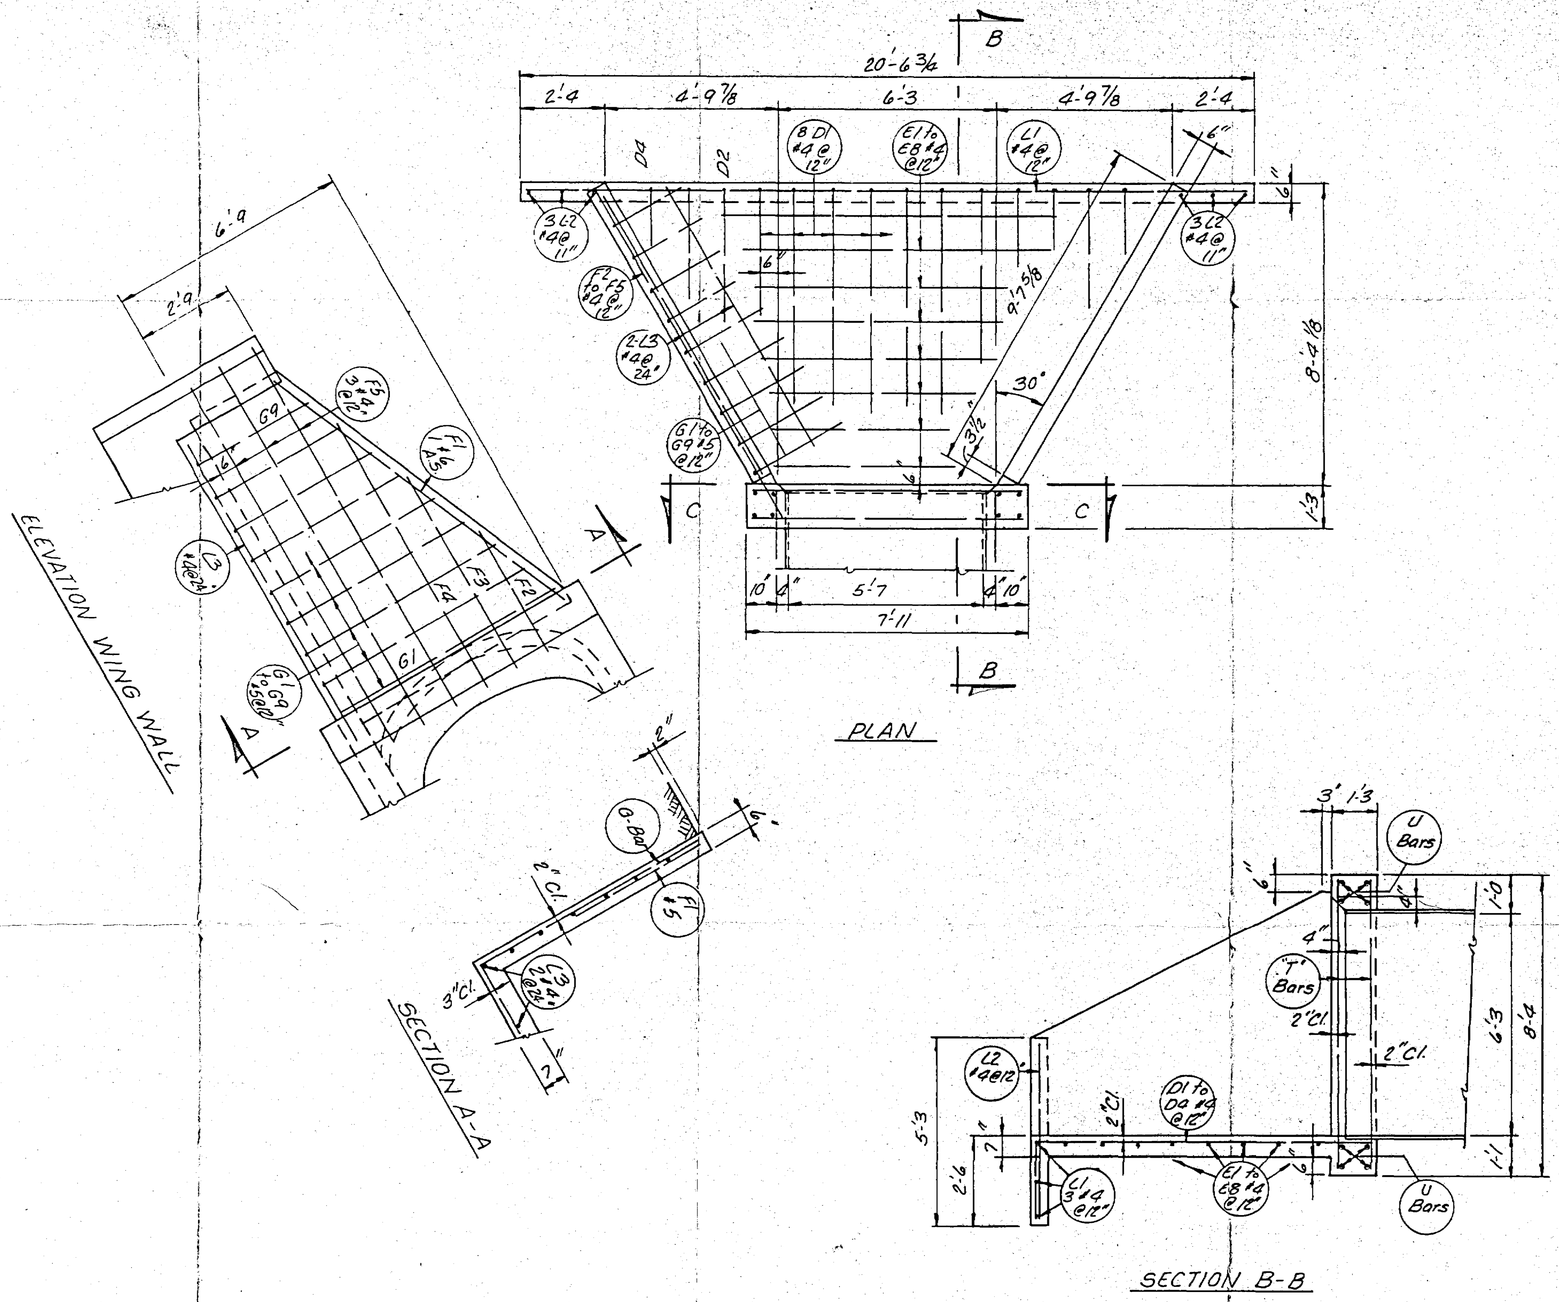

5-1
Addition 10-1-84

As Constructed
Creamer & Noble
CONSULTING ENGINEERS

NO	BY	DATE	REMARKS

REVISIONS

UTAH DEPARTMENT OF TRANSPORTATION
SALT LAKE CITY, UTAH
STRUCTURES DIVISION

STANDARD HEADWALL
FOR 72" CMP W/ TAPERED INLET
@ 90° X-ING ANGLE

DESIGN H.G.E.		CHECK	
DRAWN SMP 7/81		CHECK SMP 7/81	
QUANT H.G.E.		CHECK SMP 7/81	STATION
APPROVAL RECOMM. 7/13/81	DATE	W. D. Tilley P.E. GROUP LEADER	COUNTY
APPROVED 7-14-81	DATE	Lay J. Stahling ASST. STRUCTURAL ENGR.	DRG. NO. I-7
			SHT. 2 OF 2

UTAH POWER & LIGHT COMPANY
DEPARTMENT OF MINING & EXPLORATION

Sheet 36 of 38 | AWB 8/9/84 | Dwg.# CM-10584-DS