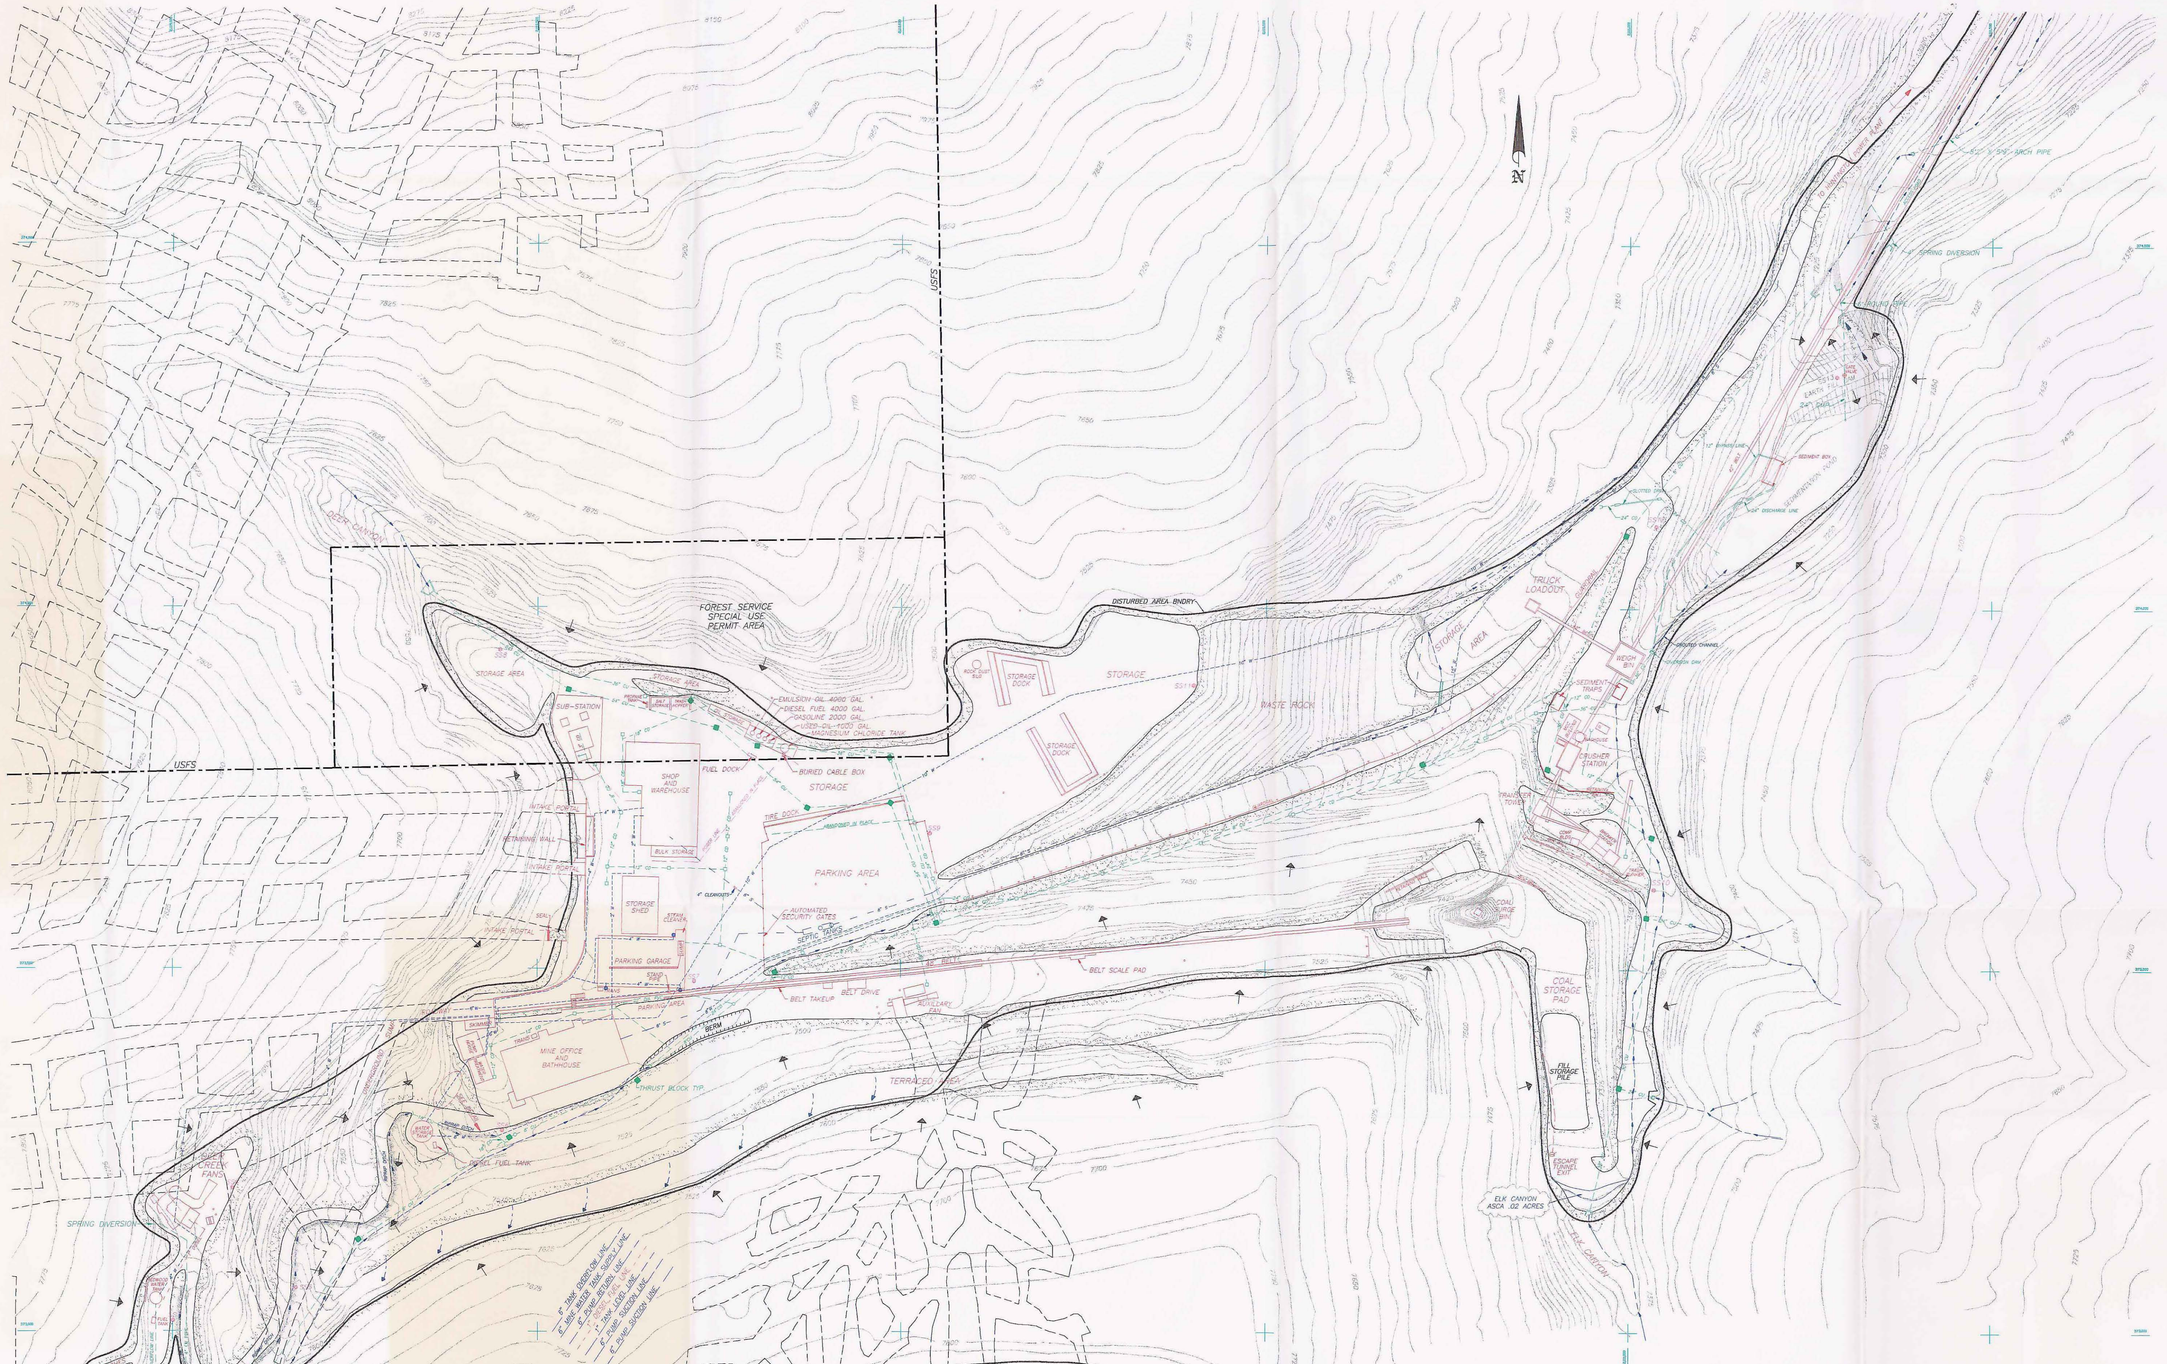

LEGEND

- WATER LINE
- SEWER LINE
- CULVERT
- SURFACE DRAINAGE
- CANYON DRAINAGE
- INLET
- DROP INLET
- THRUST BLOCK
- MANHOLE
- DOWN SLOPE OF HILL
- POWER LINE
- POWER POLES
- SS3 SOIL SAMPLE LOCATION
- FUEL LINE
- CD CULVERT (DISTURBED)
- CU CULVERT (UNDISTURBED)
- FIRE HYDRANT

LICENSED PROFESSIONAL ENGINEER
KEVIN CHRISTENSEN
6/16/96
No. 155651
STATE OF UTAH

NOTE:
WORK THIS DWG. WITH DWG. CM-10882-DR (PLATE 1-4), FOR EXTENTS OF DISTURBED AREA BOUNDARY

DATE	REVISIONS	BY	CHK
6-3-96	ADDED DISTURBED AREA AND USFS BOUNDARIES	KJL	
5-31-96	REVISED DRAINAGE TO CURRENT CONDITIONS, REVISED THRUST BLOCKS	KJL	
4-24-96	ADDED RETAINING WALL AT COAL BIN, POWER POLES AND SKIMMER	KJL	
4-17-96	ADDED 4" WATER LINES, FIRE HYDRANTS AND BELT SCALE PAD	KJL	
10-2-95	ADDED BIN WALL AT COAL SURGE BIN AREA, AND SOIL PILE	KJL	
4-20-95	ADDED TIRE DOCK, SEDIMENTENT RETENTION BOX AND REVISED COAL SURGE BIN TO REFLECT EXISTING CONTOURS	KJL	
1-29-93	ADDED STORAGE DOCKS, STEAM CLEANER, PROPANE TANK AND 4" WATER LINE. REMOVED OLD SUB-STATION, POWER POLES AND SWITCH GEARS.	KJL	
12-10-91	ADDED MCC BLDG AND STORAGE DOCK.	KJL	
4-16-91	REVISED SEWER LINE LOCATION FROM WAREHOUSE. ADDED CLEANOUTS	KJL	
2-21-91	GENERAL REVISIONS AND ADDITIONS TO REFLECT CURRENT FACILITIES.	KJL	
1-22-91	ADDED 6' ROUND AND 8'X5'9" ARCH PIPES BELOW SEDIMENTATION POND.	KJL	
10-3-90	REVISED DRAINAGE TO REFLECT CURRENT CONDITIONS	KJL	
6-5-90	ADDED TRASH BUNKER, 12'CD,DROP INLET AND COMPRESSOR BLDG AT TIPPLE. REVISED 15" WATER AND 8" SEWER LINES.	KJL	
5-24-90	ADDED 18" PVC MINE DISCHARGE LINE.	KJL	
1-19-90	ADDED AUTOMATED SECURITY GATES AT SECURITY GUARD STATION	KJL	
1-10-90	ADDED ELK CANYON ASCA .02 ACRES	KJL	
11-3-89	REVISED DRAINAGE AND SURFACE FACILITIES TO REFLECT CURRENT AS BUILT CONDITIONS.	KJL	TJF
6-6-89	ADDED NEW SUB-STATION AMD POWER POLES-RELOCATED ROCK DUST SILO	KJL	
6-27-88	REVISED DRAINAGE AND SURFACE FACILITIES AND ADDED SOIL SAMPLE LOCATIONS.	KJL	
8-18-87	ADDED PARKING GARAGE AND OIL STORAGE PADS.	KJL	
6-22-87	ADDED CONTOUR LINES	KJL	

SUPERSEDED
EFFECTIVE:
DEC 06 1996
UTAH DIVISION OIL, GAS AND MINING

INCORPORATED
EFFECTIVE:
JUL 2 1996
UTAH DIVISION OIL, GAS AND MINING

MAP 3-9
Vol. 5

RECEIVED
JUN 17 1996
DIV. OF OIL, GAS & MINING

ENERGY WEST MINING COMPANY
HUNTINGTON, UTAH 84528

DEER CREEK MINE
SURFACE YARD MAP

SAVE AS NAME/DISK#: DCPLOT

DRAWN BY: PKB & KJL
SCALE: 1"=100'
DATE: MAY 25, 1994
DRAWING #: DS202E
SHEET 1 OF 1
REV.