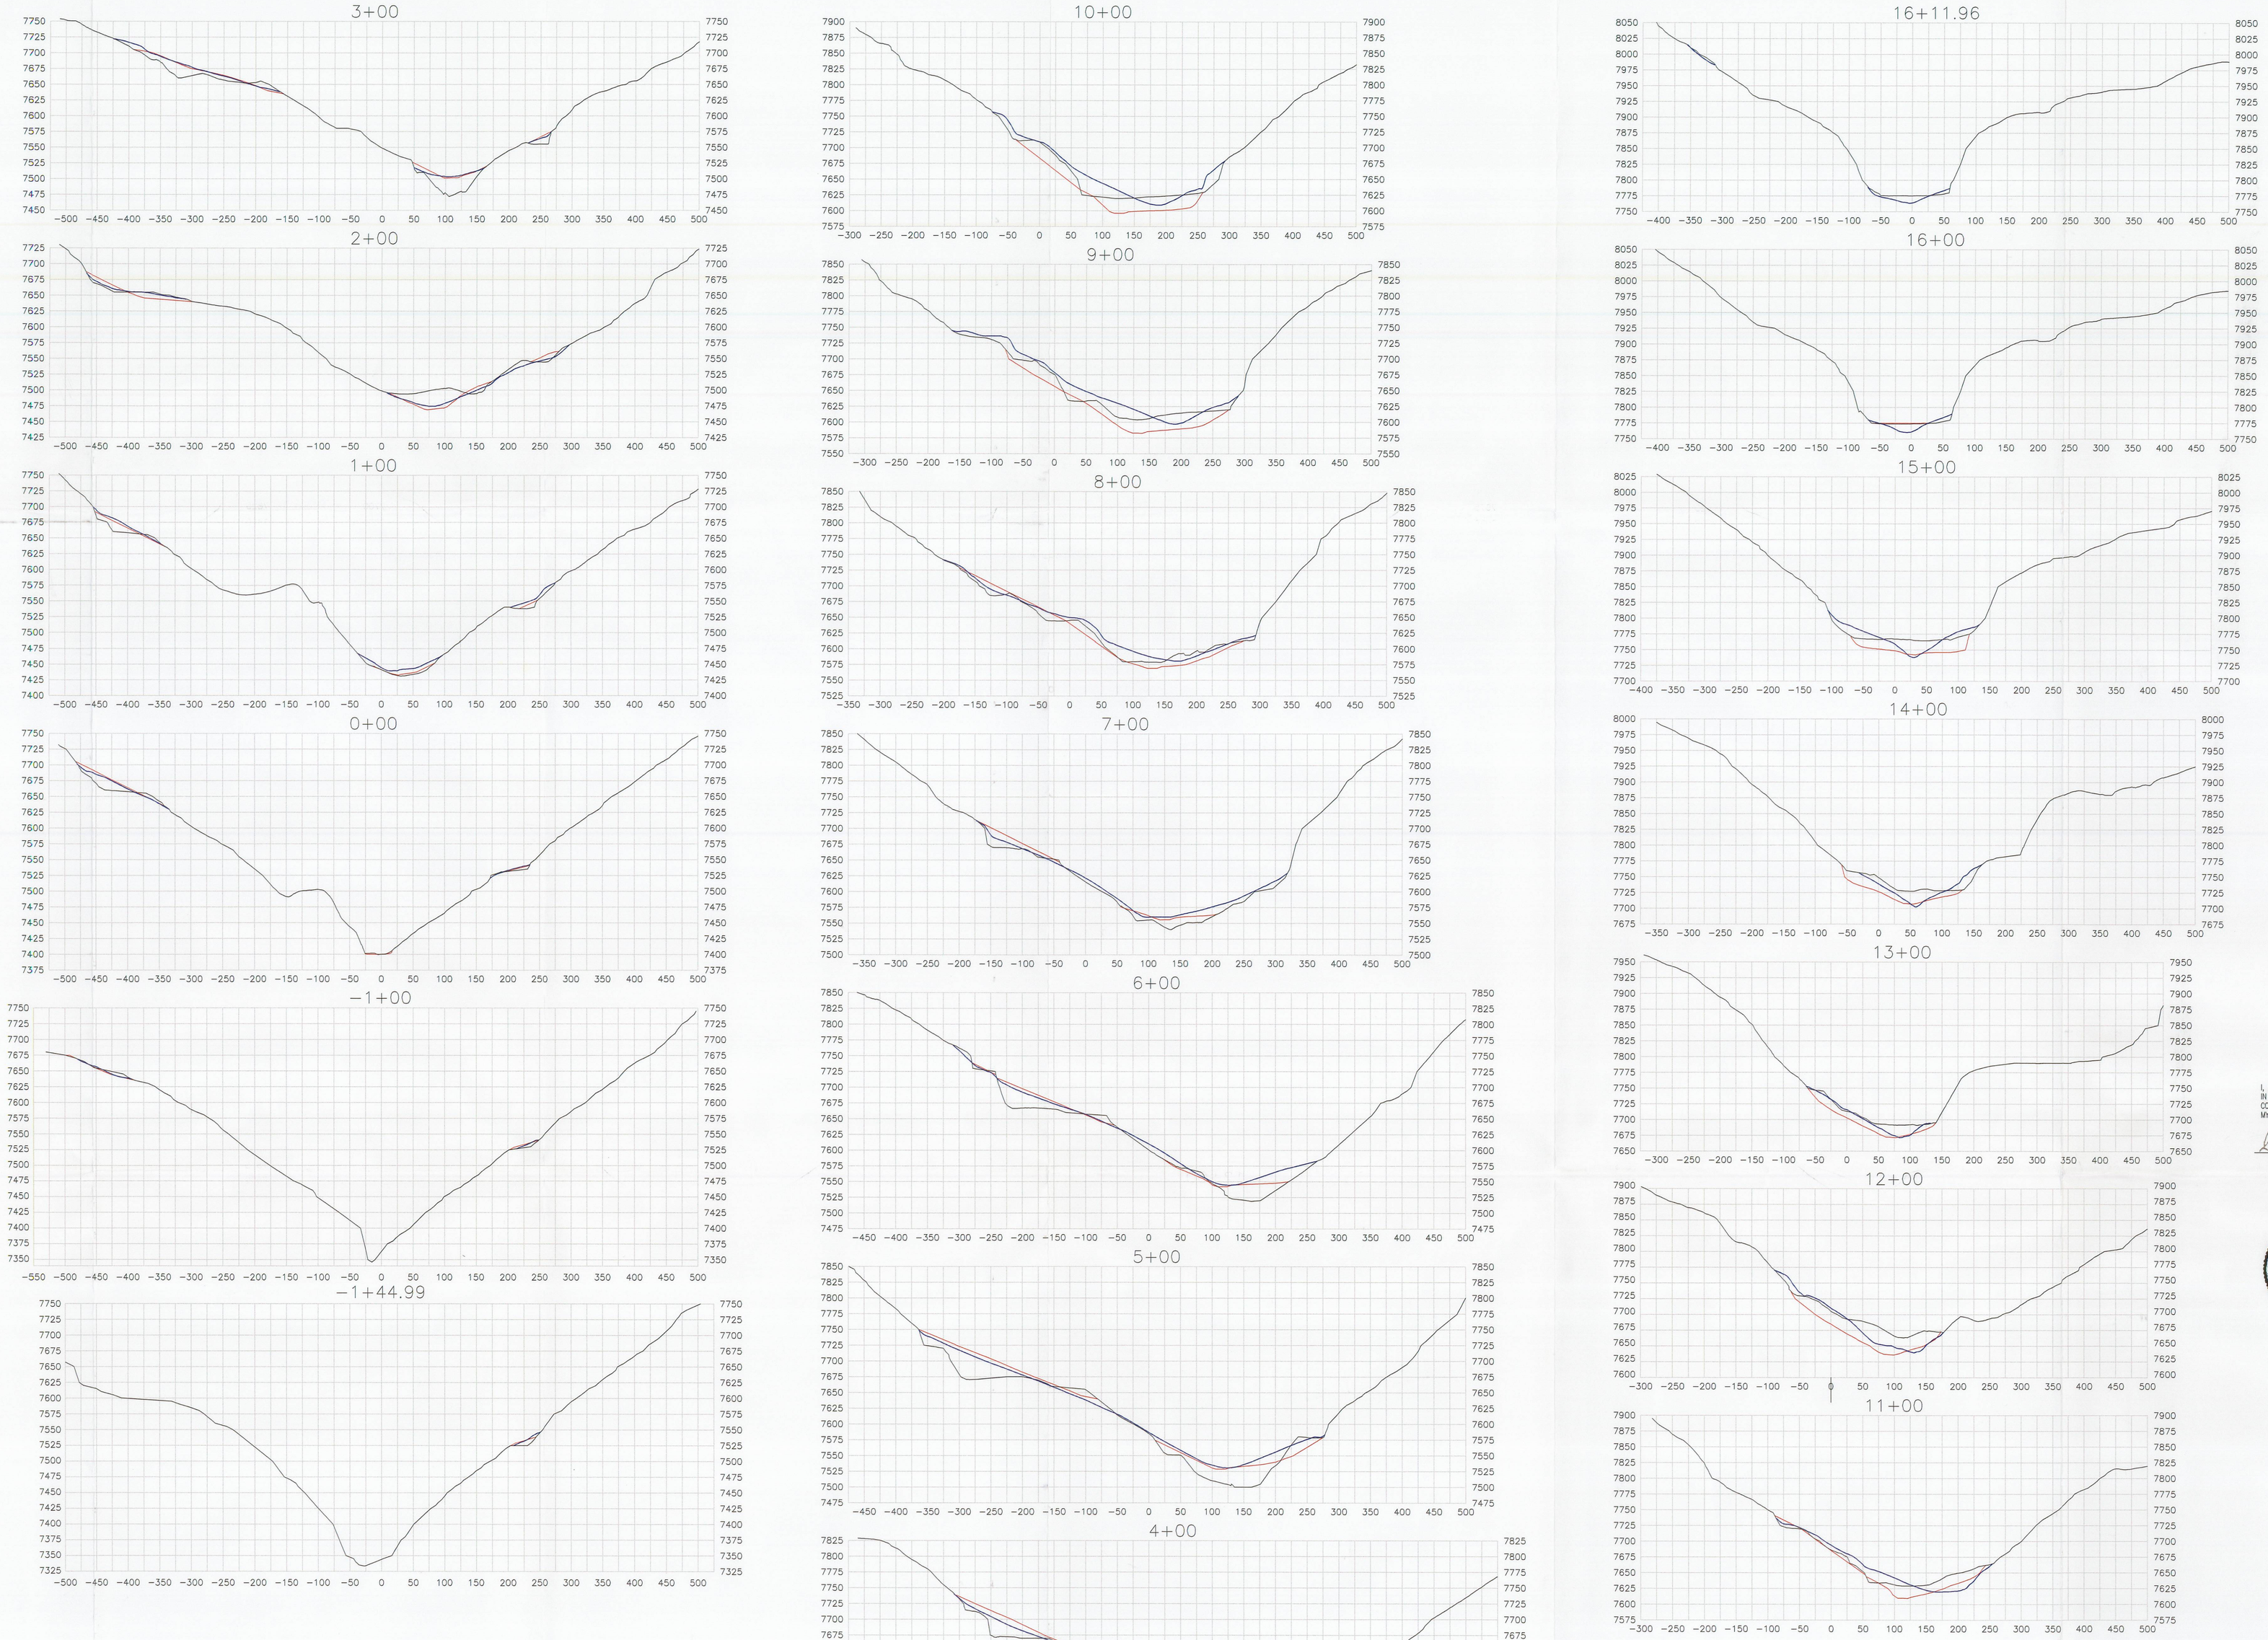

LEGEND

- PRE-RECLAMATION
- FINAL RECLAMATION (PROPOSED)
- FINAL RECLAMATION (AS-BUILT)

NOTE:

FOR PLAN VIEW OF CROSS SECTIONS REFER TO DRAWING 1

REGISTERED PROFESSIONAL ENGINEER No. 160554-2202 DOUGLAS E. JOHNSON STATE OF UTAH

I, DOUGLAS E. JOHNSON BEING A REGISTERED PROFESSIONAL ENGINEER IN THE STATE OF UTAH, DO HEREBY CERTIFY THAT THE INFORMATION CONTAINED ON THIS DRAWING IS TRUE AND ACCURATE TO THE BEST OF MY KNOWLEDGE AND BELIEF.

Douglas E Johnson 12-14-05

DOUGLAS E. JOHNSON NO. 160554-2202 DATE

I CERTIFY THAT THIS DRAWING HAS BEEN PREPARED FROM INFORMATION PROVIDED BY ENERGY WEST MINING CO. AND THAT IT IS CORRECT TO THE BEST OF MY KNOWLEDGE.

RECEIVED

JAN 03 2006

DIV. OF OIL, GAS & MINING

CAD FILE NAME/DISK#: USERS\KJL\DBD\RECLAIM\500-4.DWG

ENERGY WEST
MINING COMPANY
HUNTINGTON, UTAH 84528

DES-BEE-DOVE MINES
PHASE 2 RECLAMATION
CROSS SECTIONS

DATE	REVISIONS	BY	CHK.
12-1-05	ADDED FINAL RECLAMATION AS-BUILT LINES	KJL	
4-26-02	ADDED NOTES AND LEGEND	KJL	

DRAWN BY: K. LARSEN
SCALE: 1" = 100'
DATE: DECEMBER 14, 2005
DRAWING #: 2
SHEET 1 OF 1
REV.