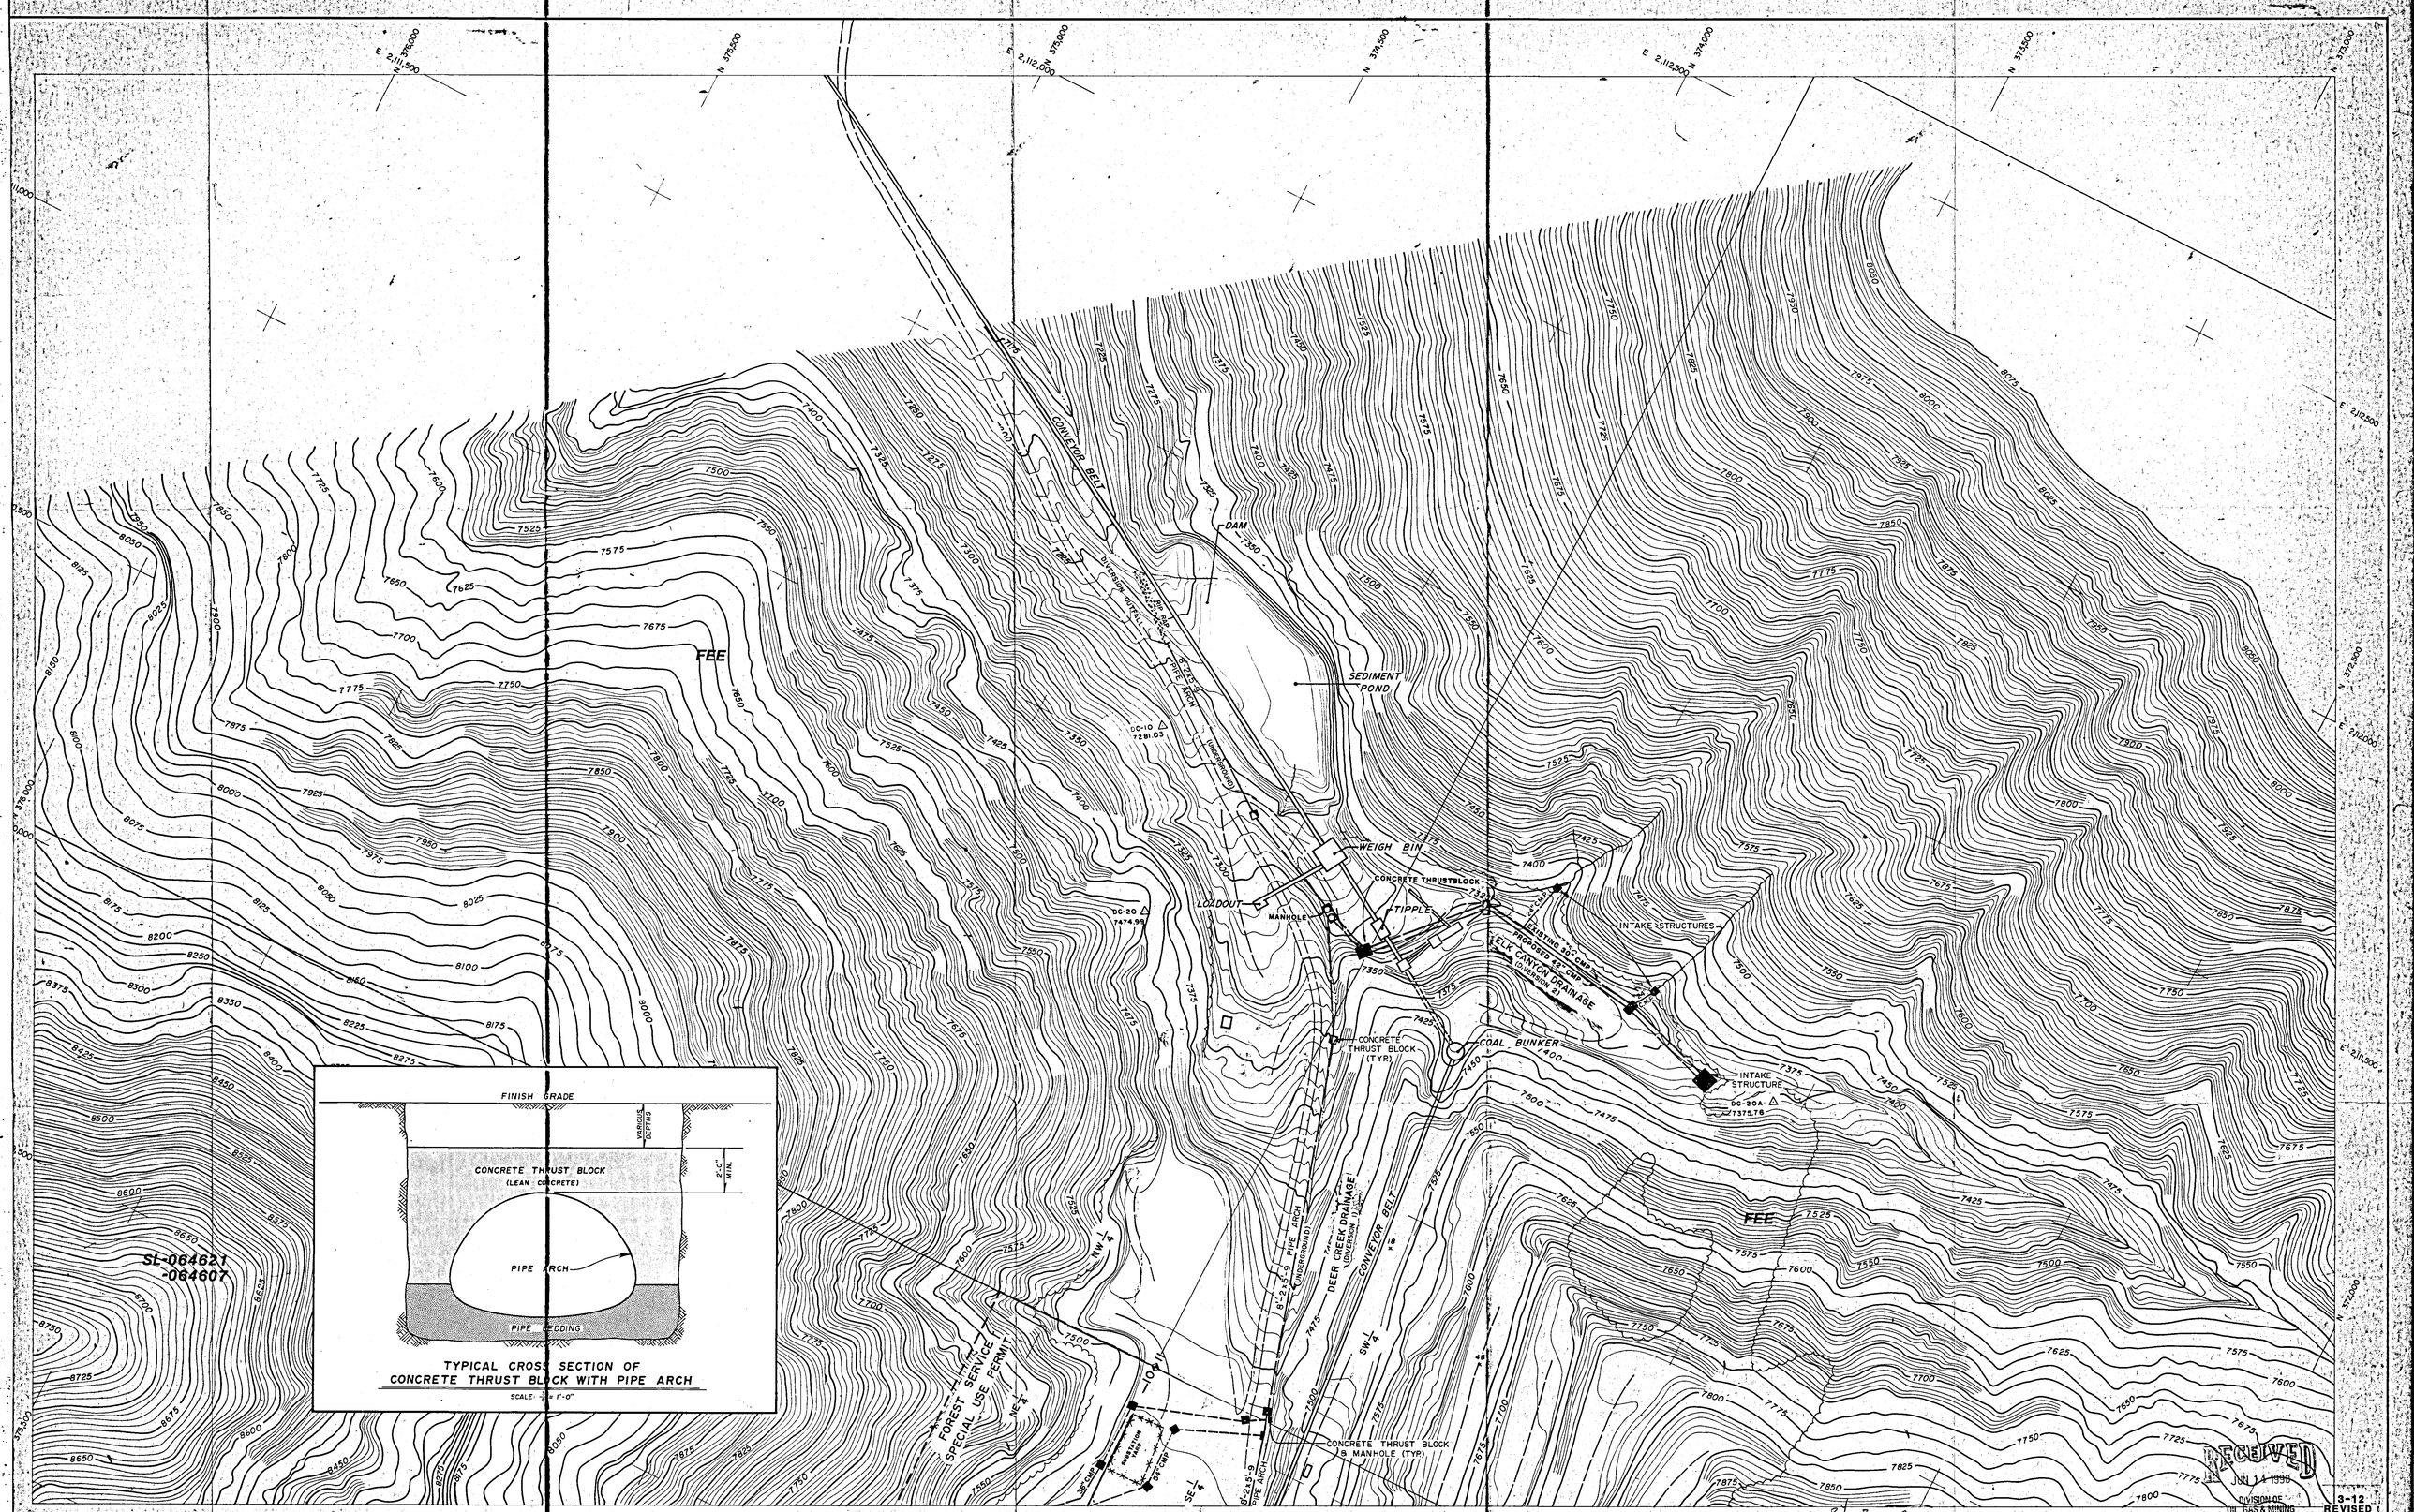

T.17S., R.7E. S.L.B.&M.

REFER TO DWG. #CM-10611-DR FOR INTAKE STRUCTURE DETAILS ON DEER & ELK DRAINAGES. (BY VAUGHN HANSEN ASSOC.)

SUPERCEDED BY CM-10765-DR CBM 6/1/87

DATE	REVISIONS	BY	CHK.
10-2-85	ADDED AS BUILT 54" CMP IN DEER DRAINAGE (DIVERSION 3)	CBM	
2-1-85	ADDED PROPOSED 54" & 42" CULVERTS TO DIVERSIONS 2 & 3	SMC	

CONTOUR INTERVAL = 5.0'

RECEIVED
JUN 14 1990
DIVISION OF OIL, GAS & MINING

3-12
REVISED
2-1-85

DEPARTMENT OF MINING & EXPLORATION

DEER CREEK COAL MINE
EMERY COUNTY, UTAH

UNDISTURBED
DRAINAGE DIVERSION MAP

UTAH POWER & LIGHT COMPANY
SALT LAKE CITY, UTAH

SCALE: 0 100' 200'
DATE: FEBRUARY 14, 1981
Sheet 1 of 2 Dwg. no: CM-10380-DR

Compiled By Photogrammetric Methods — INTERMOUNTAIN AERIAL SURVEYS, Salt Lake City, Utah -7823-May 1978