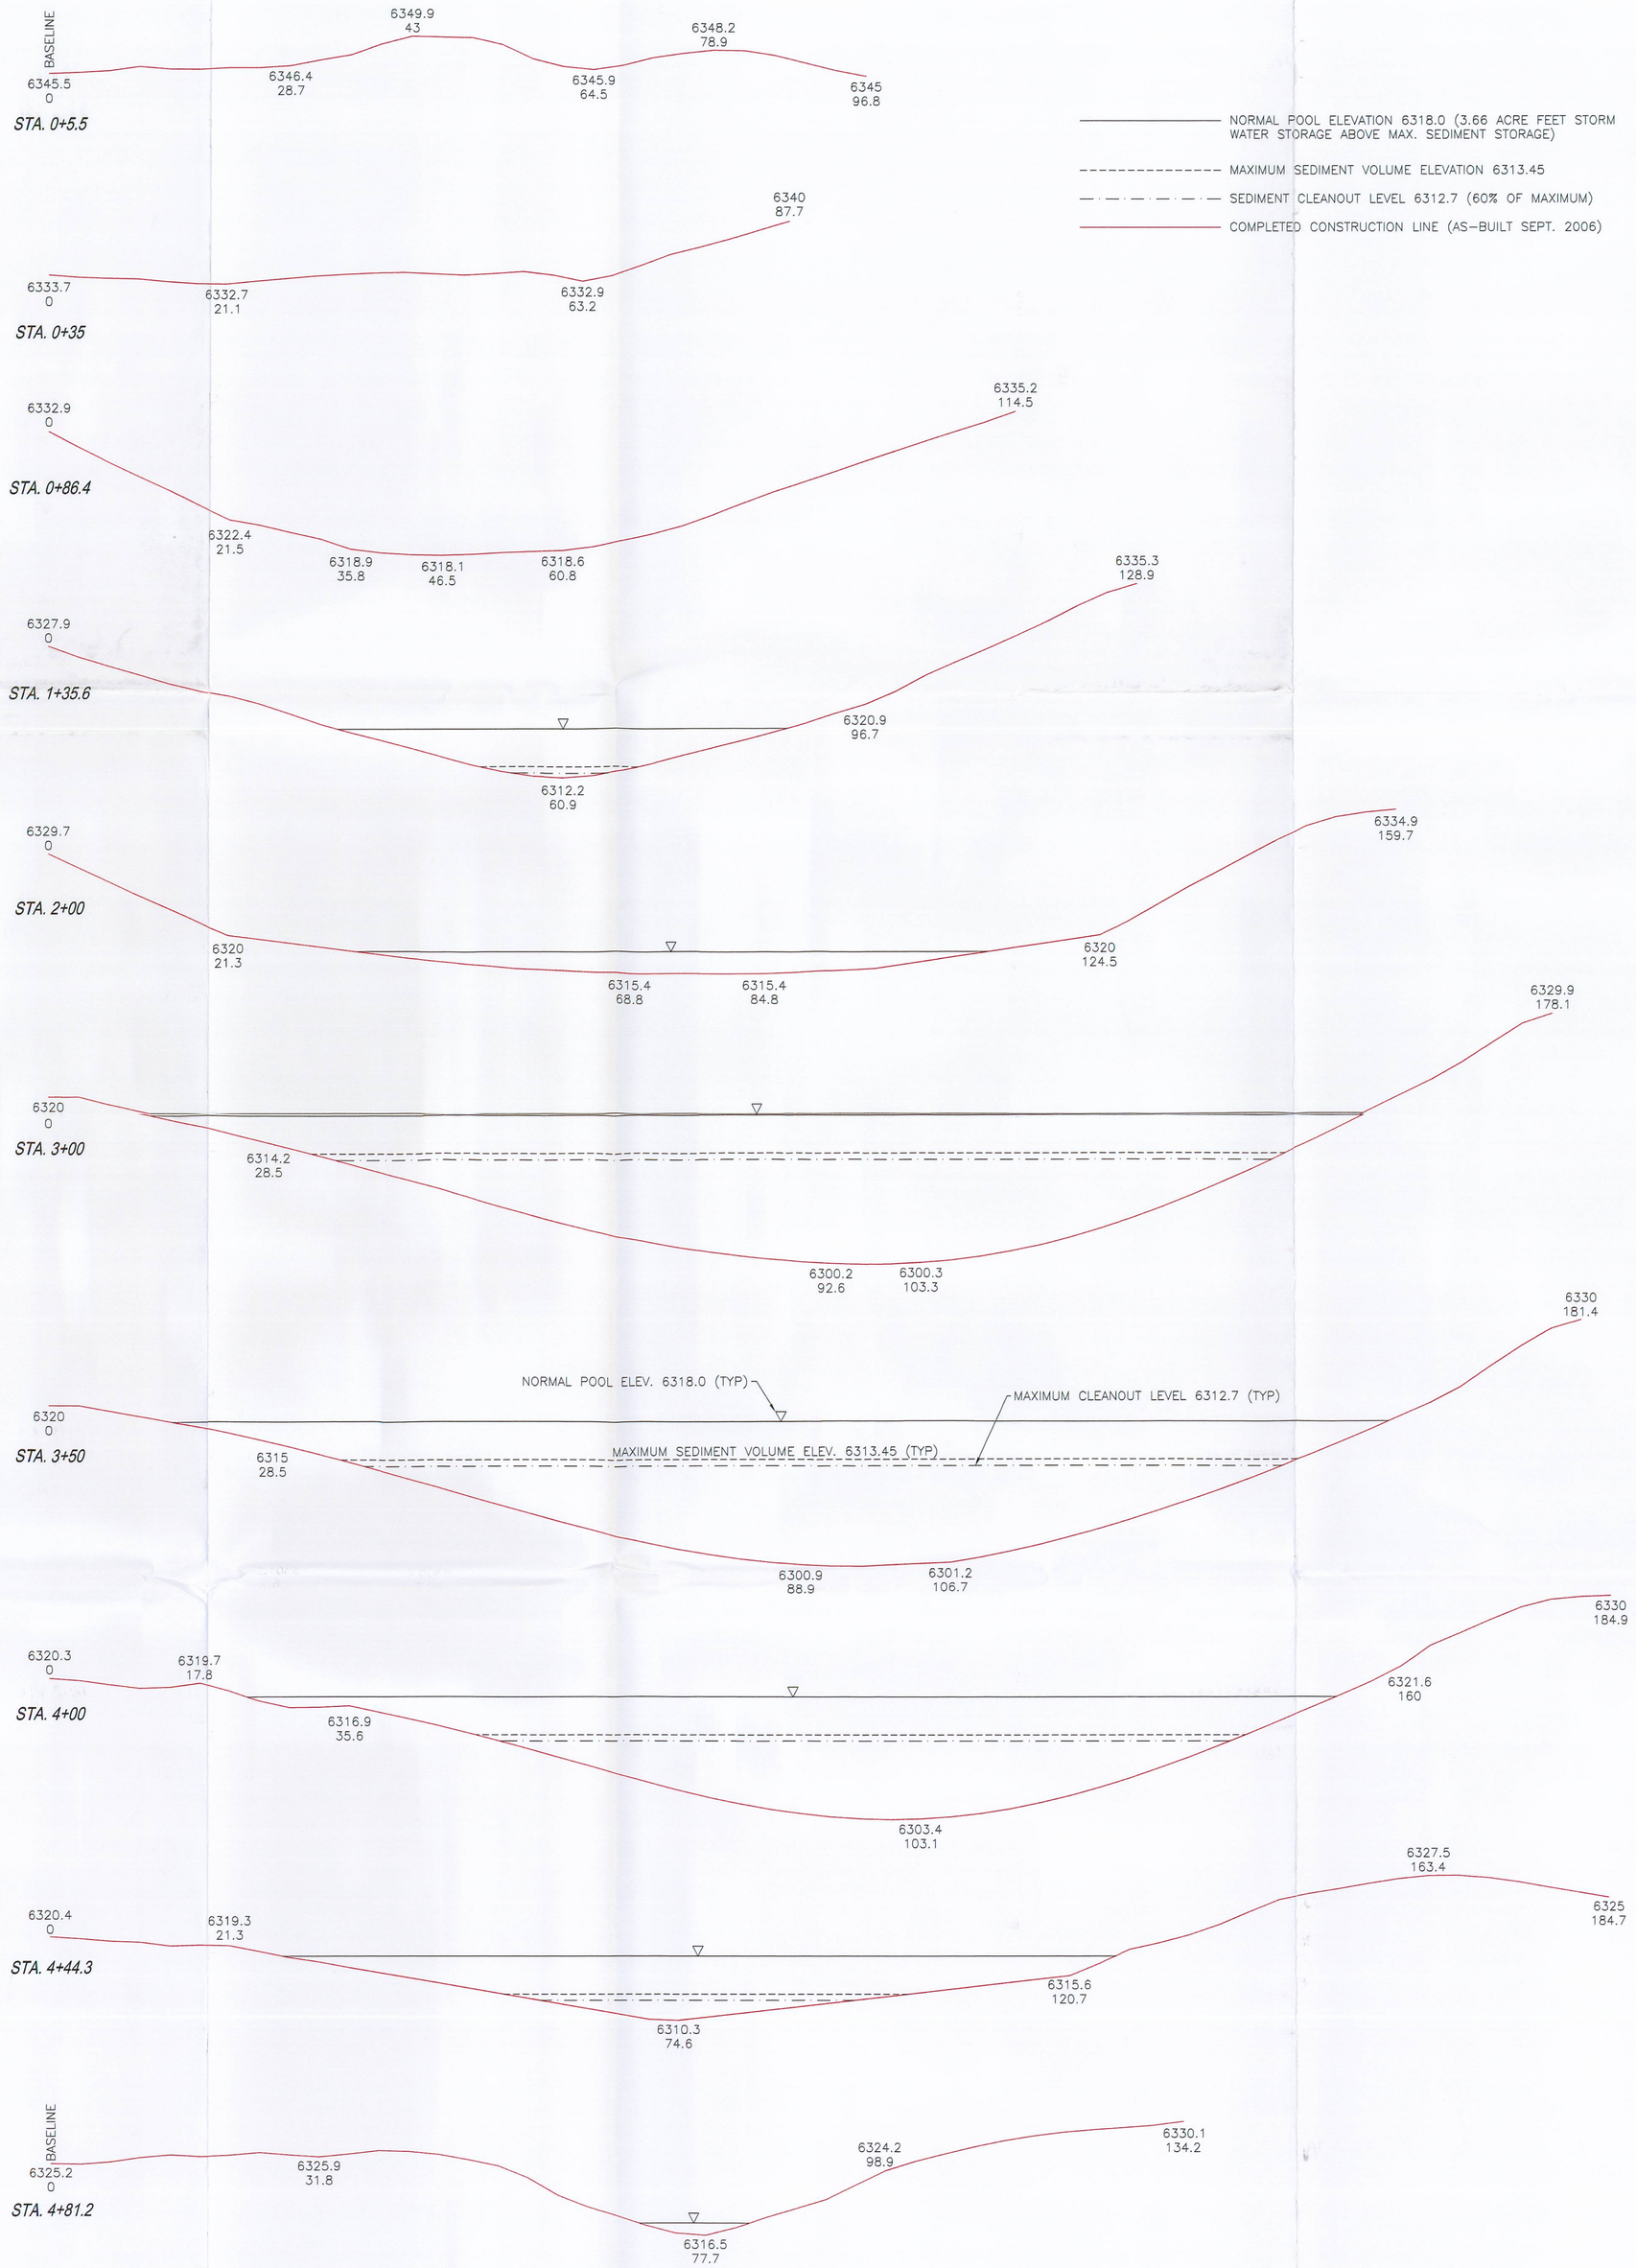

SEDIMENT BASIN - CROSS SECTIONS

SCALE: 1"=10'

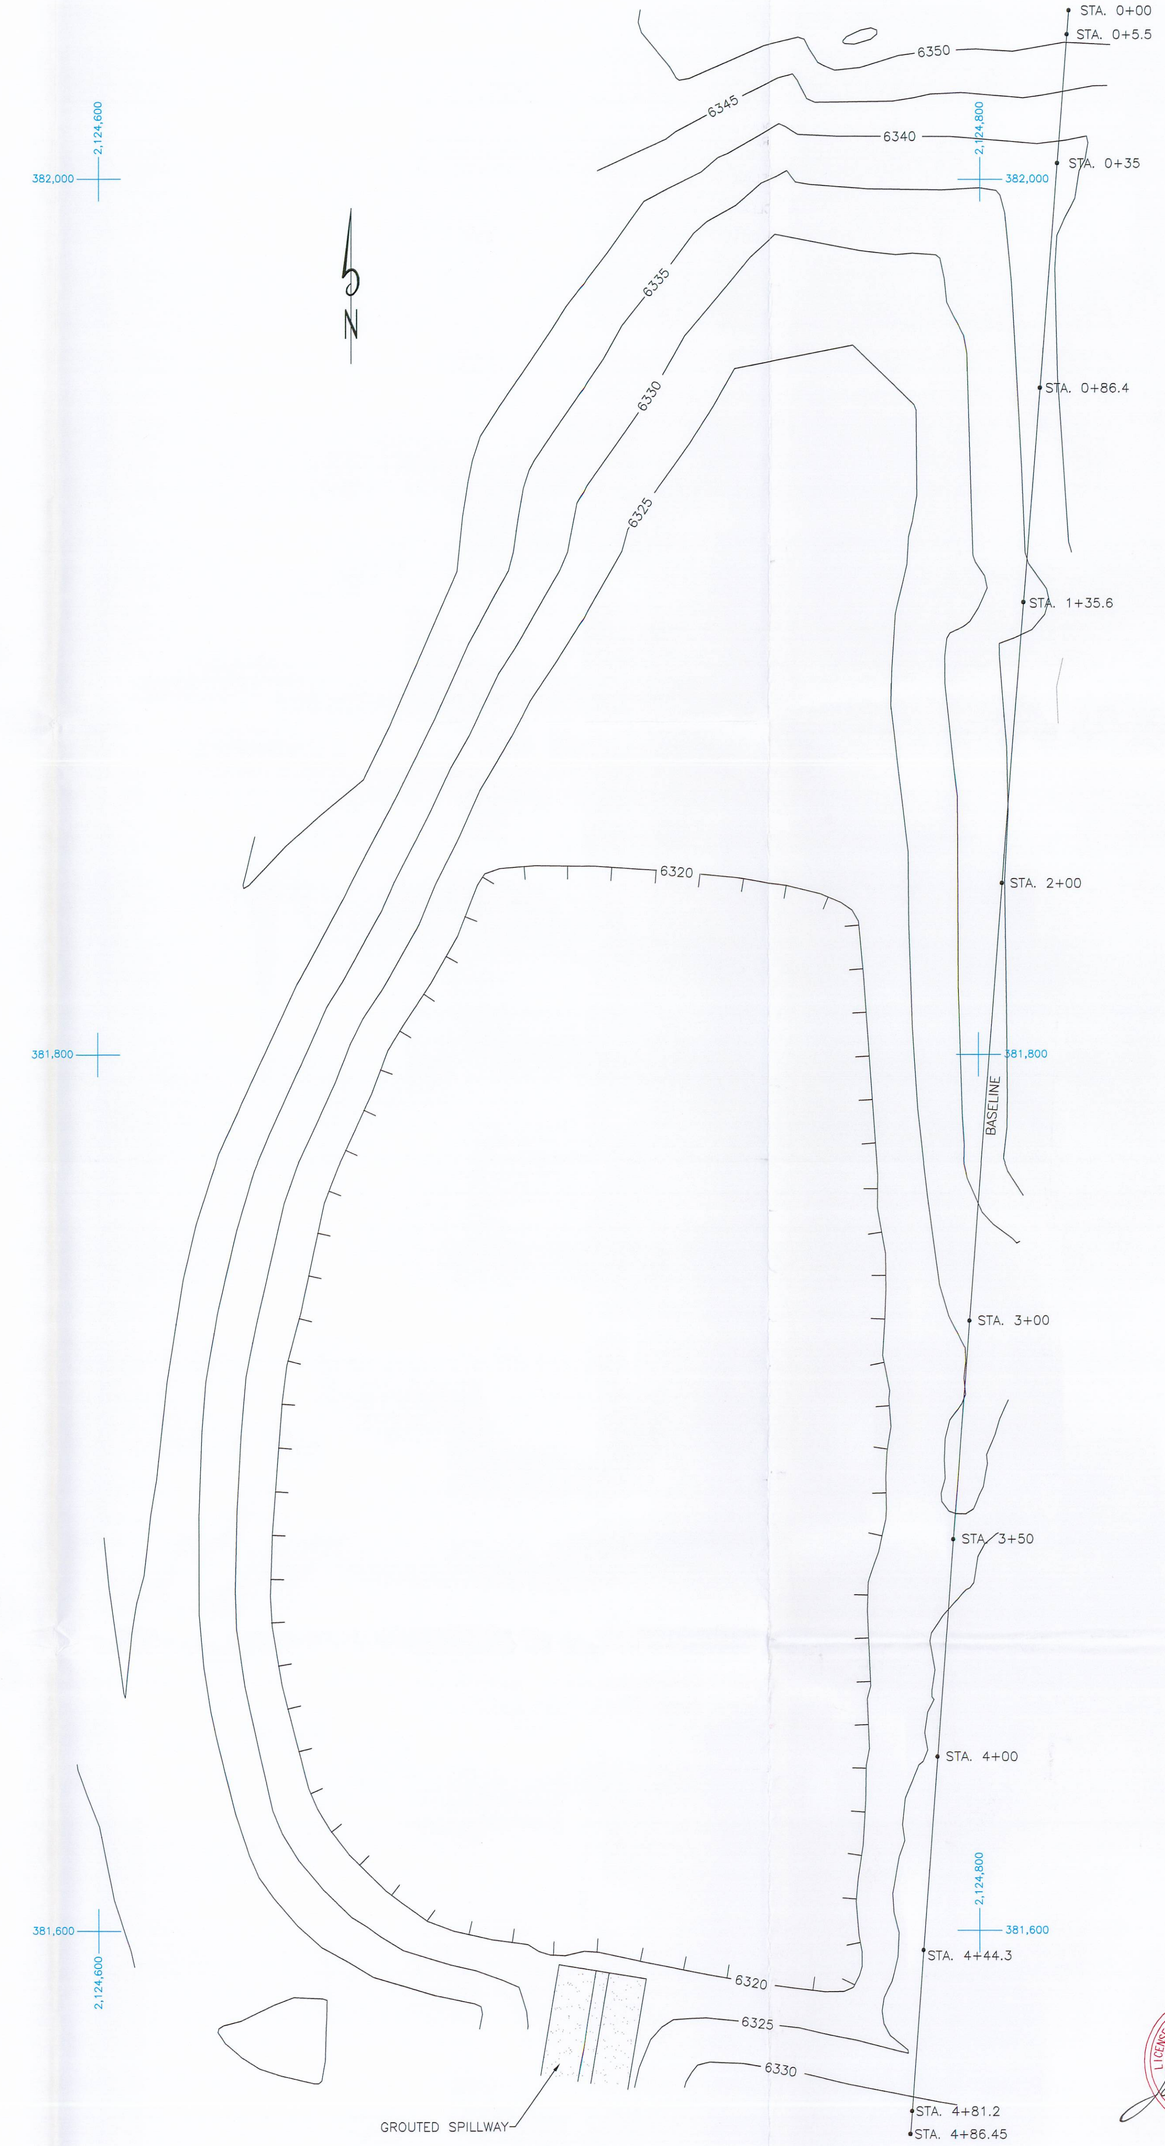

PLAN VIEW - SEDIMENTATION POND

SCALE: 1"=20'

LICENSED PROFESSIONAL ENGINEER JOHN CHRISTENSEN 11/30/07 STATE OF UTAH

RECEIVED
DEC 05 2007
DIV. OF OIL, GAS & MINING

CAD FILE NAME/DSKW: CM-10880-DR.DWG

4-11

DATE	REVISION	BY
5-14-07	REVISED TO REFLECT THE AS-BUILT CONDITIONS	KJL

ENERGY WEST MINING COMPANY
A SUBSIDIARY OF PACIFICORP

DEER CREEK MINE/WASTE ROCK STORAGE FACILITY
SEDIMENT DETENTION BASIN
PLAN VIEW AND CROSS SECTIONS

DRAWN BY: K. LARSEN
SCALE: AS NOTED
DATE: SEPT. 23, 1992
DRAWING #: CM-10880-DR
SHEET 1 OF 1
REV. ___