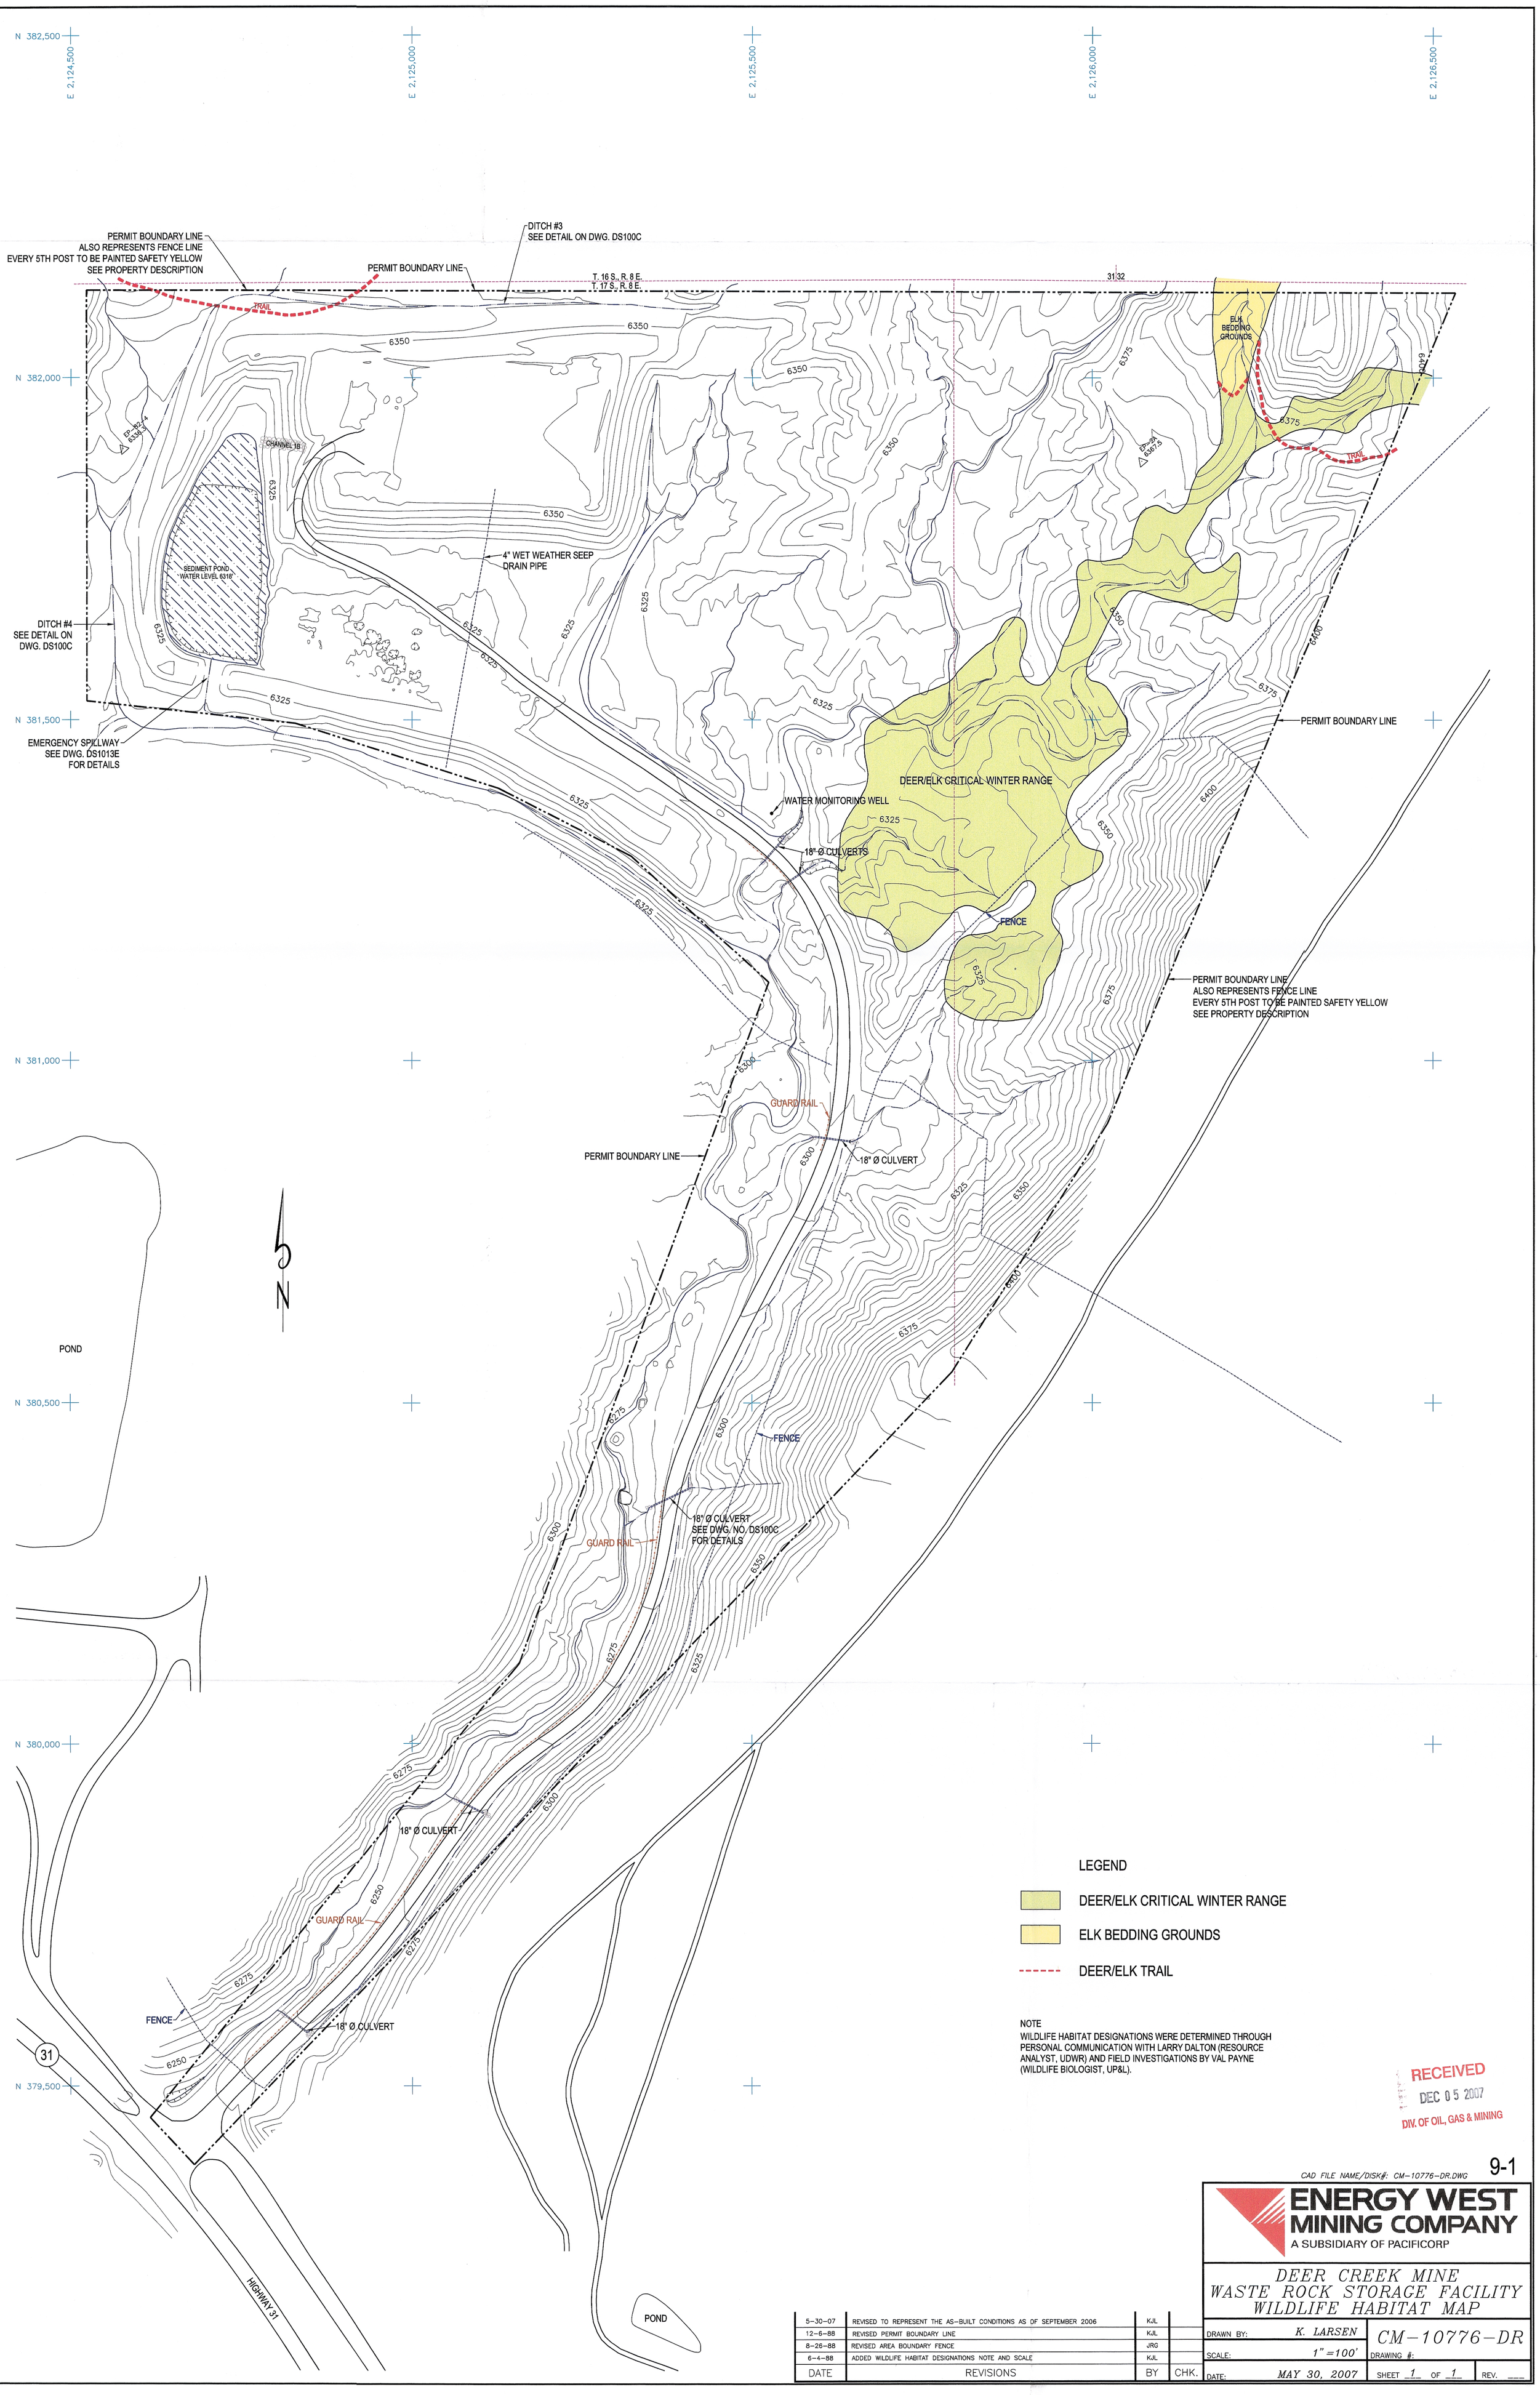

LEGEND

- DEER/ELK CRITICAL WINTER RANGE
- ELK BEDDING GROUNDS
- DEER/ELK TRAIL

NOTE
WILDLIFE HABITAT DESIGNATIONS WERE DETERMINED THROUGH PERSONAL COMMUNICATION WITH LARRY DALTON (RESOURCE ANALYST, UDWR) AND FIELD INVESTIGATIONS BY VAL PAYNE (WILDLIFE BIOLOGIST, UP&L).

RECEIVED
DEC 05 2007
DIV. OF OIL, GAS & MINING

9-1

CAD FILE NAME/DISK#: CM-10776-DR.DWG

ENERGY WEST MINING COMPANY
A SUBSIDIARY OF PACIFICORP

DEER CREEK MINE
WASTE ROCK STORAGE FACILITY
WILDLIFE HABITAT MAP

DATE	REVISIONS	BY	CHK.
5-30-07	REVISED TO REPRESENT THE AS-BUILT CONDITIONS AS OF SEPTEMBER 2006	KJL	
12-6-88	REVISED PERMIT BOUNDARY LINE	KJL	
8-26-88	REVISED AREA BOUNDARY FENCE	JRG	
6-4-88	ADDED WILDLIFE HABITAT DESIGNATIONS NOTE AND SCALE	KJL	

DRAWN BY: K. LARSEN
SCALE: 1" =100'
DATE: MAY 30, 2007
DRAWING #: CM-10776-DR
SHEET 1 OF 1
REV. ___