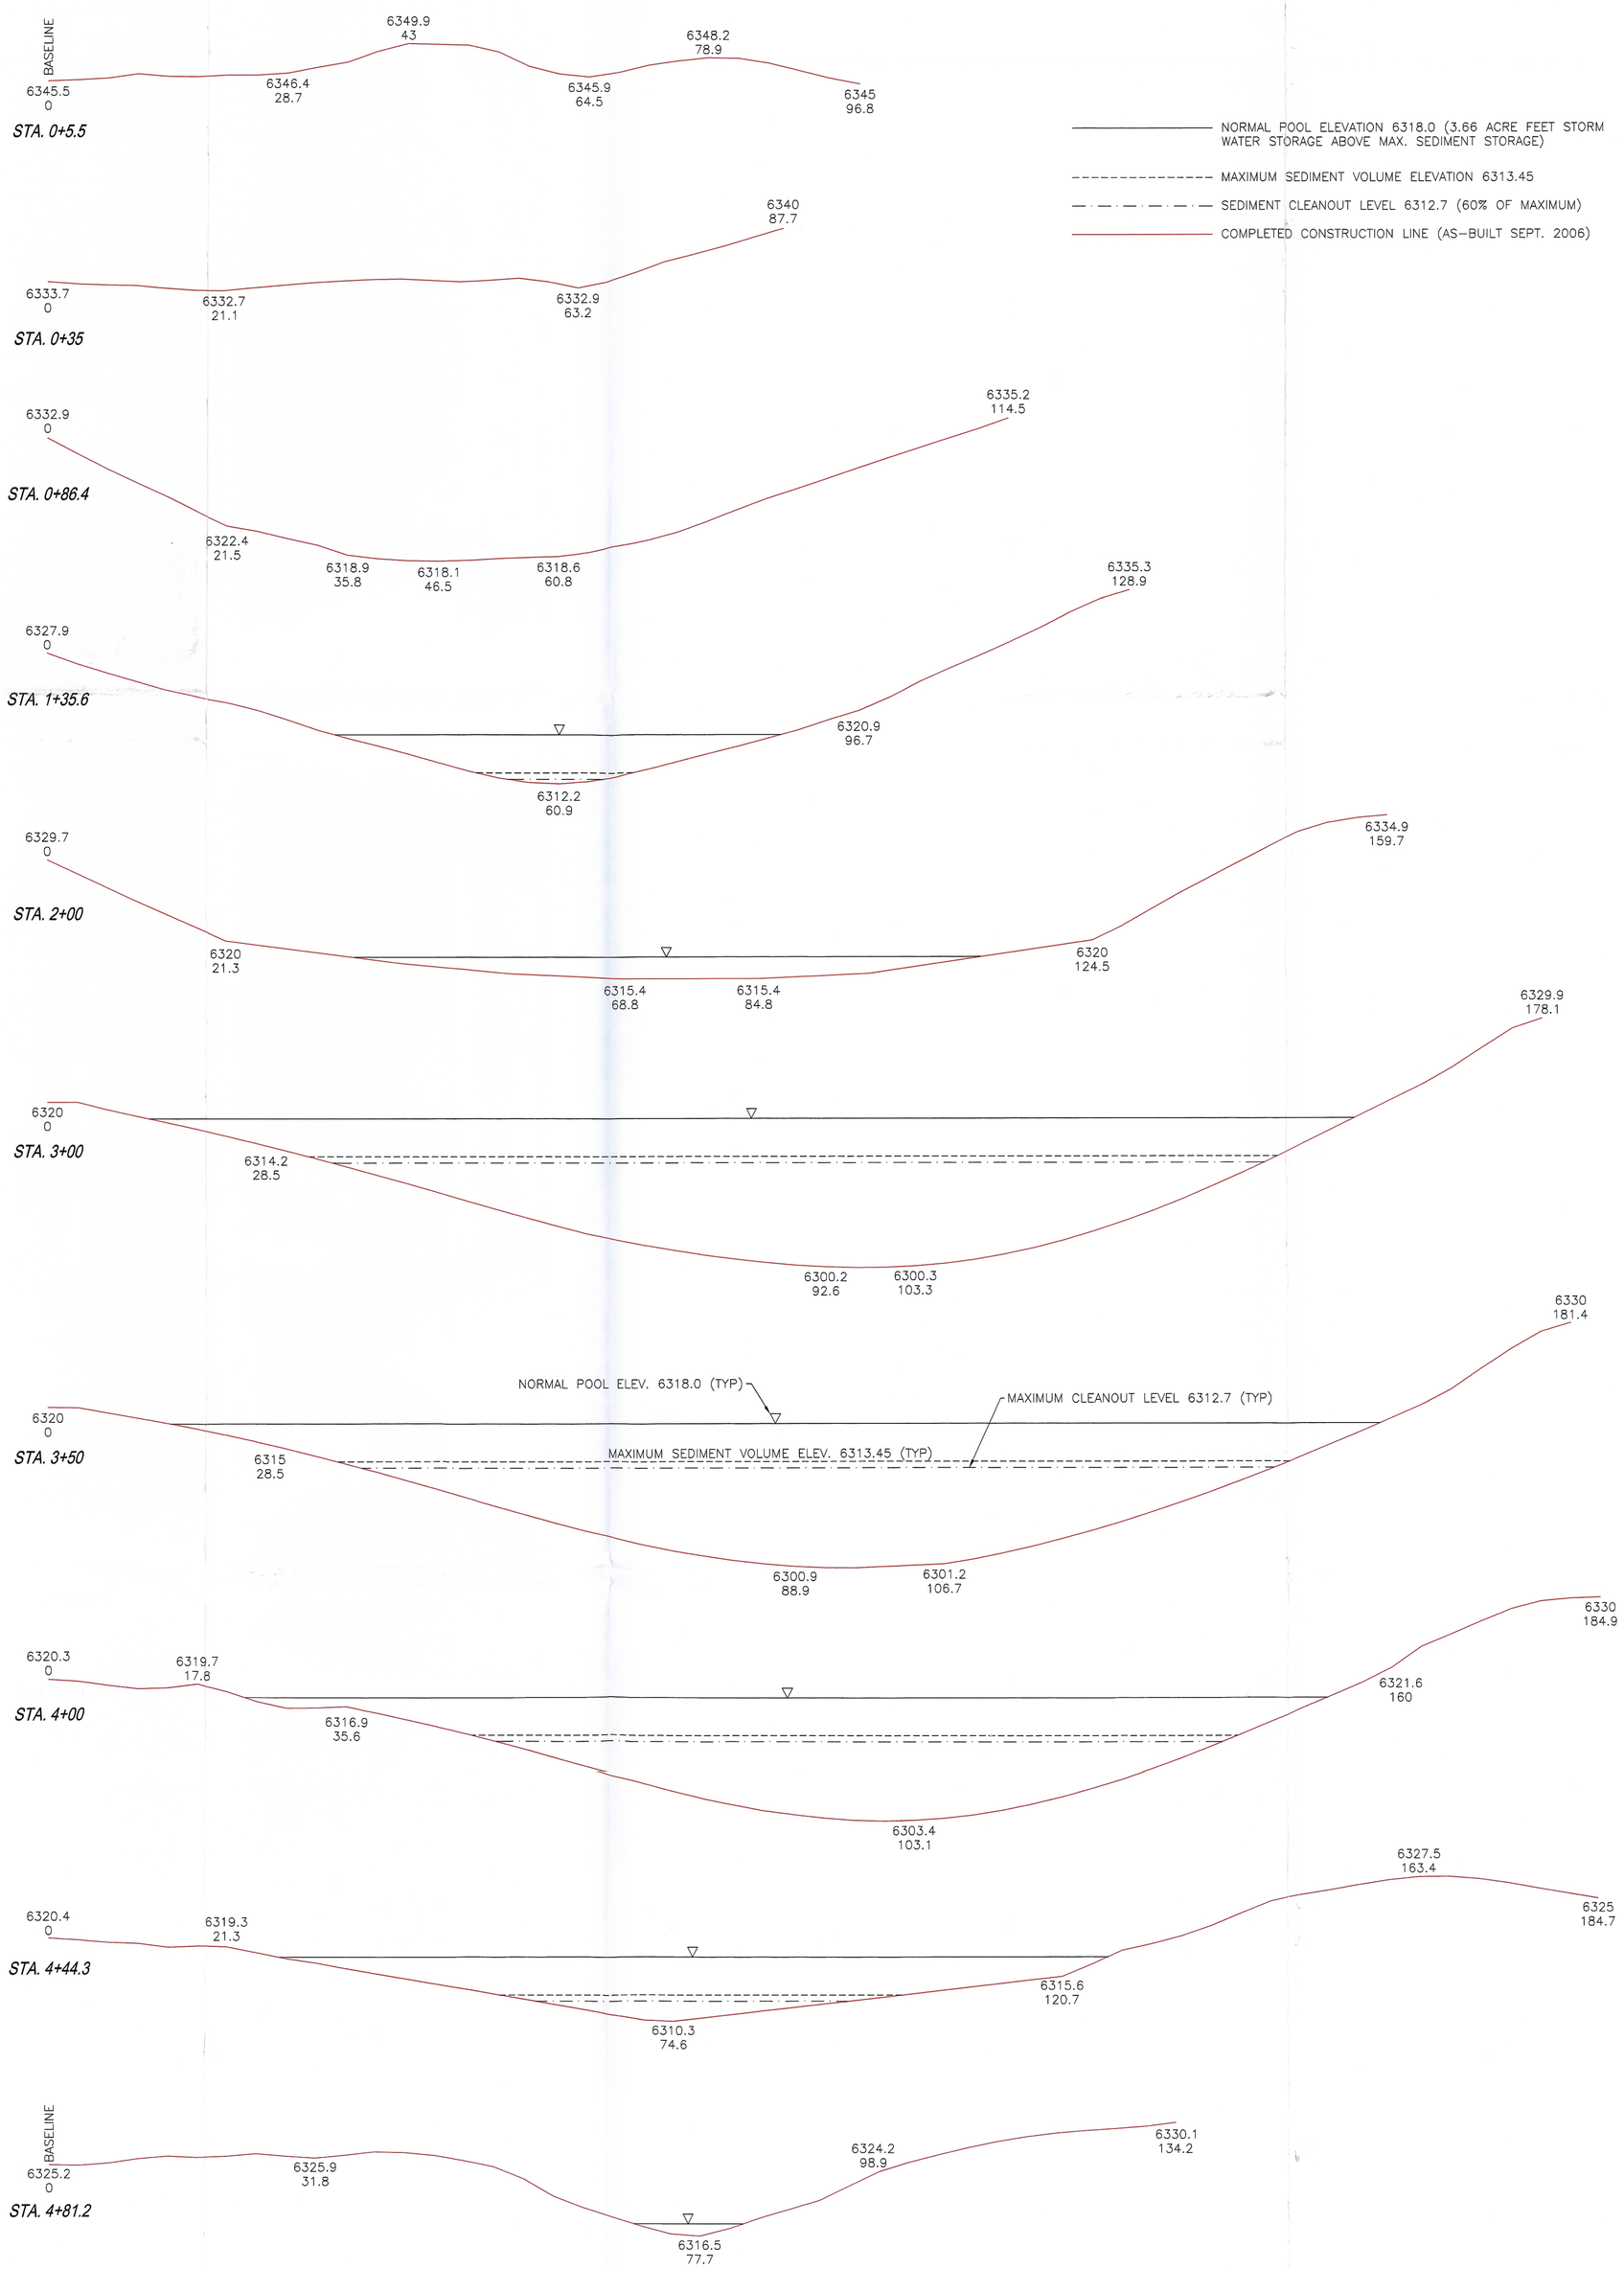

SEDIMENT BASIN - CROSS SECTIONS

SCALE: 1"=10'

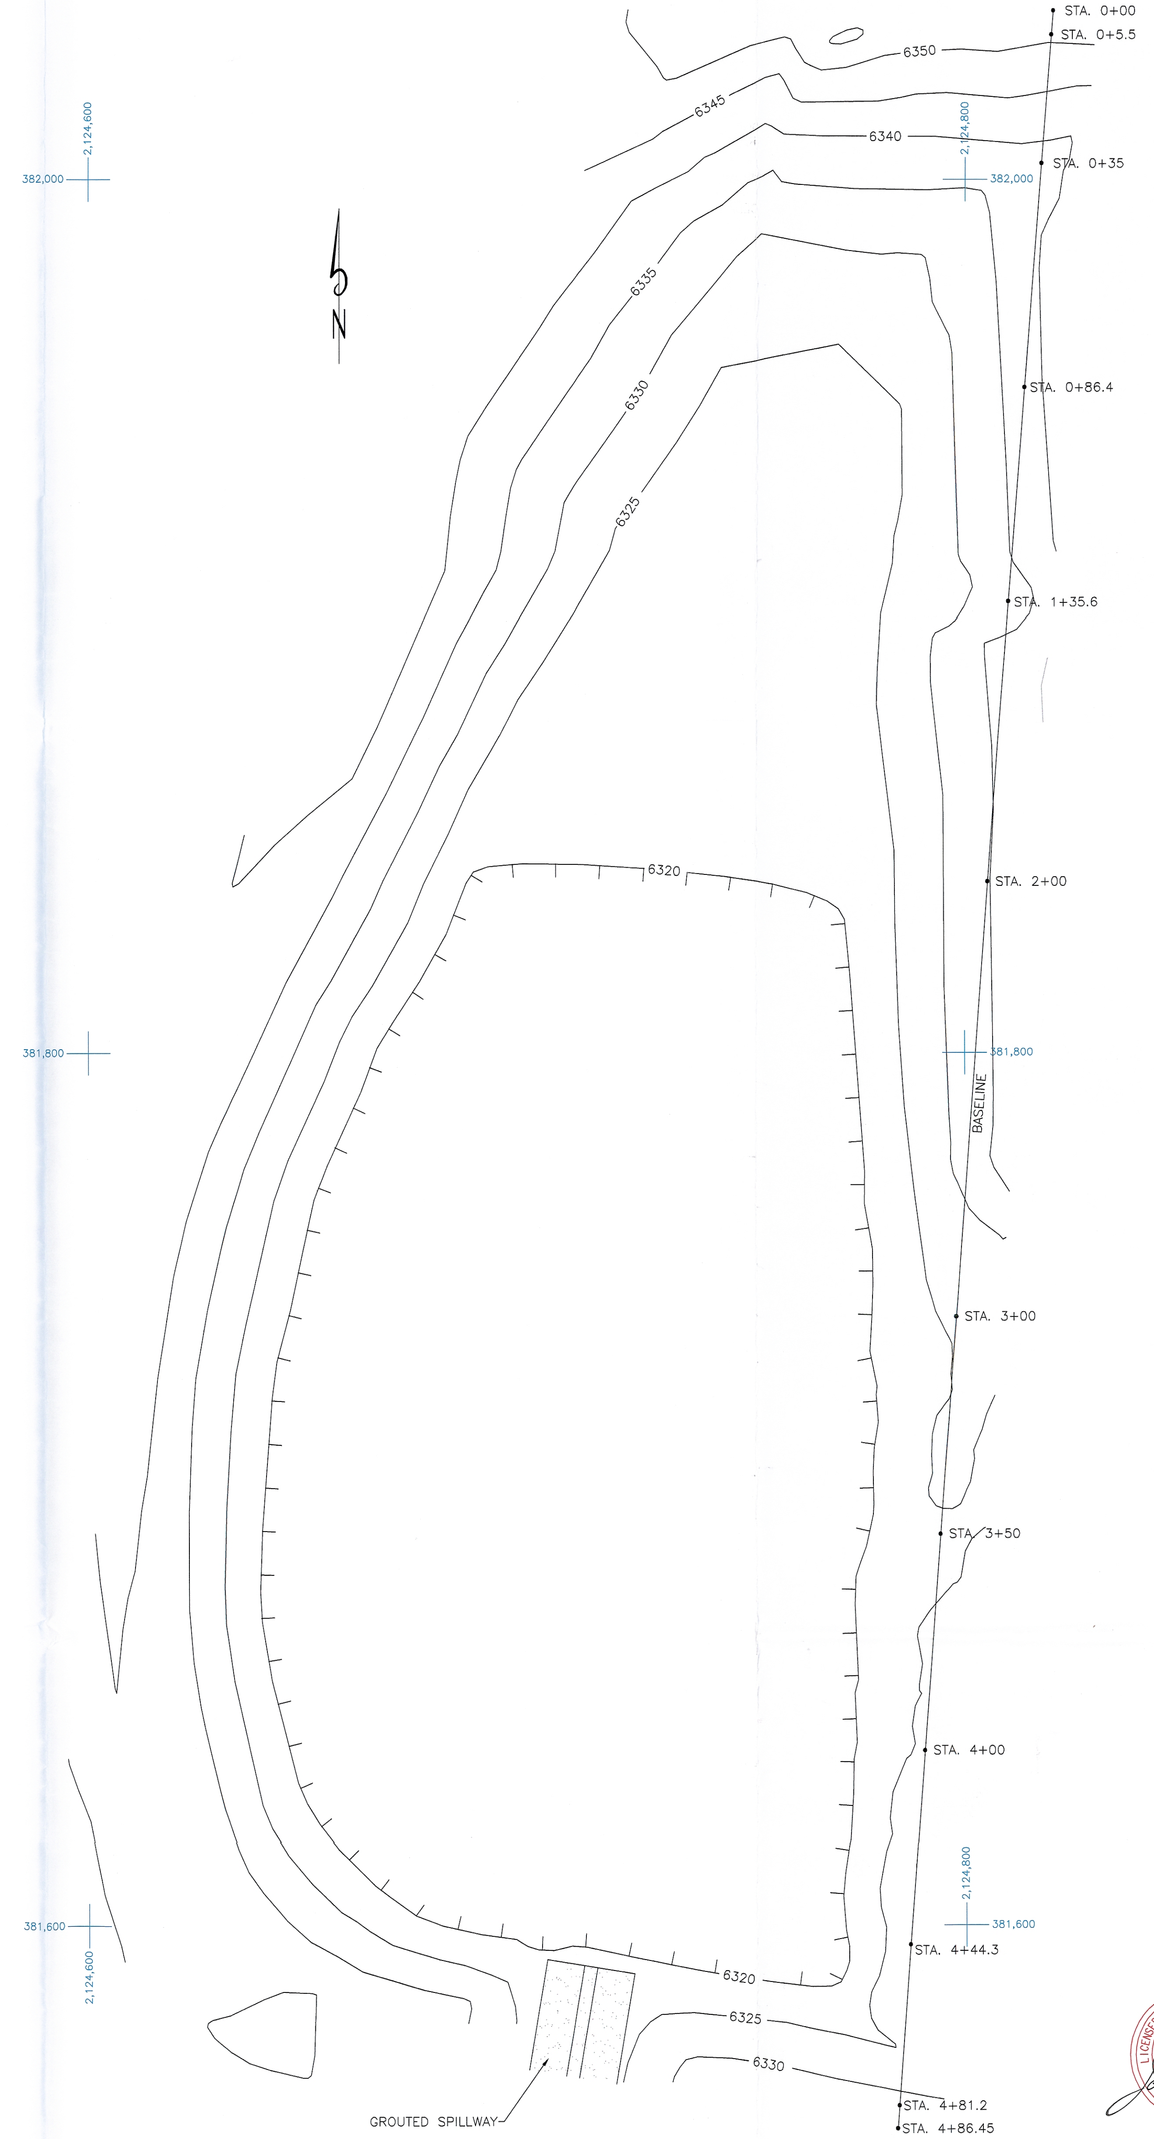

PLAN VIEW - SEDIMENTATION POND

SCALE: 1"=20'

RECEIVED
DEC 05 2007
DIV. OF OIL, GAS & MINING

CAD FILE NAME/DISK#: CM-10880-DR.DWG

4-11

ENERGY WEST MINING COMPANY
A SUBSIDIARY OF PACIFICORP

DEER CREEK MINE/WASTE ROCK STORAGE FACILITY
SEDIMENT DETENTION BASIN
PLAN VIEW AND CROSS SECTIONS

DRAWN BY:	K. LARSEN	DRAWING #:	CM-10880-DR
SCALE:	AS NOTED		
DATE:	SEPT. 23, 1992	SHEET 1 OF 1	REV.

DATE	REVISION	BY
5-14-07	REVISED TO REFLECT THE AS-BUILT CONDITIONS	KJL