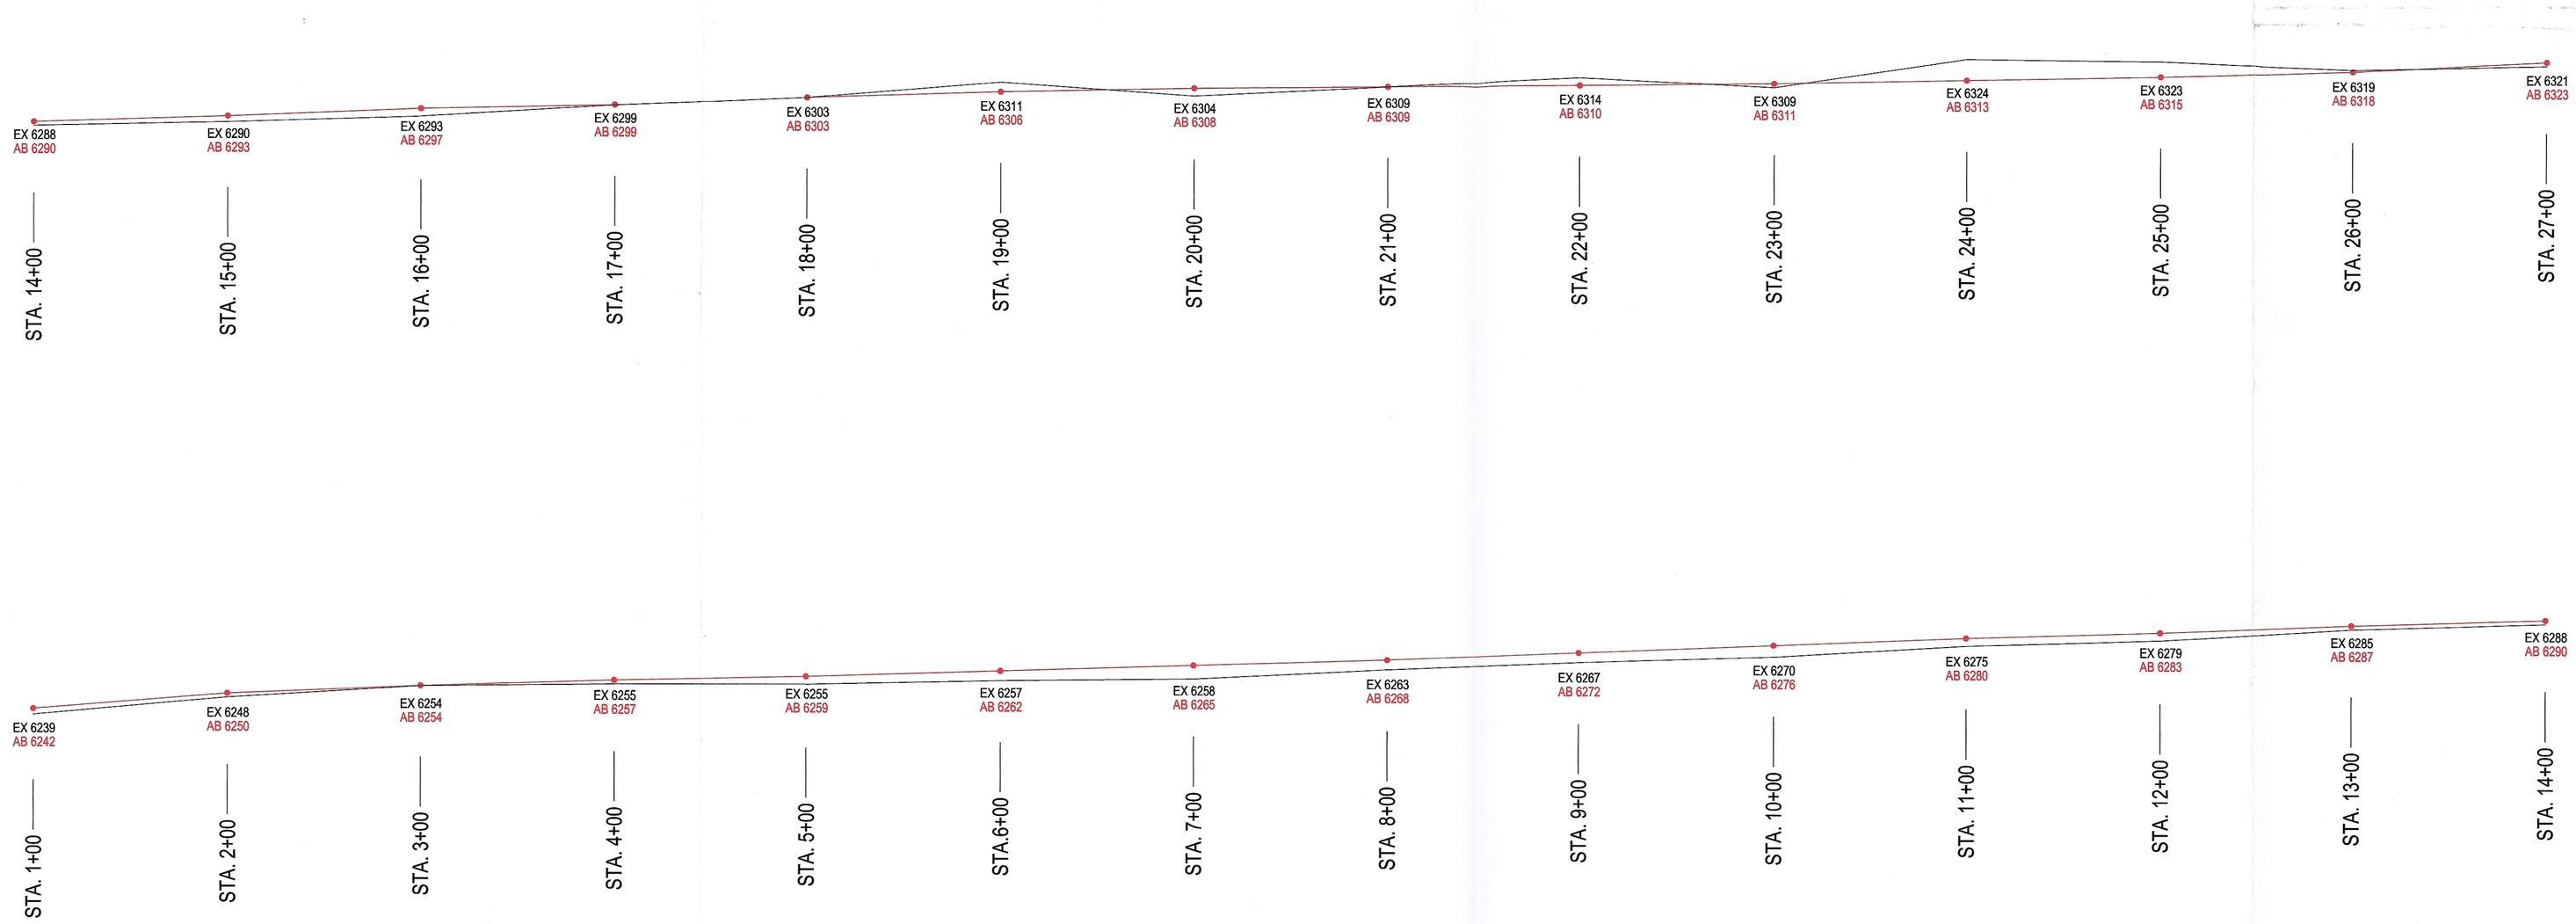

PROFILE - CENTER LINE OF ACCESS ROAD

SCALE: 1"=50'

AB = AS-BUILT GROUND LINE

EX = EXISTING GROUND LINE (PRE-CONSTRUCTION)

LICENSED PROFESSIONAL ENGINEER
JOHN CHRISTENSEN
11/30/07
No. 161554
STATE OF UTAH

RECEIVED
DEC 05 2007
DIV. OF OIL, GAS & MINING

4-2

CAD FILE NAME/DISK#: DS1012E.DWG

ENERGY WEST MINING COMPANY
A SUBSIDIARY OF PACIFICORP

DEER CREEK MINE
WASTE ROCK STORAGE FACILITY
PROFILE CENTERLINE OF ACCESS ROAD

DRAWN BY: K. LARSEN		DS1012E
SCALE: 1" =50'	DRAWING #:	
DATE: MAY 15, 2007	SHEET 1 OF 1	REV.