TYPICAL CROSS SECTION THRU WASTE ROCK STORAGE FACILITY

SCALE: 1" = 20'

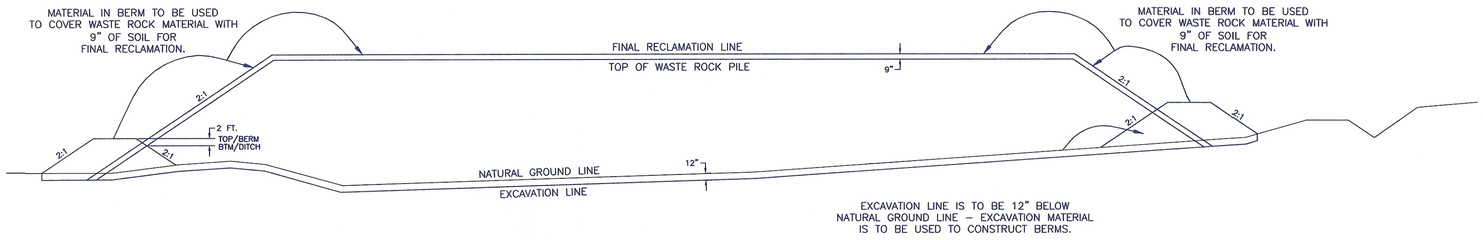

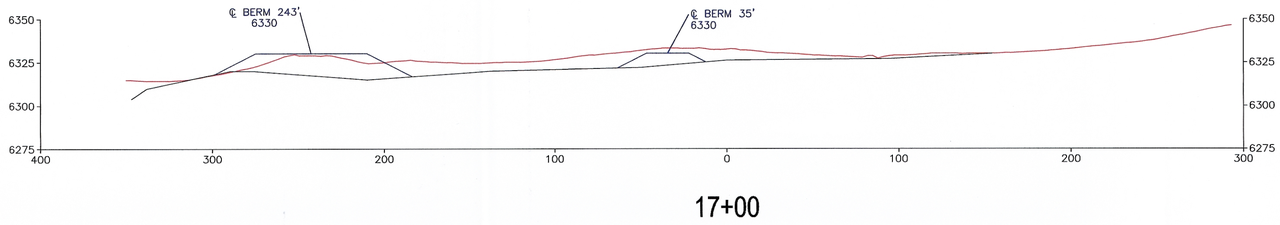

17+00

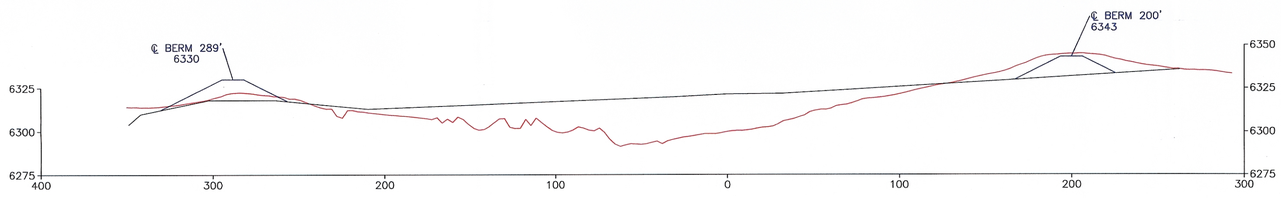

16+00

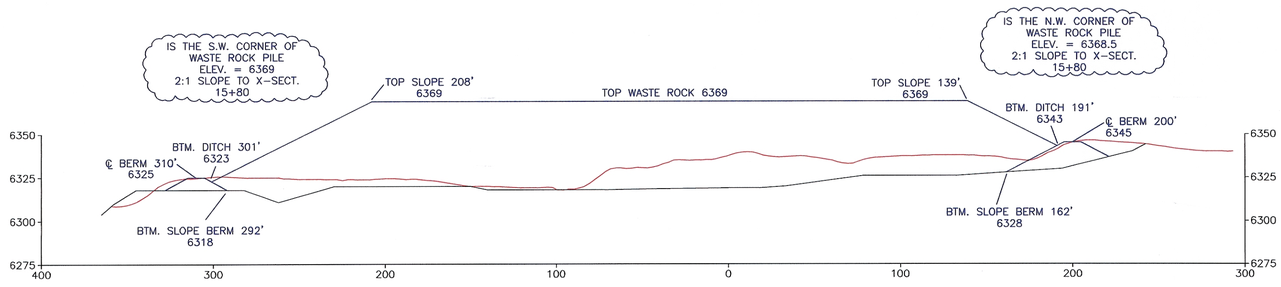

15+00

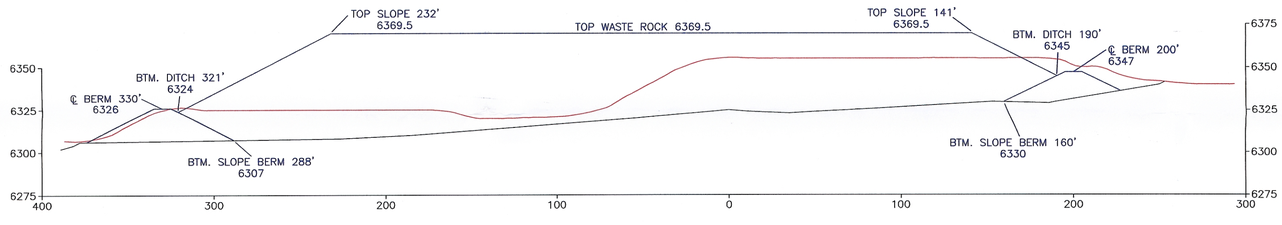

14+00

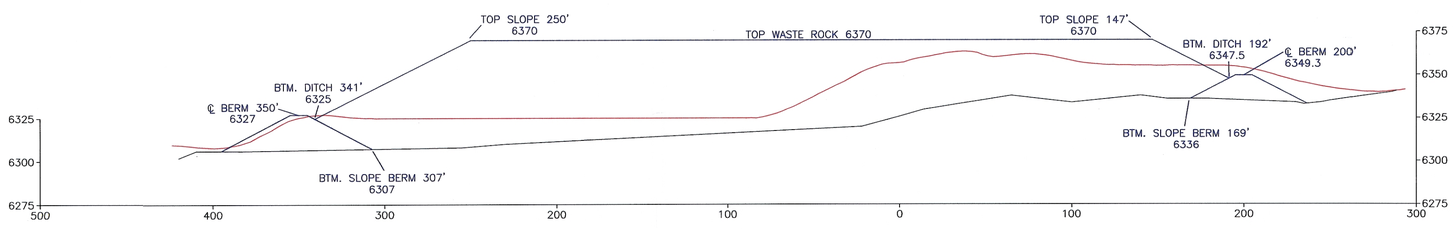

13+00

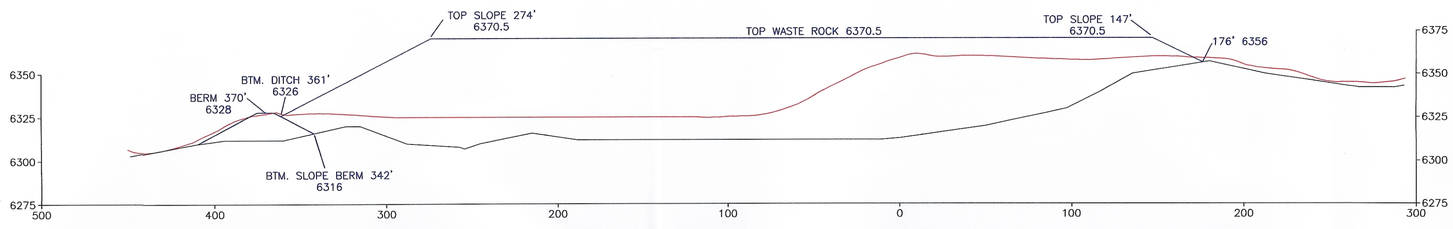

12+00

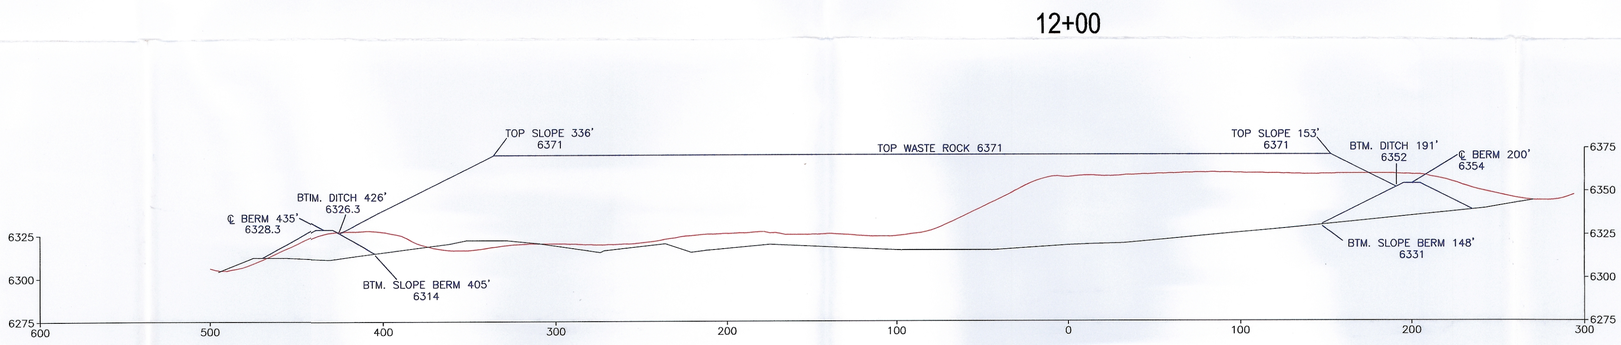

11+00

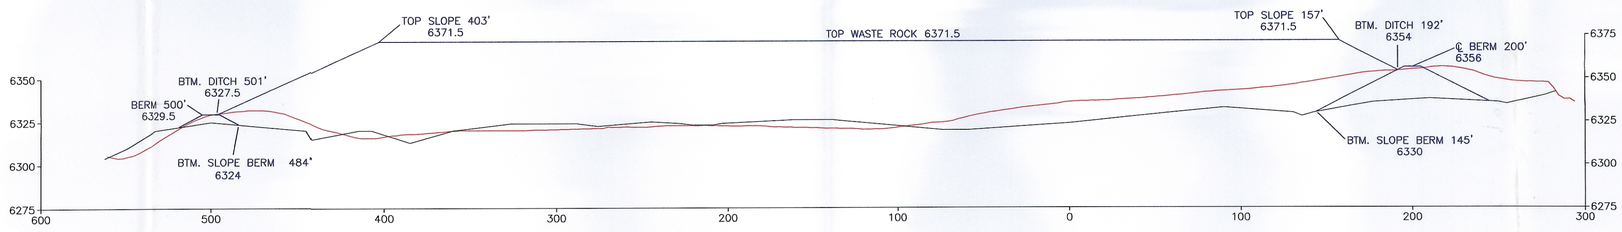

10+00

Legend

- Proposed Construction Line
- Completed Construction Line (As-Built Sept. 2006)
- Original Ground Line

NOTE:

REFER TO DRAWING CM-10778-DR FOR CROSS SECTION LOCATIONS

LICENSED PROFESSIONAL ENGINEER JOHN CHRISTENSEN 11/30/07 No. 155601 STATE OF UTAH

RECEIVED
DEC 05 2007
DIV. OF OIL, GAS & MINING

4-3

CAD FILE NAME/DISK#: DS984E.DWG

ENERGY WEST MINING COMPANY
A SUBSIDIARY OF PACIFICORP

DEER CREEK COAL MINE
CROSS SECTION THRU
WASTE ROCK STORAGE FACILITY

DRAWN BY:	K. LARSEN	DS984E	
SCALE:	1"=50'	DRAWING #:	
DATE:	MAY 18, 2007	SHEET 2 OF 2	REV.