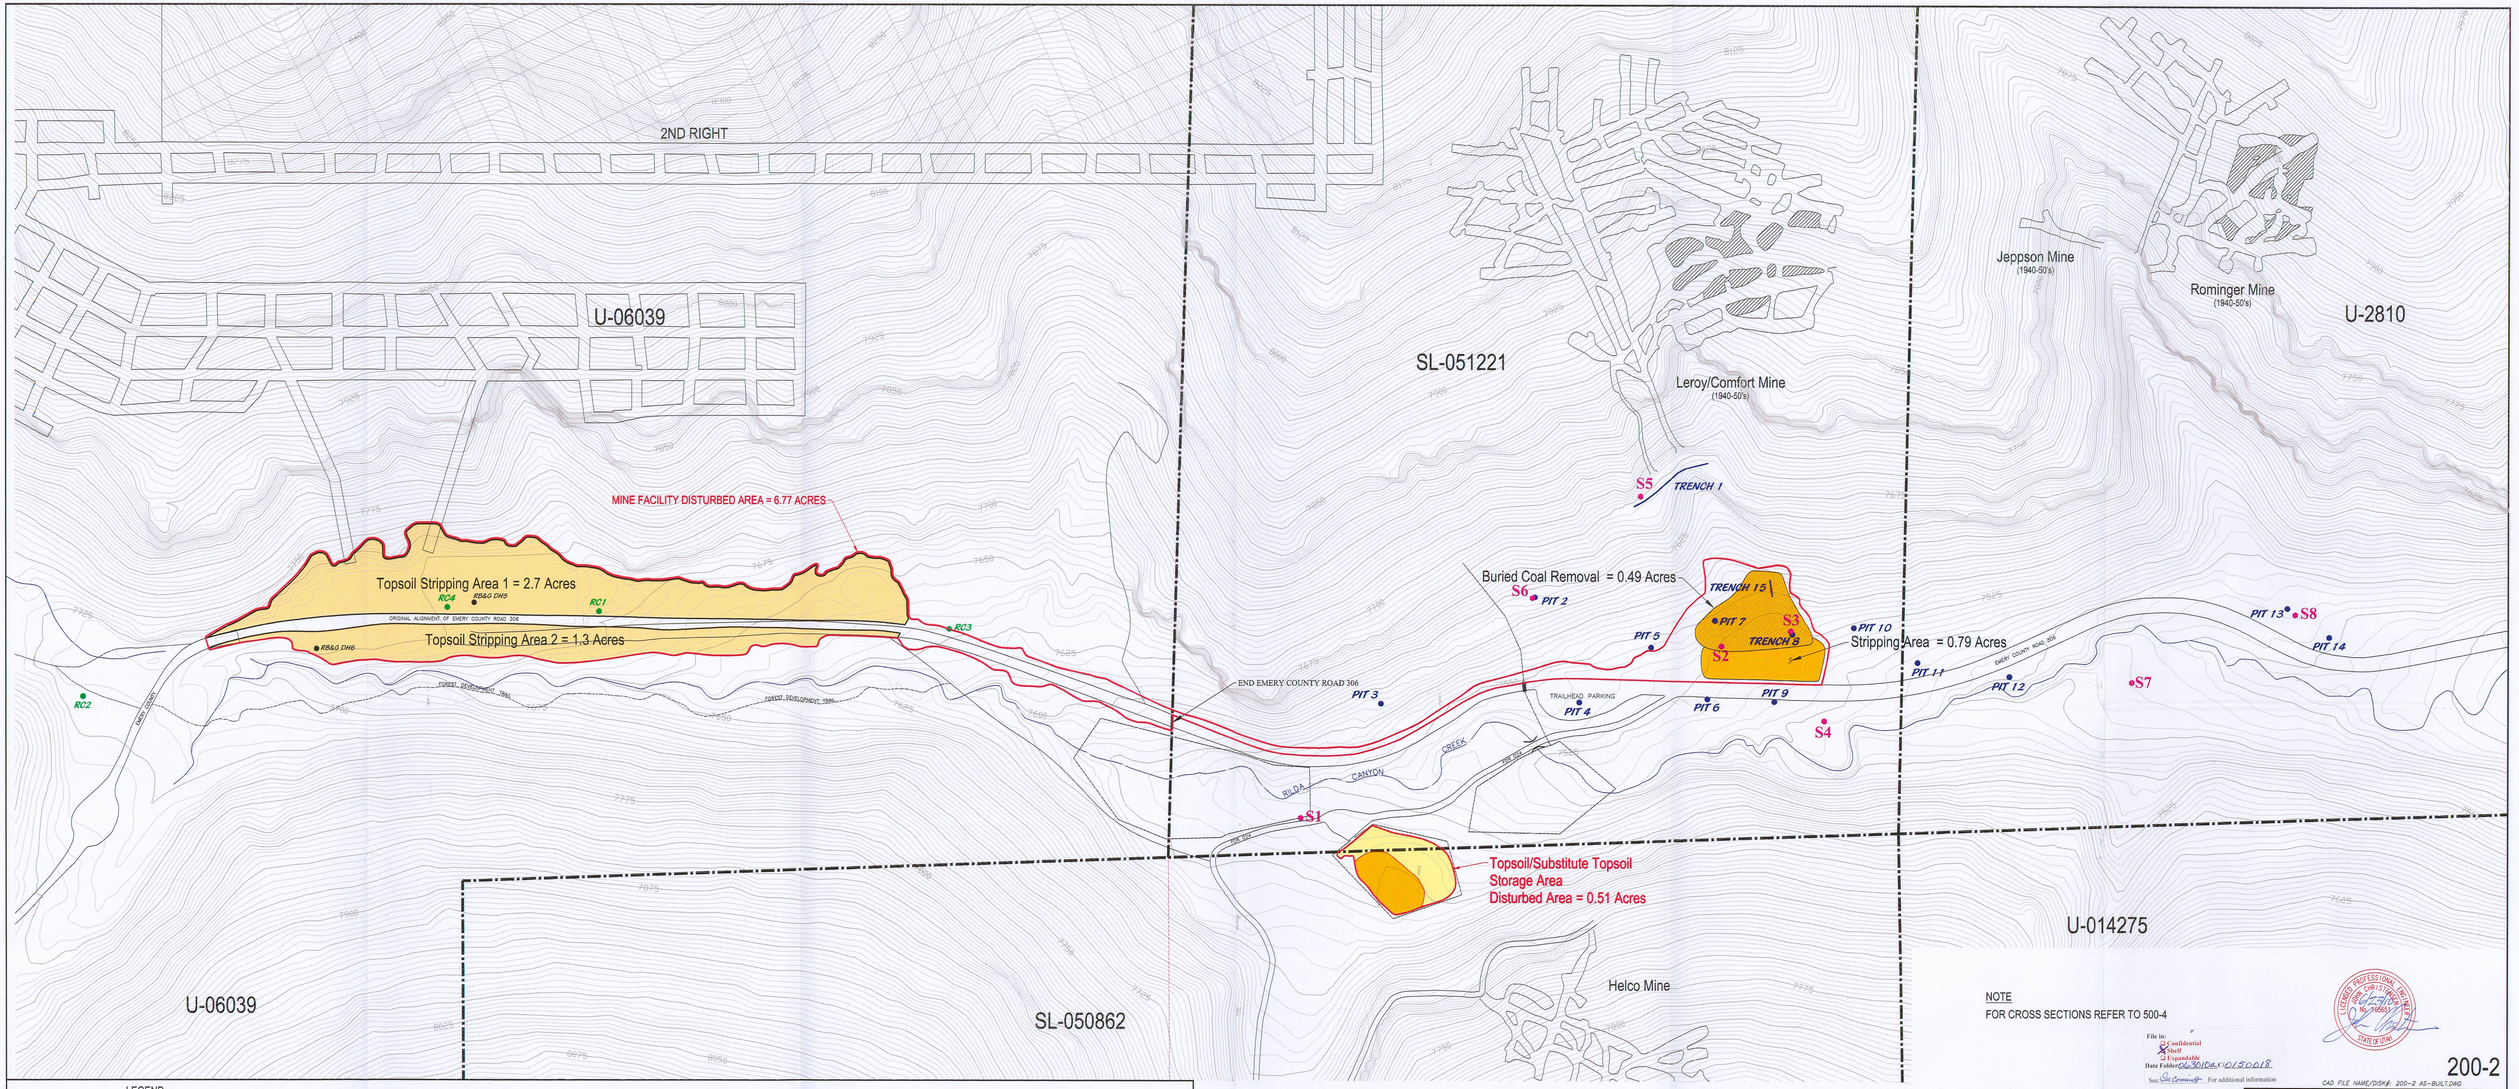

NOTE
FOR CROSS SECTIONS REFER TO 500-4

File in:
Confidential
Shelf
Expandable
Date Folder 06/30/10 & 01/50018
See: Jn Cominoy For additional information

LICENSED PROFESSIONAL ENGINEER
JOHN CHRISTENSEN
No. 7868551
STATE OF UTAH

200-2

CAD FILE NAME/DISK#: 200-2 AS-BUILT.DWG

RECEIVED
JUN 30 2010
DIV. OF OIL, GAS & MINING

LEGEND

- FEDERAL COAL LEASE
- AS-BUILT DISTURBED AREA
- TOPSOIL STRIPPING AREA
- TOPSOIL STORAGE AREA
- SUBSTITUTE TOPSOIL STRIPPING/STORAGE AREA
- BURIED COAL REMOVAL AREA (REFER TO BIOLOGY SECTION, TABLE 300-5)

SOIL & GEOTECHNICAL TESTING LOCATIONS

RB&G DH6 SEISMIC LINE S7	RB&G 1991 (1)	(1)	RB&G Rilda Canyon Facilities, Geotechnical Investigation, Refer to Volume 11 Appendix Volume - Engineering
S2	EIS 2003-2004 (2)	(2)	EIS Environmental and Engineering Consulting, Soil Survey, Refer to Volume 11 Appendix Volume - Soils
SEISMIC LINE 1 PIT 7	AMEC 2004 (3)	(3)	AMEC, Geotechnical Investigation, Refer to Volume 11 Appendix Volume - Engineering
RC3	MT. NEBO 2004 (4)	(4)	MT. NEBO, Soil Survey, Refer to Volume 11 Appendix Volume - Soils

DATE	REVISION	BY	CHK
2/4/2010	ADDED AS-BUILT DISTURBED AREA BOUNDARY AND REVISED TOPSOIL/SUBSTITUTE TOPSOIL NOTATIONS	KJL	

ENERGY WEST MINING COMPANY
A SUBSIDIARY OF PACIFICORP

DEER CREEK MINE
RILDA CANYON FACILITIES
SOIL STRIPPING & STORAGE LOCATION MAP

DRAWN BY: K. LARSEN
SCALE: 1" = 100'
DATE: JUNE 16, 2009
DRAWING #: 200-2
SHEET 1 OF 1
REV. 1