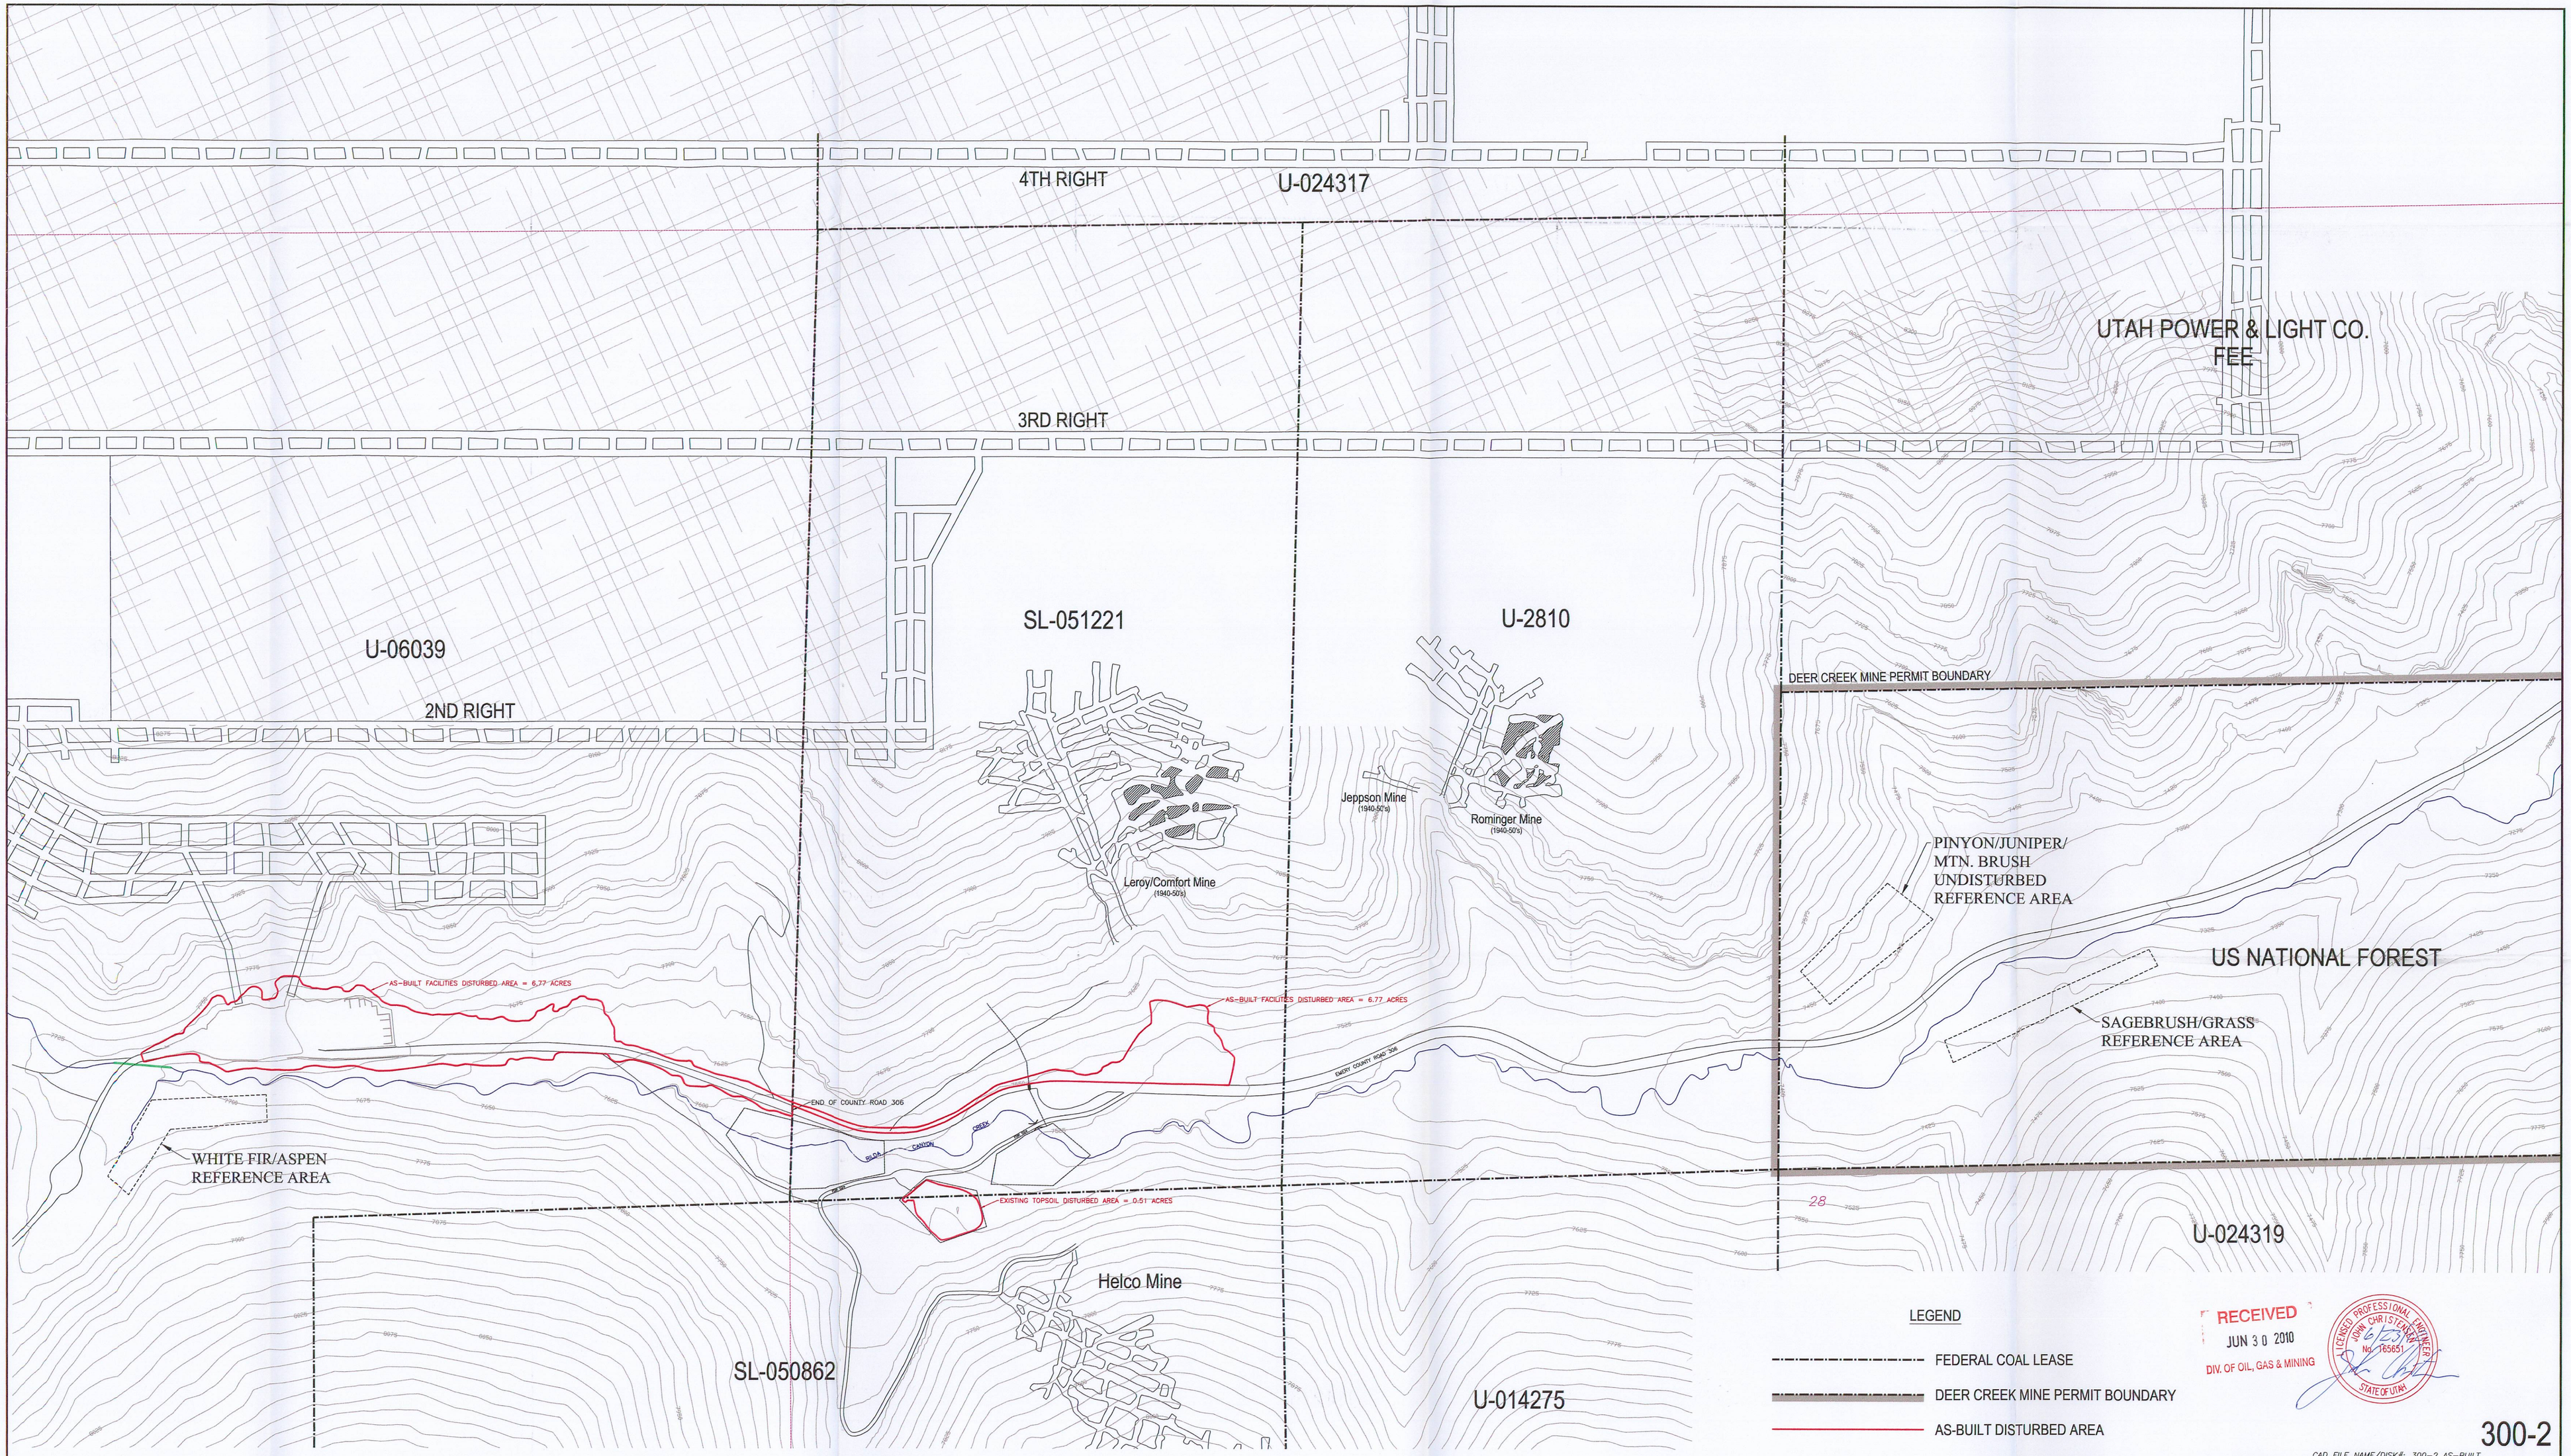

RECEIVED
JUN 30 2010
DIV. OF OIL, GAS & MINING

LICENSED PROFESSIONAL ENGINEER
JOHN CHRISTENSEN
No. 165651
STATE OF UTAH

300-2

CAD FILE NAME/DISK#: 300-2 AS-BUILT

ENERGY WEST MINING COMPANY
A SUBSIDIARY OF PACIFICORP

DEER CREEK MINE
RILDA CANYON FACILITIES
VEGETATION REFERENCE AREAS

DATE	REVISION	BY	CHK
2/4/2010	ADDED AS-BUILT DISTURBED AREA BOUNDARY AND FENCE AROUND TOPSOIL PILE	KJL	

DRAWN BY: K. LARSEN
SCALE: 1" =200'
DATE: JUNE 16, 2009
DRAWING #: 300-2
SHEET 1 OF 1
REV. 1

File in:
☐ Confidential
☒ Shelf
☐ Expandable
Date Folded: 06 30 10 a C1 0150018
Sec. Jim Cornish For additional information