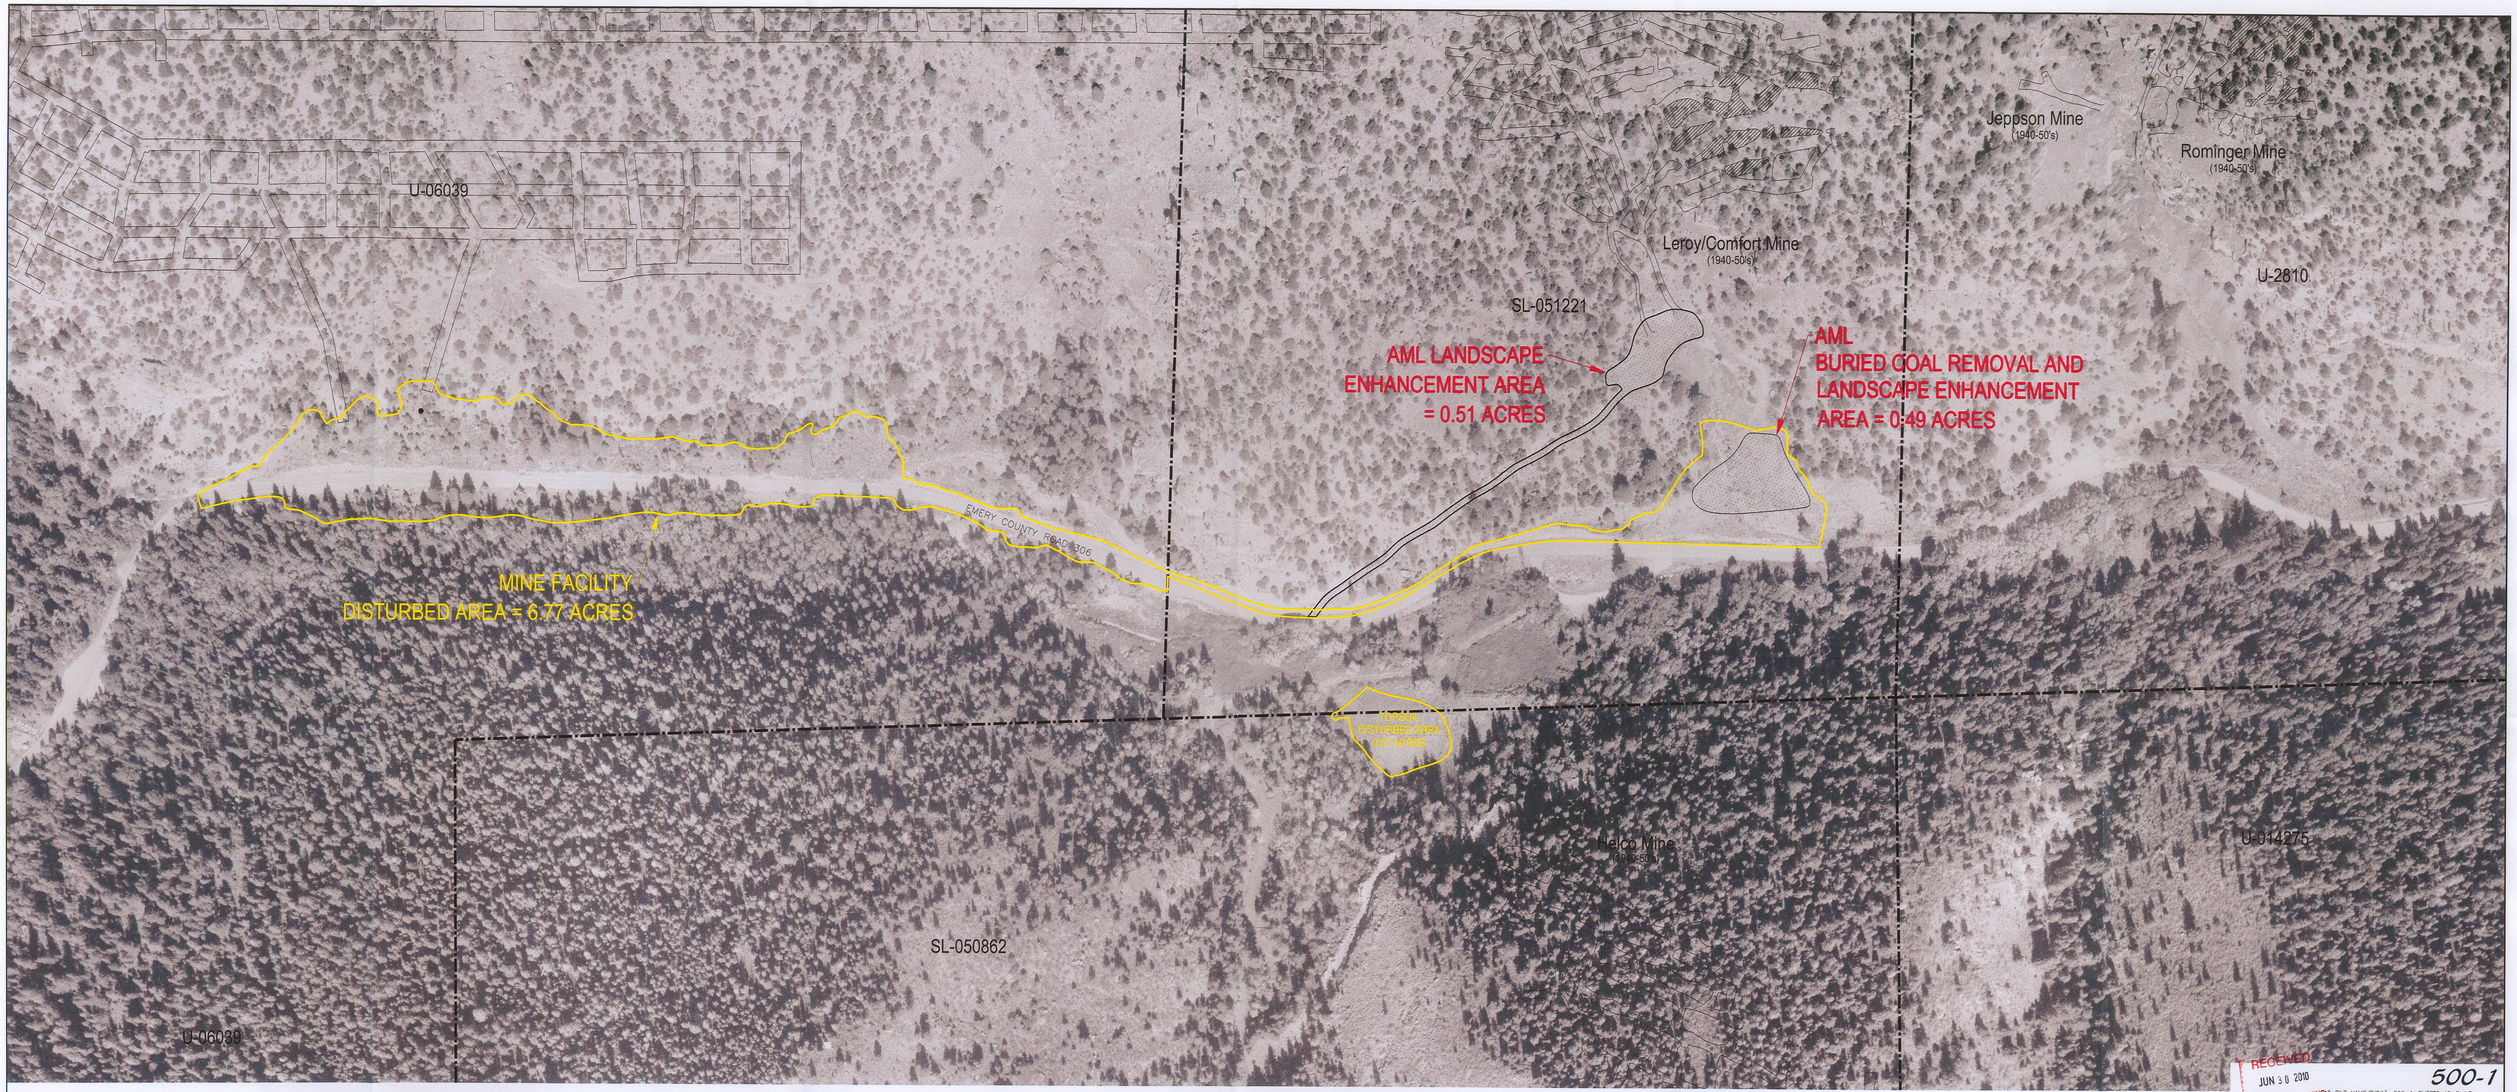

RECEIVED
JUN 30 2010
DIV. OF OIL, GAS & MINING

500-1

CAD FILE NAME/DISK#: 500-1-SHEET2 AS-BUILT

ENERGY WEST MINING COMPANY
A SUBSIDIARY OF PACIFICORP

DEER CREEK MINE
RILDA CANYON
PRE-DISTURBANCE AERIAL

DRAWN BY:	K. LARSEN	500-1	
SCALE:	1" = 100'	DRAWING #:	
DATE:	APRIL 16, 2010	SHEET 2 OF 3	REV. 1

DATE	REVISION	BY	CHK
2/4/2010	ADDED AS-BUILT DISTURBED AREA BOUNDARY AND AML LANDSCAPE ENHANCEMENT AREAS	KJL	

File in:
☐ Confidential
☒ Shelf
☐ Expandable
Date Folder 0630108 0150018
cc: [signature] For additional information

LICENSED PROFESSIONAL ENGINEER
JOHN CHRISTENSEN
No. 165841
STATE OF UTAH