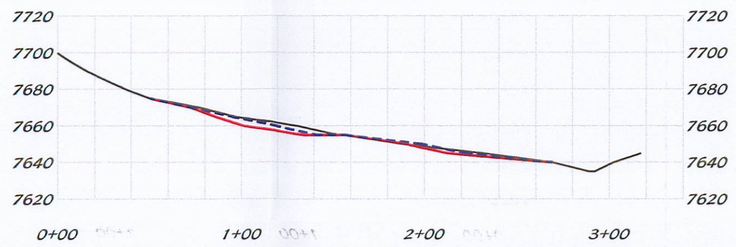

9+50

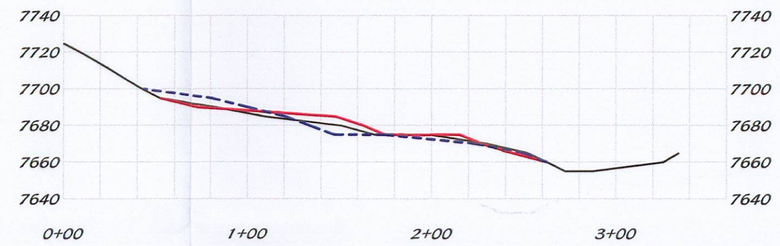

7+00

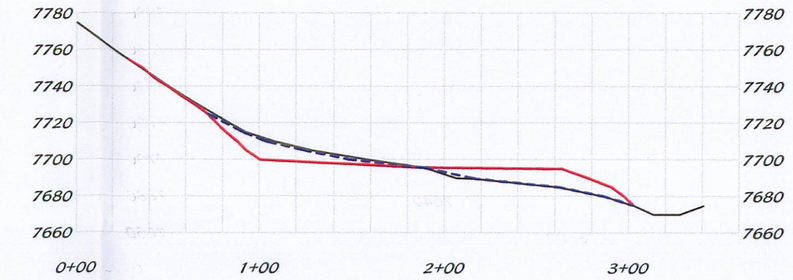

4+50

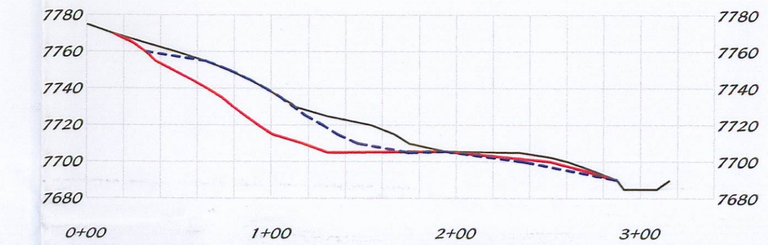

2+00

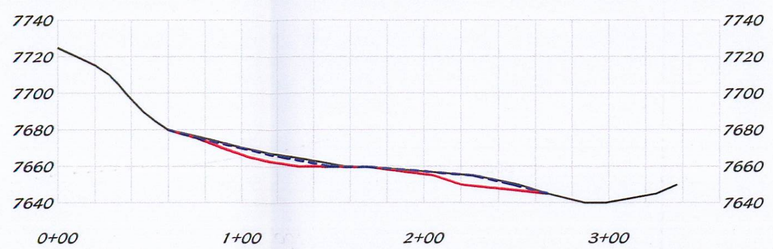

9+00

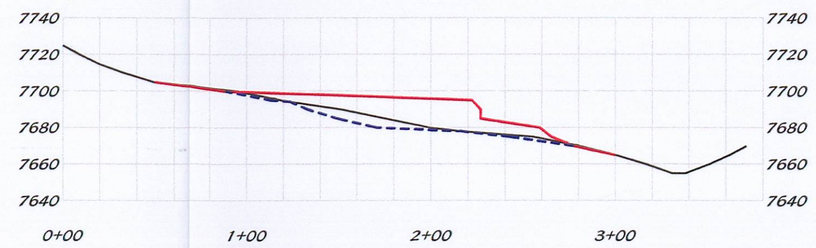

6+50

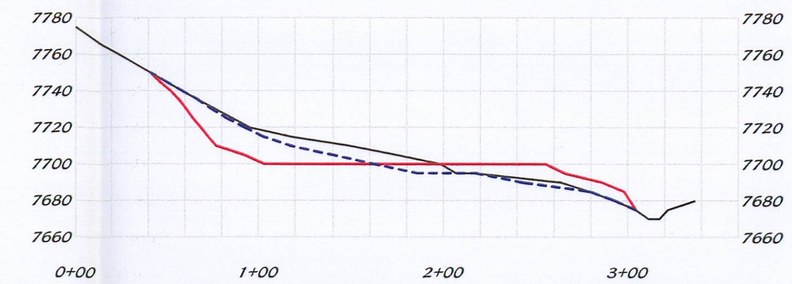

4+00

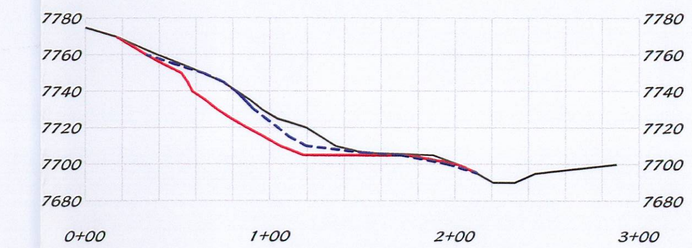

1+50

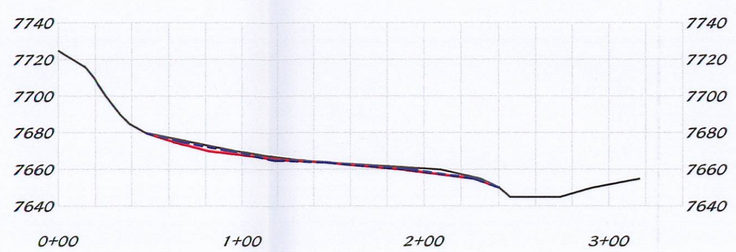

8+50

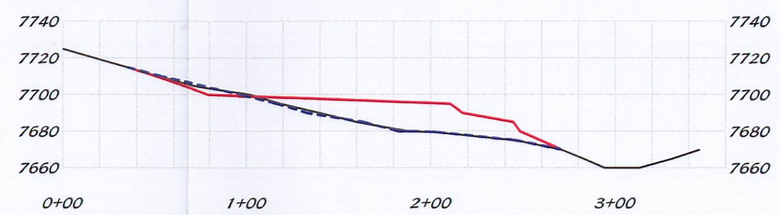

6+00

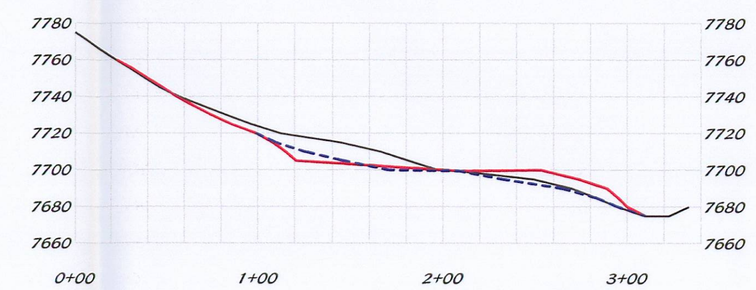

3+50

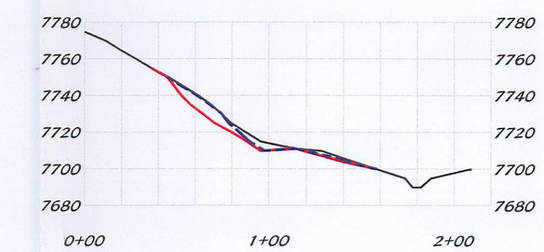

1+00

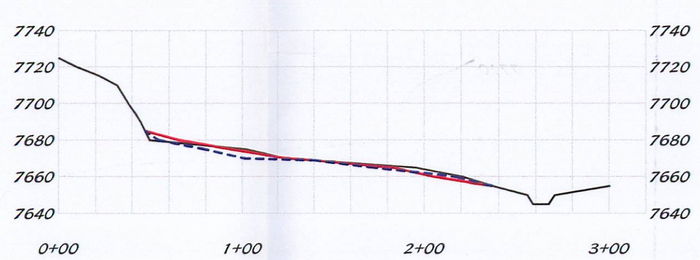

8+00

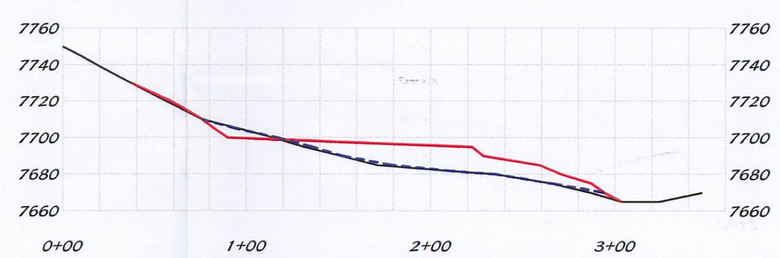

5+50

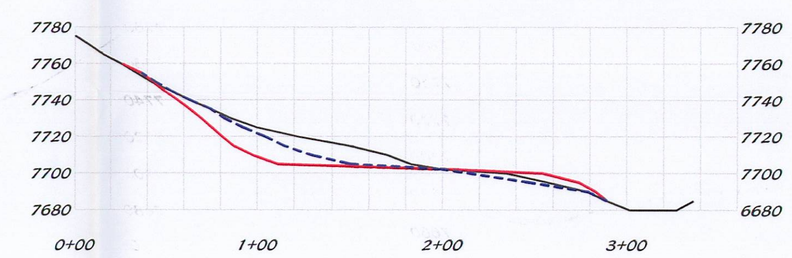

3+00

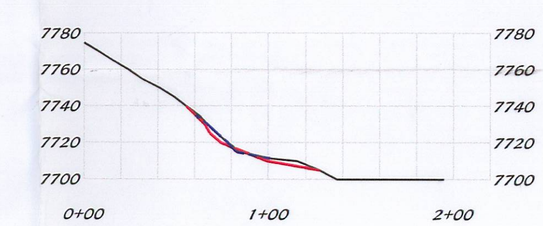

0+50

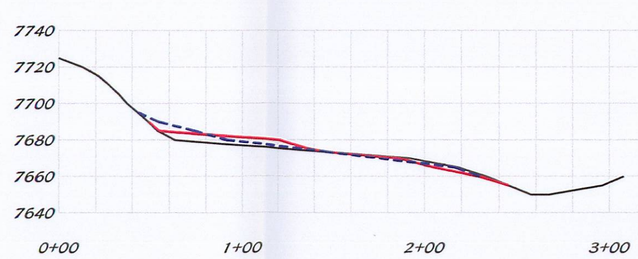

7+50

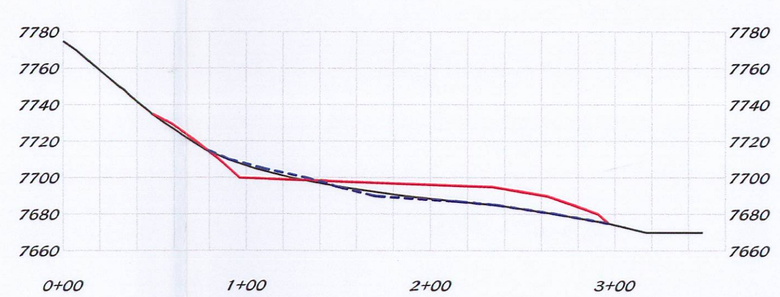

5+00

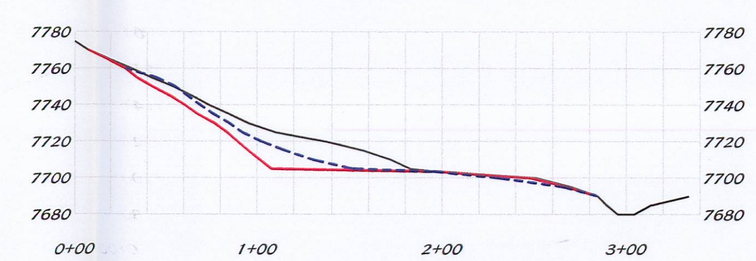

2+50

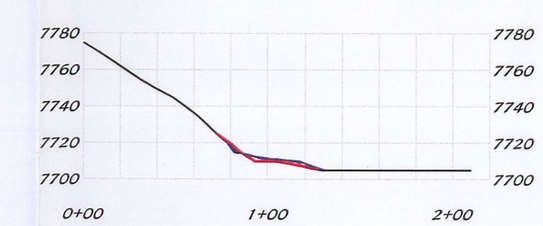

0+00

RECEIVED
JUN 30 2010
DIV. OF OIL, GAS & MINING

500-4

CAD FILE NAME/DISK#: 500-4 AS-BUILT

ENERGY WEST MINING COMPANY
A SUBSIDIARY OF PACIFICORP

DEER CREEK MINE
RILDA CANYON FACILITIES
CROSS SECTIONS

DATE	REVISION	BY	CHK
2/19/2010	REVISED TO REFLECT THE AS-BUILT CONDITIONS	KJL	

DRAWN BY: K. LARSEN
SCALE: 1"=60'
DATE: MARCH 25, 2009
DRAWING #: 500-4
SHEET 1 OF 4
REV. 1

File in:
☐ Confidential
☒ Shelf
☐ Expandable
Date Folder 06301OA C0150018
See Screening For additional information

LICENSED PROFESSIONAL ENGINEER
JOHN CHRISTENSEN
No. 185651
STATE OF UTAH

NOTES

1. CROSS SECTIONS REFERENCE FROM 500-3
2. REFER TO VOLUME 11 APPENDIX VOLUME ENGINEERING APPENDIX F FOR SLOPE STABILITY ANALYSIS

LEGEND

PRE-EXISTING LINE
POST CONSTRUCTION LINE
FINAL RECLAMATION LINE