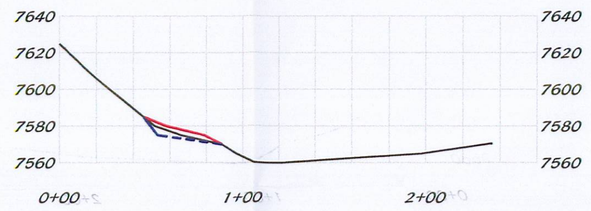

19+50

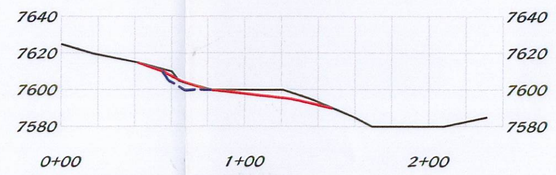

17+00

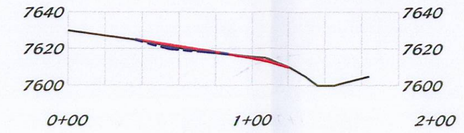

14+50

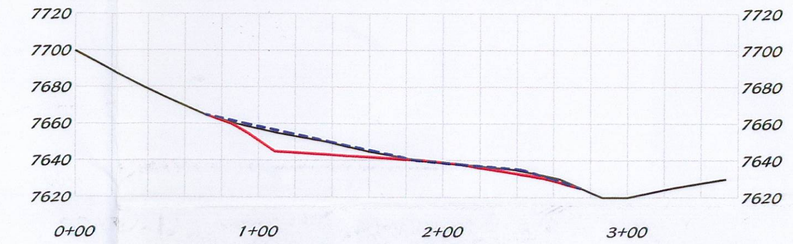

12+00

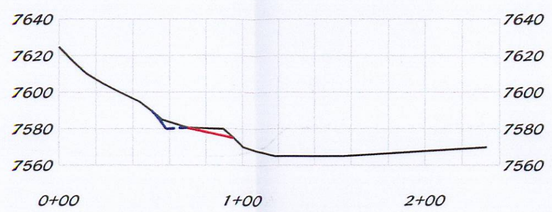

19+00

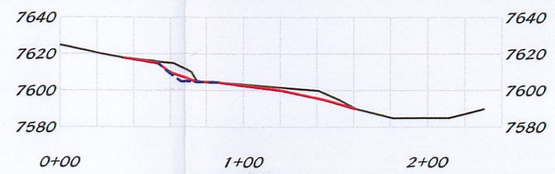

16+50

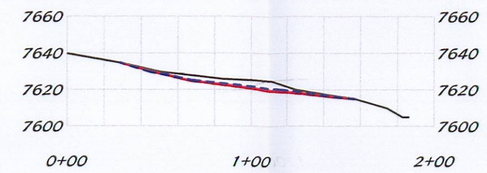

14+00

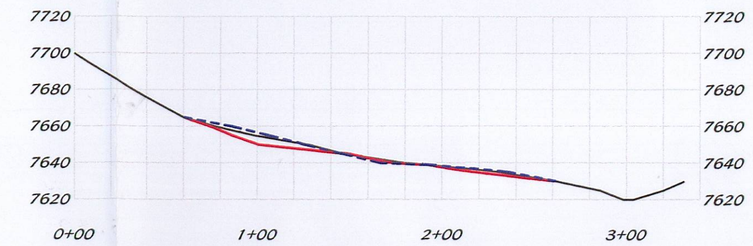

11+50

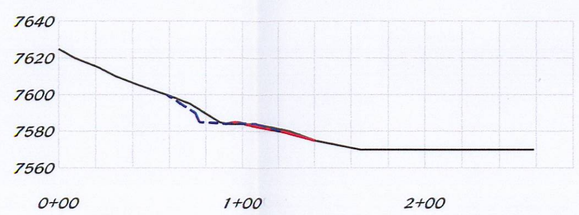

18+50

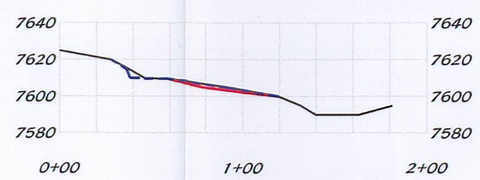

16+00

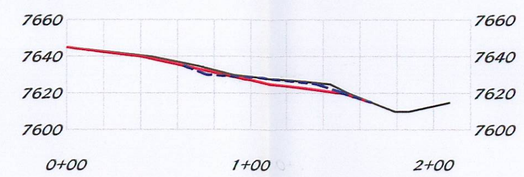

13+50

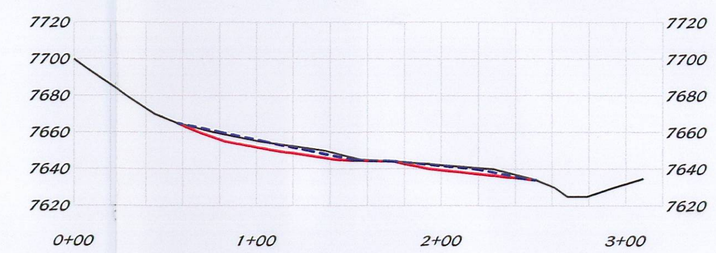

11+00

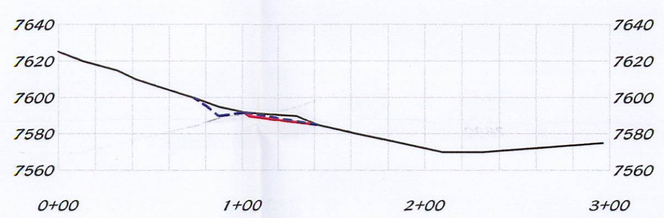

18+00

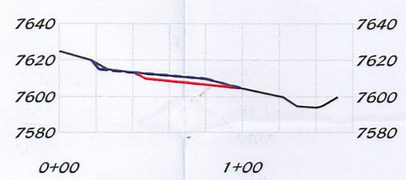

15+50

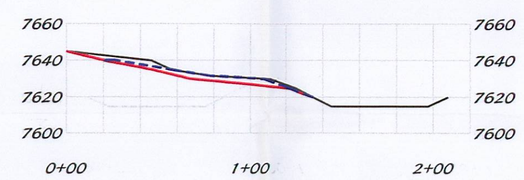

13+00

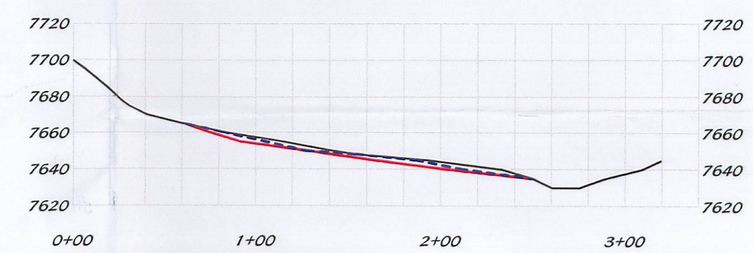

10+50

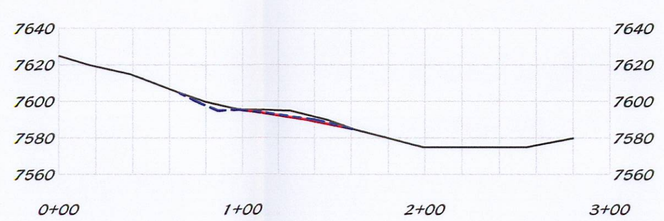

17+50

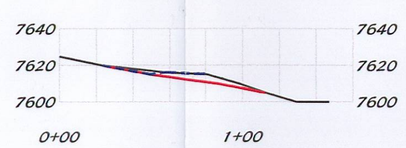

15+00

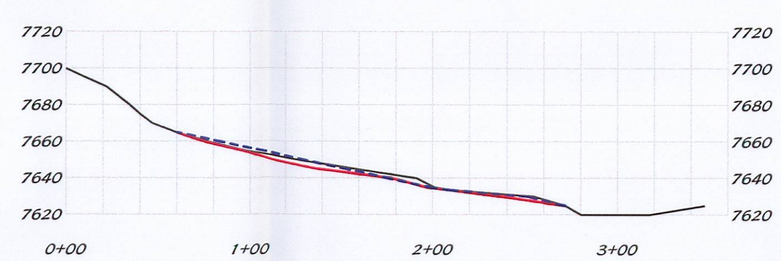

12+50

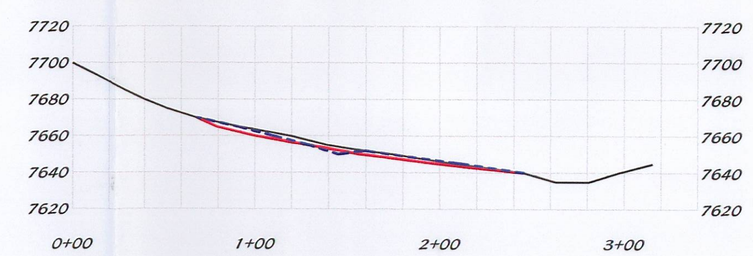

10+00

RECEIVED
JUN 30 2010
DIV. OF OIL, GAS & MINING

500-4

CAD FILE NAME/DISK#: 500-4 AS-BUILT

File in:
☐ Confidential
☒ Shelf
☐ Expandable
Date Folder 06301040 0150018
Sec Underwing For additional information

LICENSED PROFESSIONAL ENGINEER
JOHN CHRISTIAN LARSEN
6/23/10
No. 165651
STATE OF UTAH

NOTES

1. CROSS SECTIONS REFERENCE FROM 500-3
2. REFER TO VOLUME 11 APPENDIX VOLUME ENGINEERING APPENDIX F FOR SLOPE STABILITY ANALYSIS

LEGEND

PRE-EXISTING LINE
POST CONSTRUCTION LINE
FINAL RECLAMATION LINE

DATE	REVISION	BY	CHK
2/19/2010	REVISED TO REFLECT THE AS-BUILT CONDITIONS	KJL	

ENERGY WEST MINING COMPANY
A SUBSIDIARY OF PACIFICORP

DEER CREEK MINE
RILDA CANYON FACILITIES
CROSS SECTIONS

DRAWN BY: K. LARSEN
SCALE: 1"=60'
DATE: MARCH 25, 2009
DRAWING #: 500-4
SHEET 2 OF 4
REV. 1