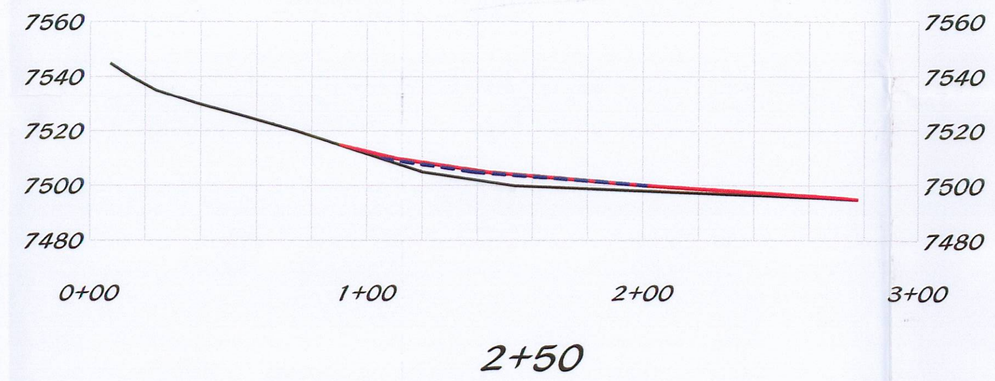

2+50

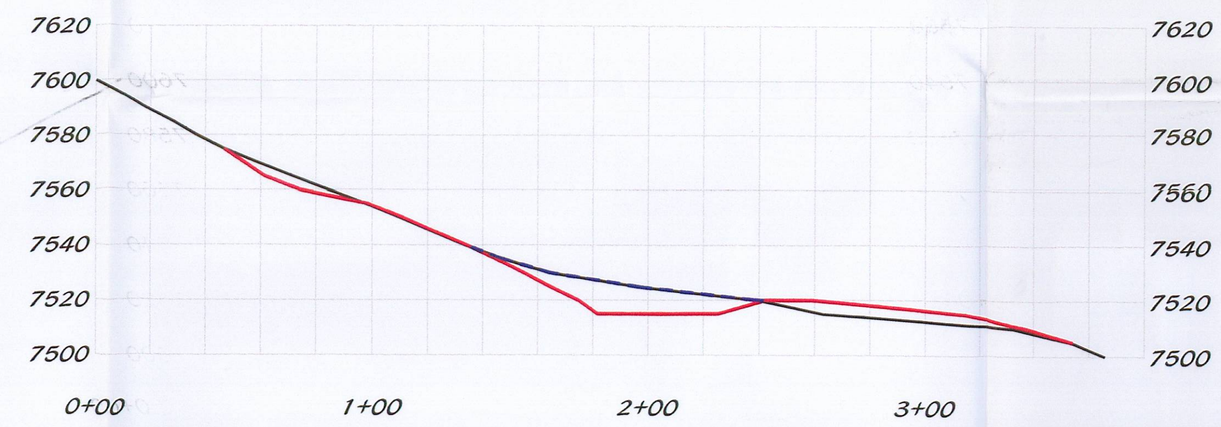

1+00

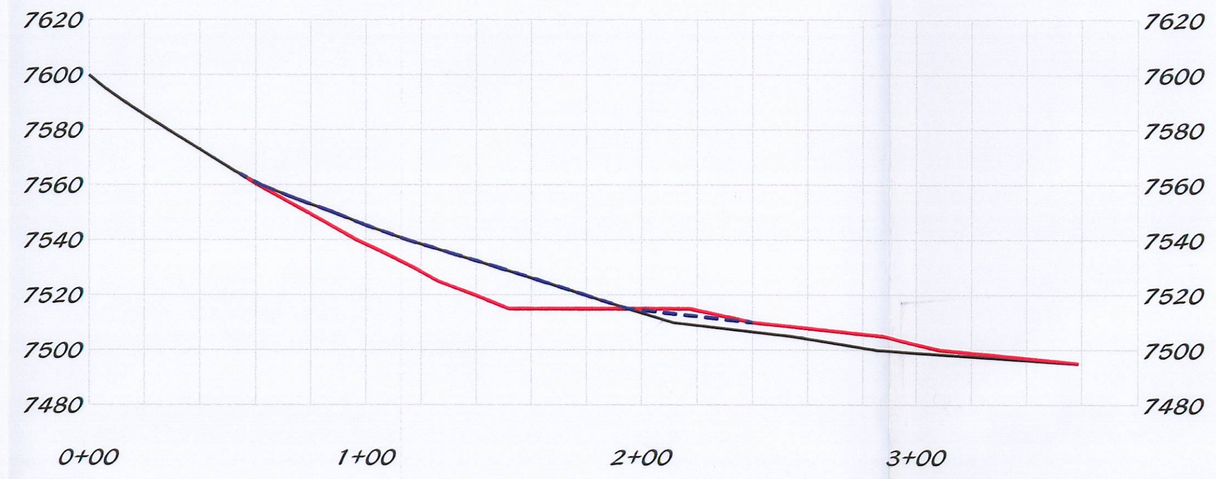

2+00

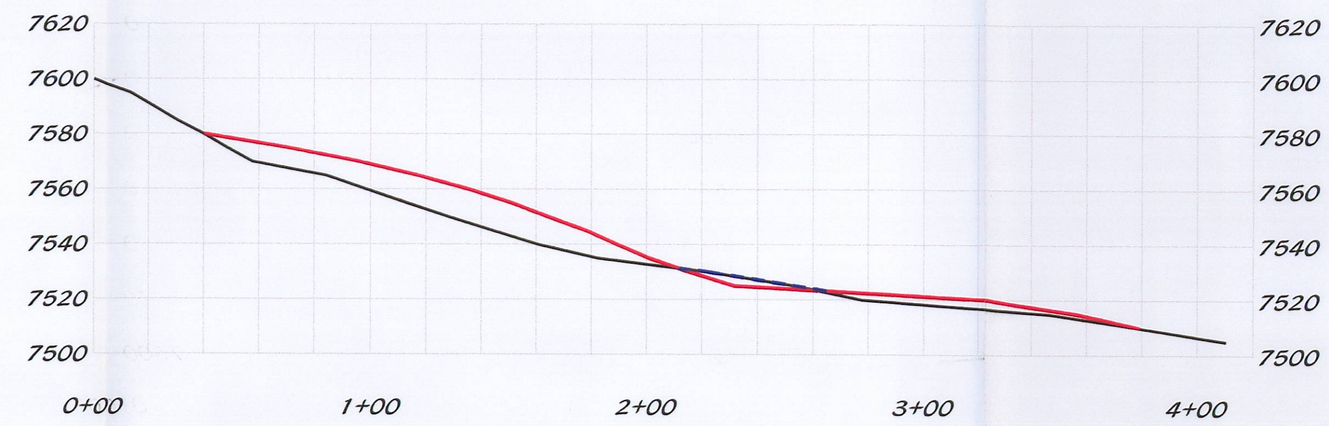

0+50

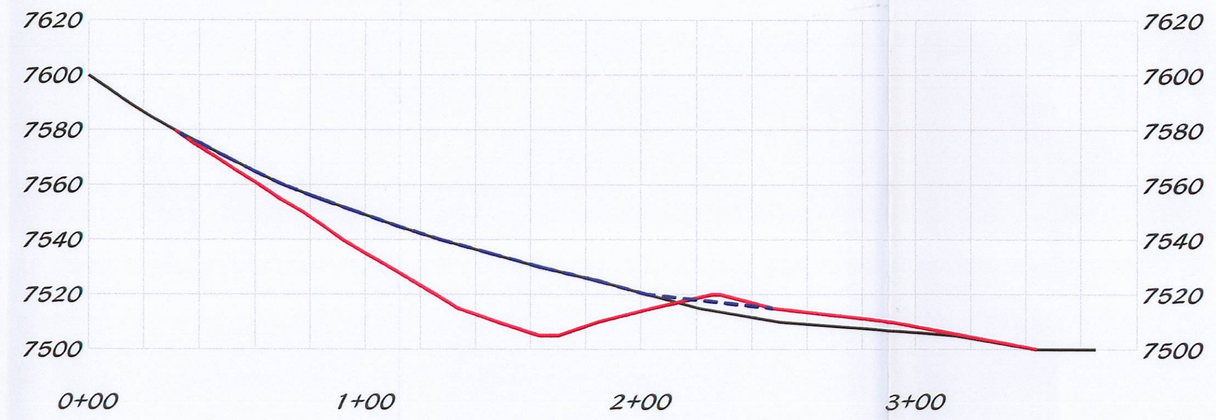

1+50

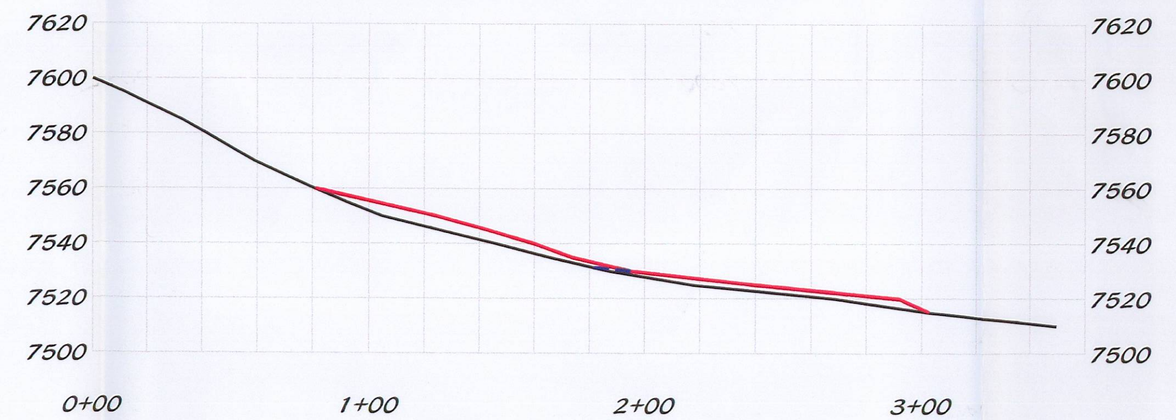

0+00

LICENSED PROFESSIONAL ENGINEER
DANIEL CHRISTENSEN
No. 165681
STATE OF UTAH

NOTES

1. PRIOR TO THE SEDIMENT POND CONSTRUCTION THE EXISTING COAL WASTE IN THIS AREA WAS REMOVED AND HAULED TO THE DEER CREEK WASTE ROCK SITE
2. THE FINAL RECLAMATION LINE CAN THEN BE DETERMINED AND WILL CLOSELY RESEMBLE THE EXISTING SLOPE
3. CROSS SECTIONS REFERENCED FROM 500-3

LEGEND

PRE-EXISTING LINE
POST CONSTRUCTION LINE
FINAL RECLAMATION LINE

File in:
☐ Confidential
☒ Shelf
☐ Expandable
Date Folder 063010a C0150018
See Jen comma For additional information

DATE	REVISION	BY	CHK
2/19/2010	REVISED TO REFLECT THE AS-BUILT CONDITIONS	KJL	

RECEIVED
JUN 30 2010
DIV. OF OIL, GAS & MINING

500-4

CAD FILE NAME/DISK#: 500-4 AS-BUILT

ENERGY WEST MINING COMPANY
A SUBSIDIARY OF PACIFICORP

DEER CREEK MINE
RILDA CANYON FACILITIES
SEDIMENT POND CROSS SECTIONS

DRAWN BY: K. LARSEN
SCALE: 1"=40'
DATE: MARCH 25, 2009
DRAWING #: 500-4
SHEET 4 OF 4
REV. 1