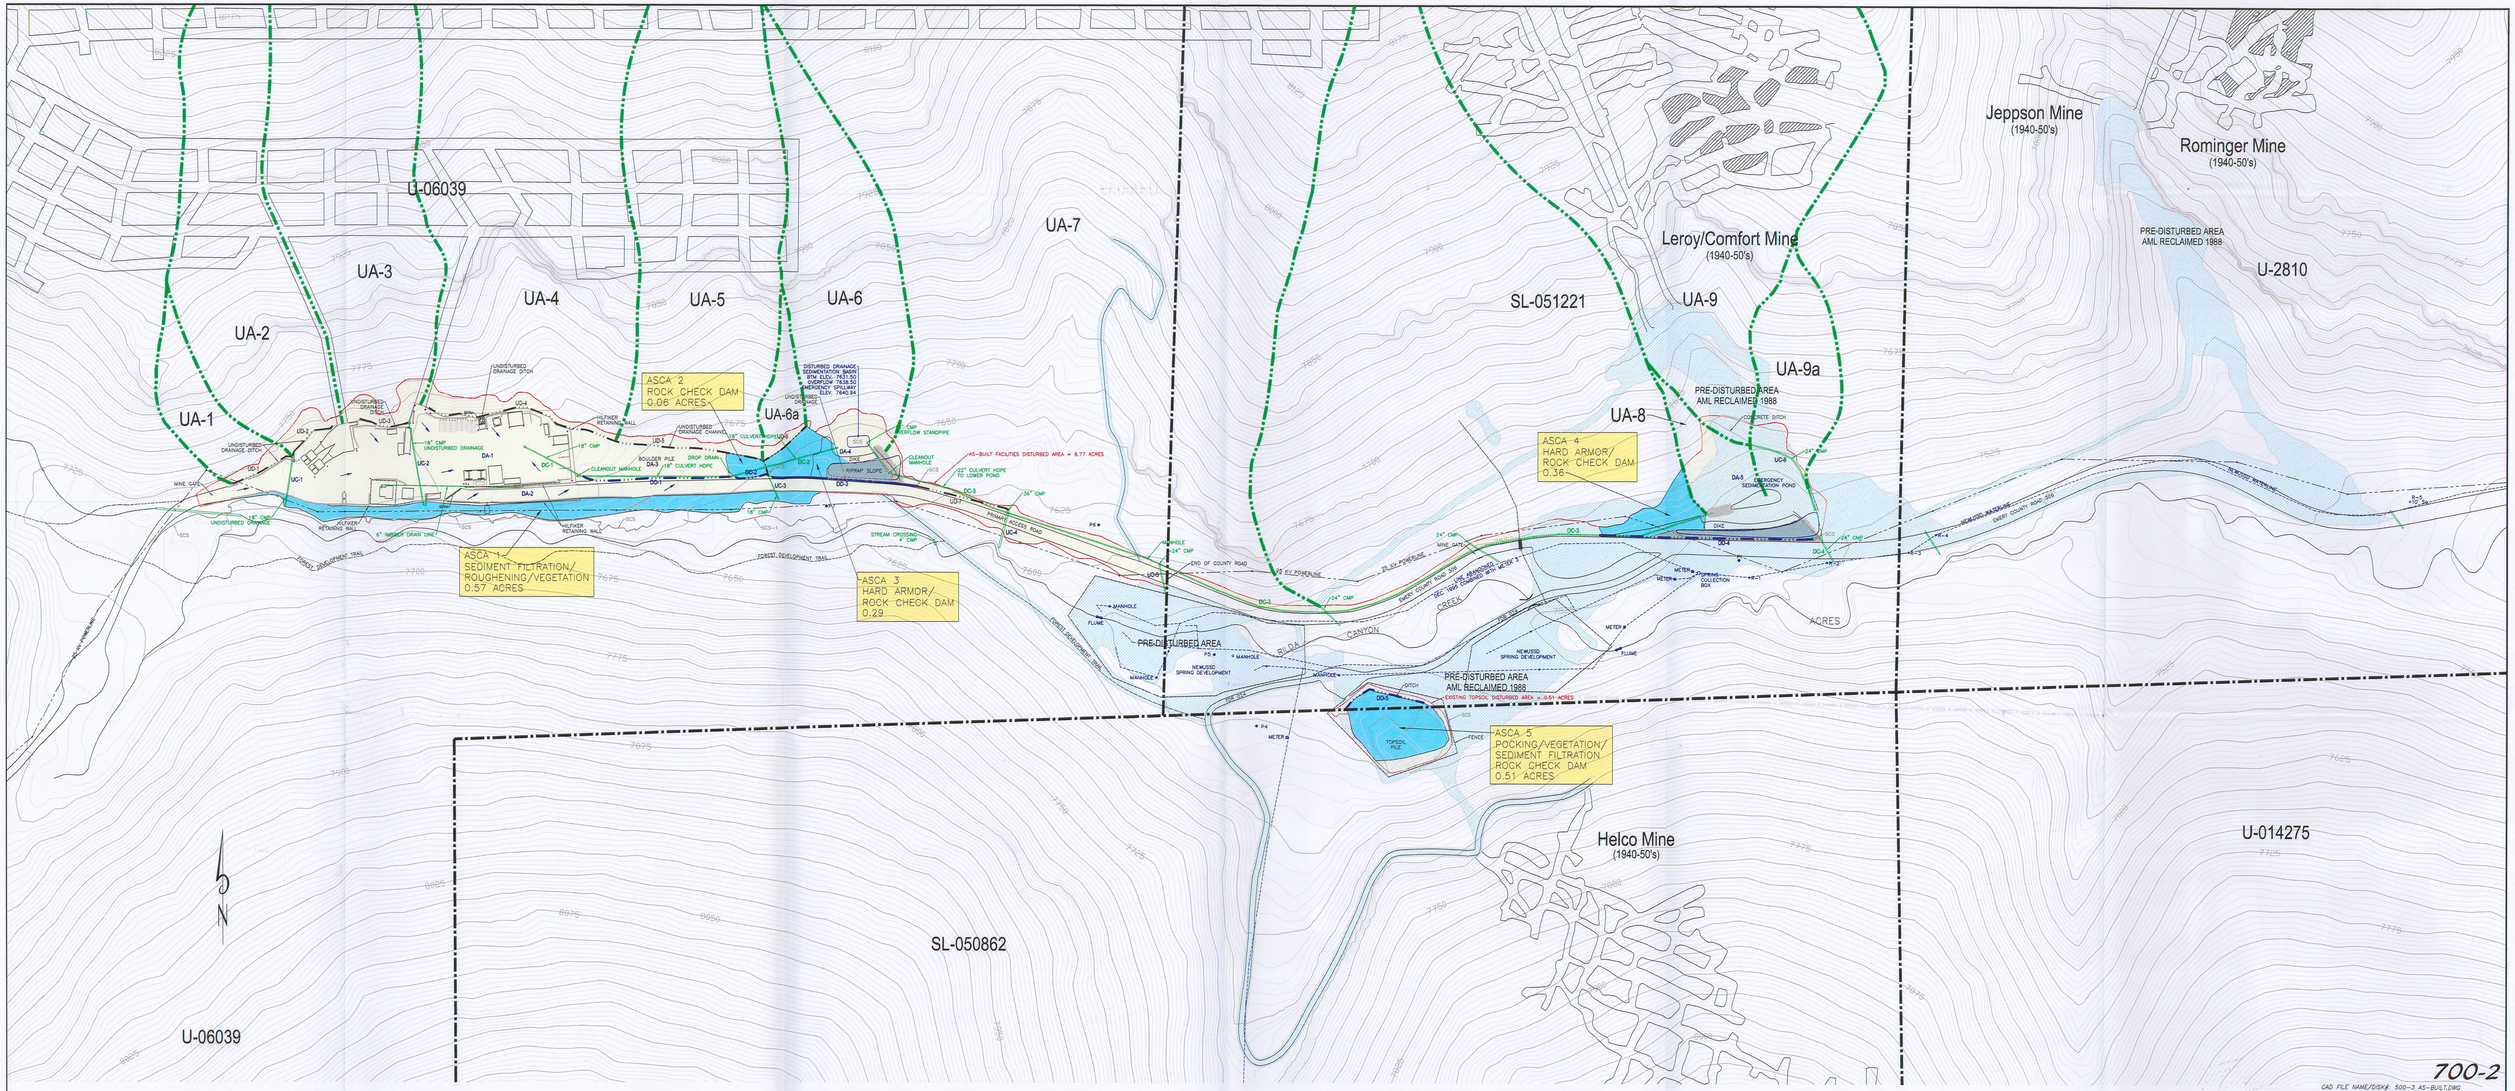

Legend:

- Undisturbed Drainage Area
- UA-5 (Numbers Report to Bypass Culverts)
- Disturbed Area Ditch
- Undisturbed Area Ditch
- Direction of Flow
- Power Pole
- As-Built Disturbed Area
- Pre-Disturbance Area
- ASCA (Alternative Sediment Control Area)
- Bollard
- Jersey Barrier
- Light Pole
- Drop Inlet
- Culvert
- Rip Rap
- Fence
- Dirt Berm
- SCS Sediment Control Structure (Refer to BMP Section)

700-2

CAD FILE NAME/DISK#: 500-3 AS-BUILT.DWG

RECEIVED
JUN 30 2010
DIV. OF OIL, GAS & MINING

File in:
☒ Confidential
☐ Shelf
☐ Expandable
Date Filed: 06/30/2010 C0150018
See Jim Rominger For additional

THOMAS R. PROFESSIONAL ENGINEER
(No. 165852)
STATE OF UTAH

DATE	REVISION	BY	CHK
5/26/2010	ADDED ALTERNATIVE SEDIMENT CONTROL AREAS	KJL	
6/12/2010	CHANGED CULVERT NOTATIONS TO CMP	KJL	
2/15/2010	REVISED TO REFLECT THE AS-BUILT CONDITIONS; DISTURBED AREA BOUNDARY AND TOPOGRAPHY	KJL	
5-23-05	ADDED FOREST DEVELOPMENT ROAD 024	KJL	
9-7-04	REVISED CONTOUR ELEVATION NOTATIONS	KJL	

ENERGY WEST MINING COMPANY
A SUBSIDIARY OF PACIFICORP

DEER CREEK MINE
RILDA CANYON FACILITIES
MINE SITE DRAINAGE MAP

DRAWN BY: K. LARSEN
SCALE: 1"=100'
DRAWING #: 700-2
DATE: AUGUST 25, 2004
SHEET 1 OF 1
REV. 1