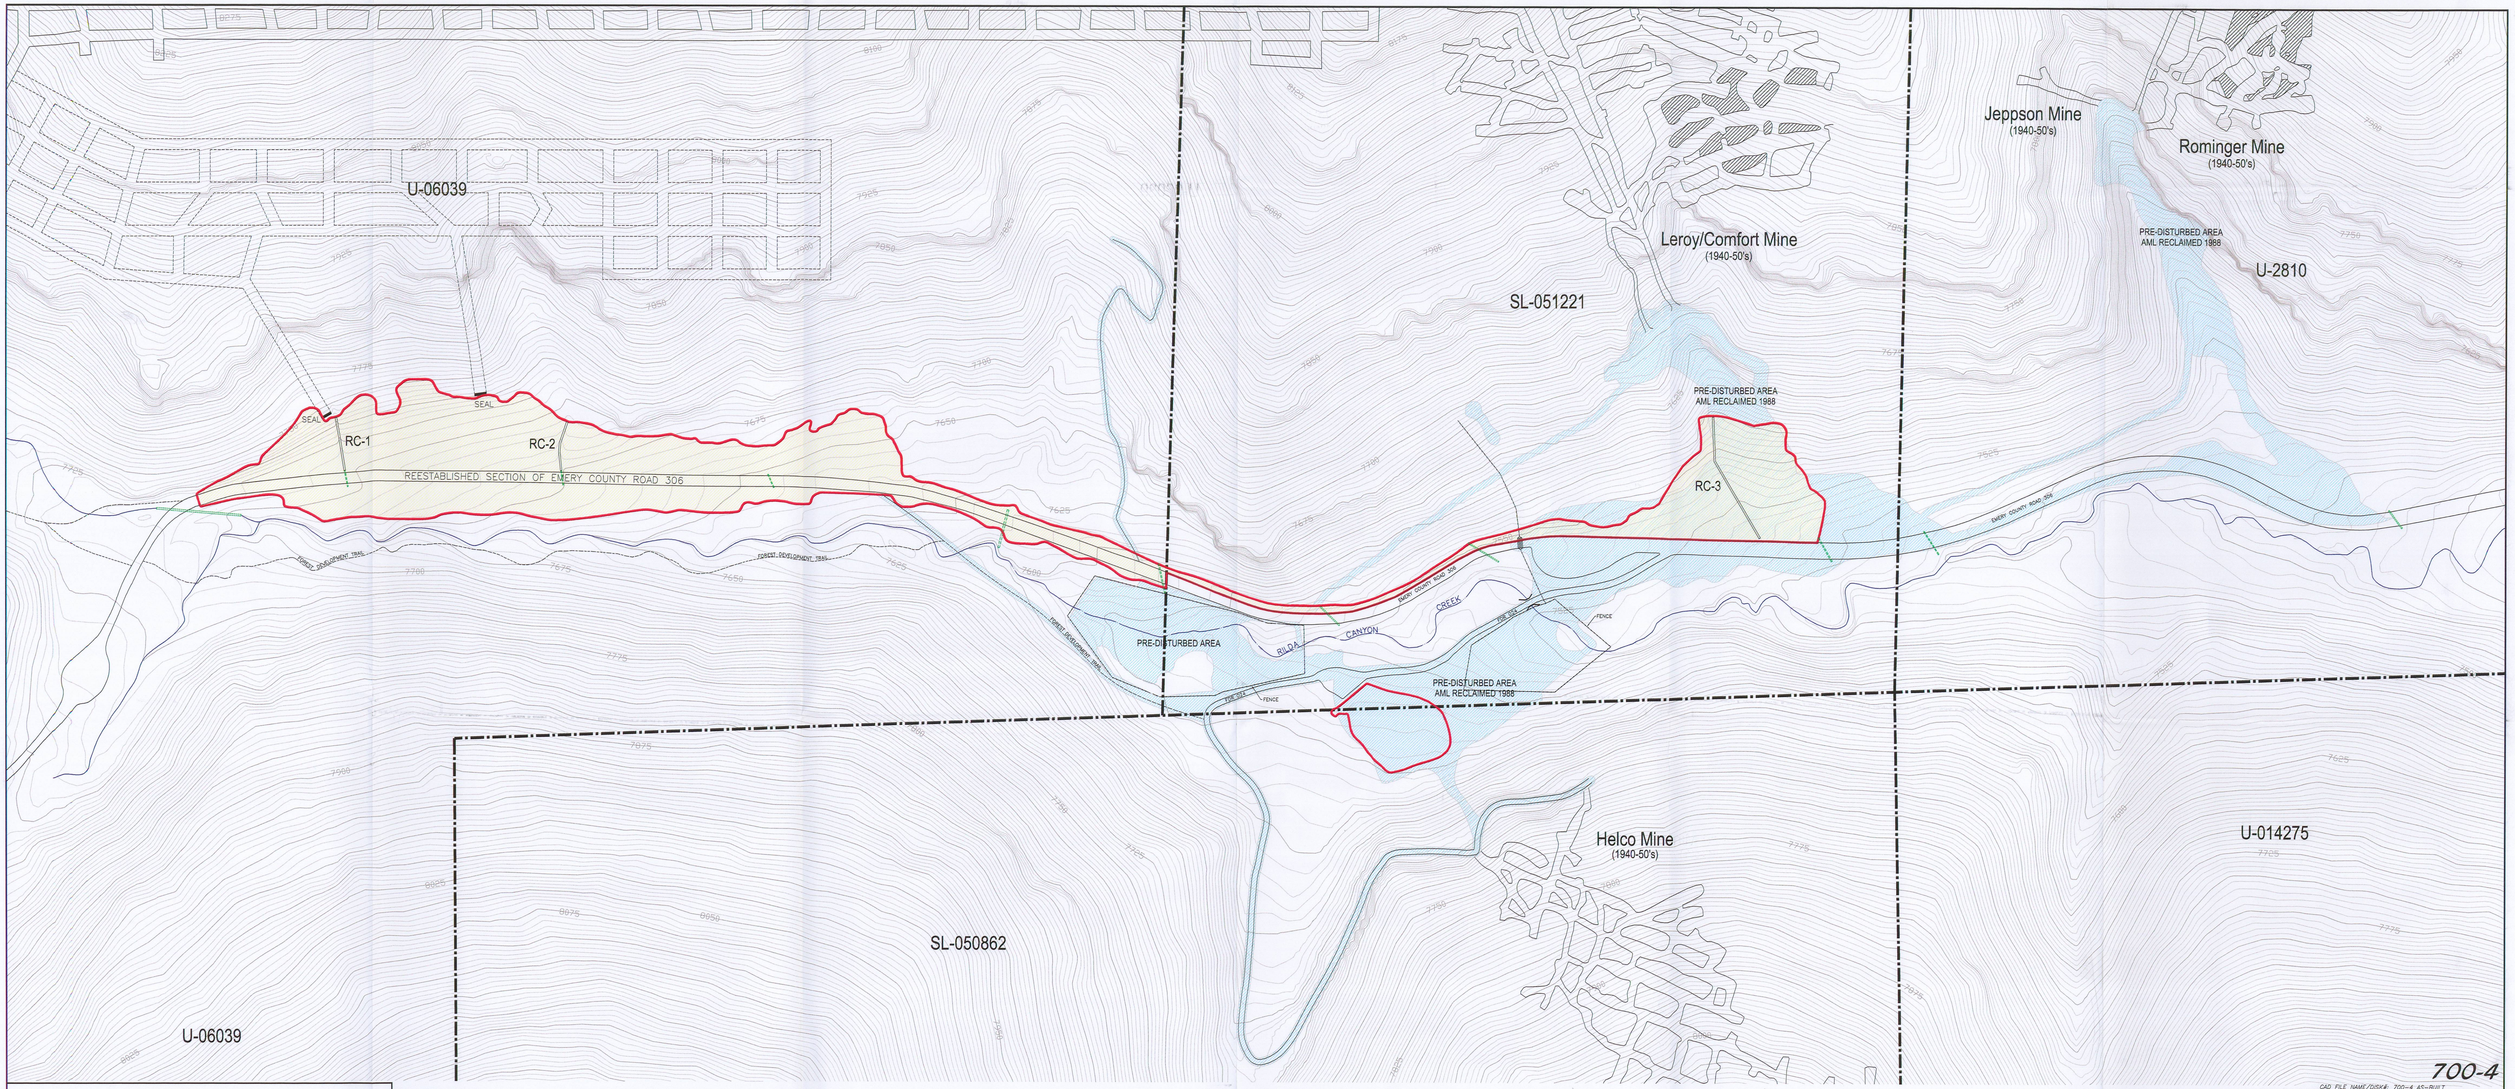

700-4

CAD FILE NAME/DISK# 700-4 AS-BUILT

LEGEND

- RECLAIMED CHANNEL
- CULVERT LOCATIONS
- DISTURBED/RECLAIMED AREA BOUNDARY
- RECLAIMED AREA
- AML RECLAIMED AREA

LEGEND

PRE-DISTURBED AREA (AML RECLAIMED 1988)
OF THE 7.28 TOTAL DISTURBED ACRES, 1.79 ACRES ARE ON LAND PRE-DISTURBED BY HISTORICAL MINE SITES. THE PRE-DISTURBED LAND IS 24.6% OF THE TOTAL DISTURBED AT THE RILDA CANYON PORTAL FACILITIES.

File in:
☐ Confidential
☒ Shelf
☐ Expandable
Date Filed: 06/30/2010 01/50018
See Volume For additional

LICENSED PROFESSIONAL ENGINEER
CHRISTIAN SELTMAN
No. 165251
STATE OF UTAH

RECEIVED
JUN 30 2010
DIV. OF OIL, GAS & MINING

DATE	REVISION	BY	CHK
6-3-10	REVISED DISTURBED AREA BOUNDARIES, AND FINAL RECLAMATION TOPOGRAPHY.	KJL	
5-23-05	ADDED FOREST DEVELOPMENT ROAD 024	KJL	

ENERGY WEST MINING COMPANY
A SUBSIDIARY OF PACIFICORP

DEER CREEK MINE
RILDA CANYON FACILITIES
RECLAMATION HYDROLOGY MAP

DRAWN BY: K. LARSEN
SCALE: 1" = 100'
DATE: NOVEMBER 12, 2004
DRAWING #: 700-4
SHEET 1 OF 1
REV. 4