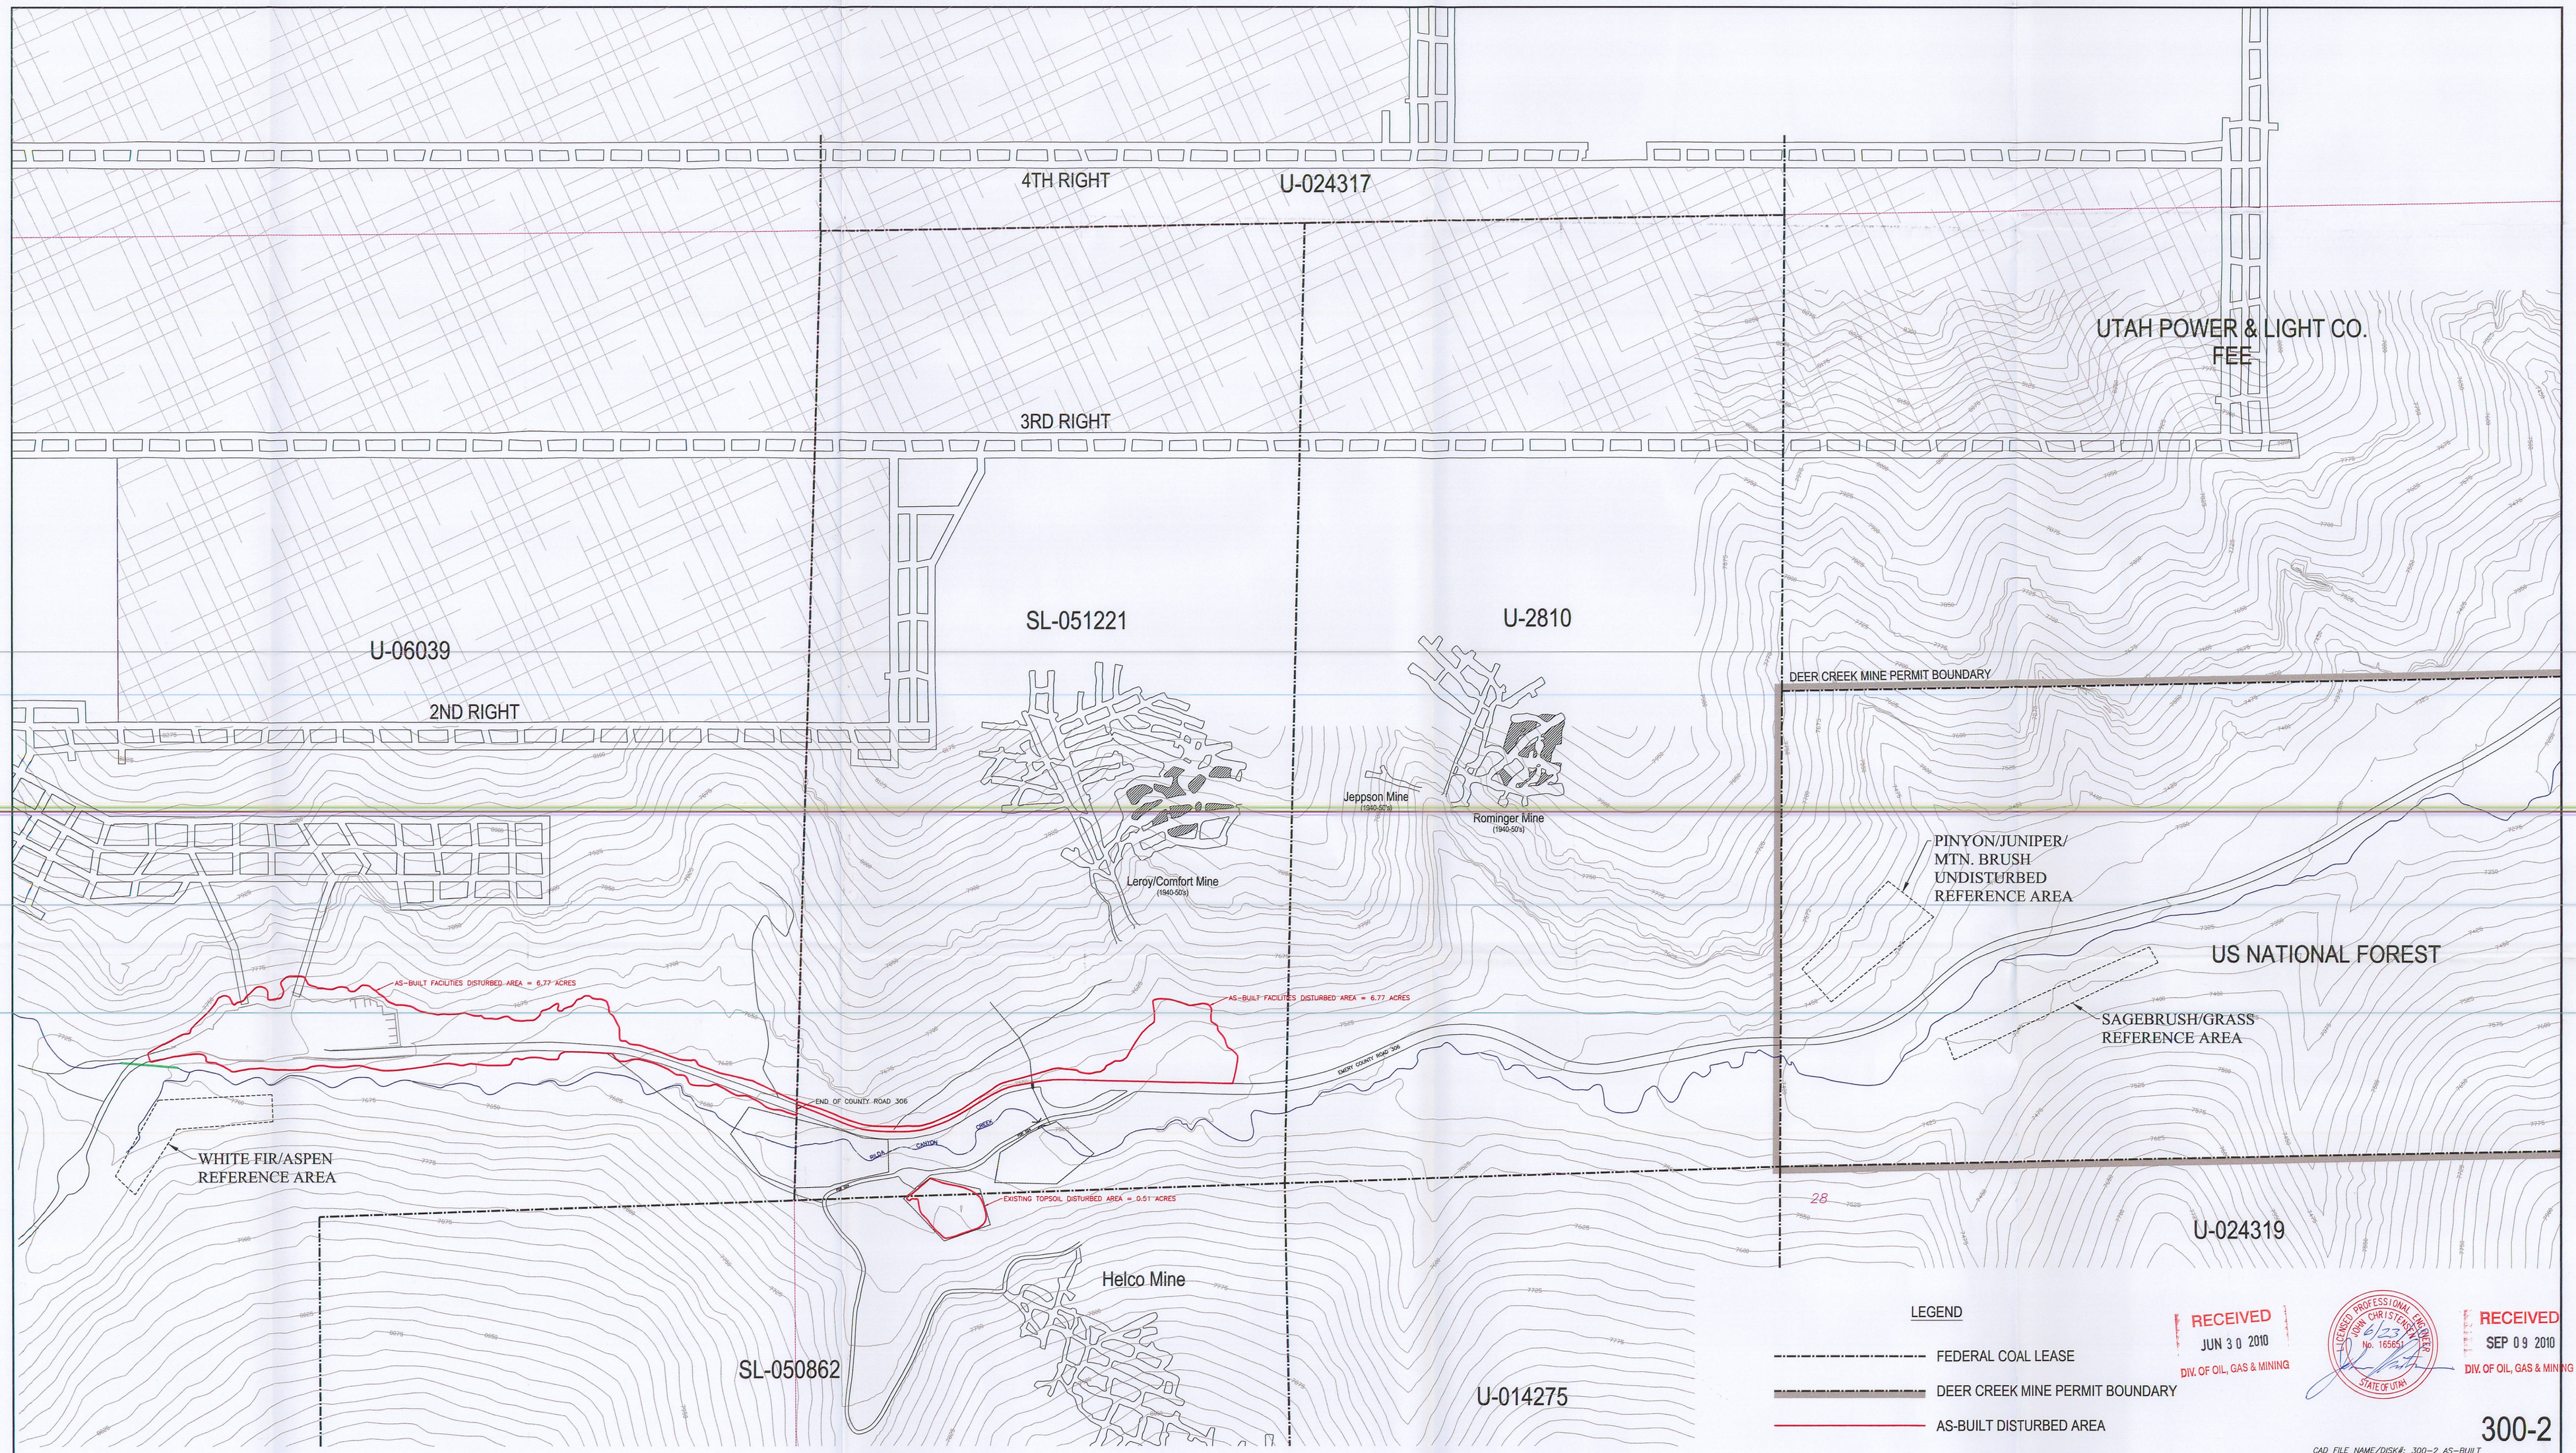

LEGEND

- FEDERAL COAL LEASE
- DEER CREEK MINE PERMIT BOUNDARY
- AS-BUILT DISTURBED AREA

RECEIVED
JUN 30 2010
DIV. OF OIL, GAS & MINING

LICENSED PROFESSIONAL ENGINEER
JOHN CHRISTENSEN
No. 165651
6/23/10
STATE OF UTAH

RECEIVED
SEP 09 2010
DIV. OF OIL, GAS & MINING

300-2

CAD FILE NAME/DISK#: 300-2 AS-BUILT

ENERGY WEST MINING COMPANY
A SUBSIDIARY OF PACIFICORP

DEER CREEK MINE
RILDA CANYON FACILITIES
VEGETATION REFERENCE AREAS

File in:
☐ Confidential
☒ Shelf
☐ Expandable
Date Folder 090910 0150018
See Incoming for additional

DATE	REVISION	BY	CHK
2/4/2010	ADDED AS-BUILT DISTURBED AREA BOUNDARY AND FENCE AROUND TOPSOIL PILE	KJL	

DRAWN BY: K. LARSEN		300-2	
SCALE: 1"=200'		DRAWING #:	
DATE: JUNE 16, 2009	SHEET 1 OF 1		REV. 1