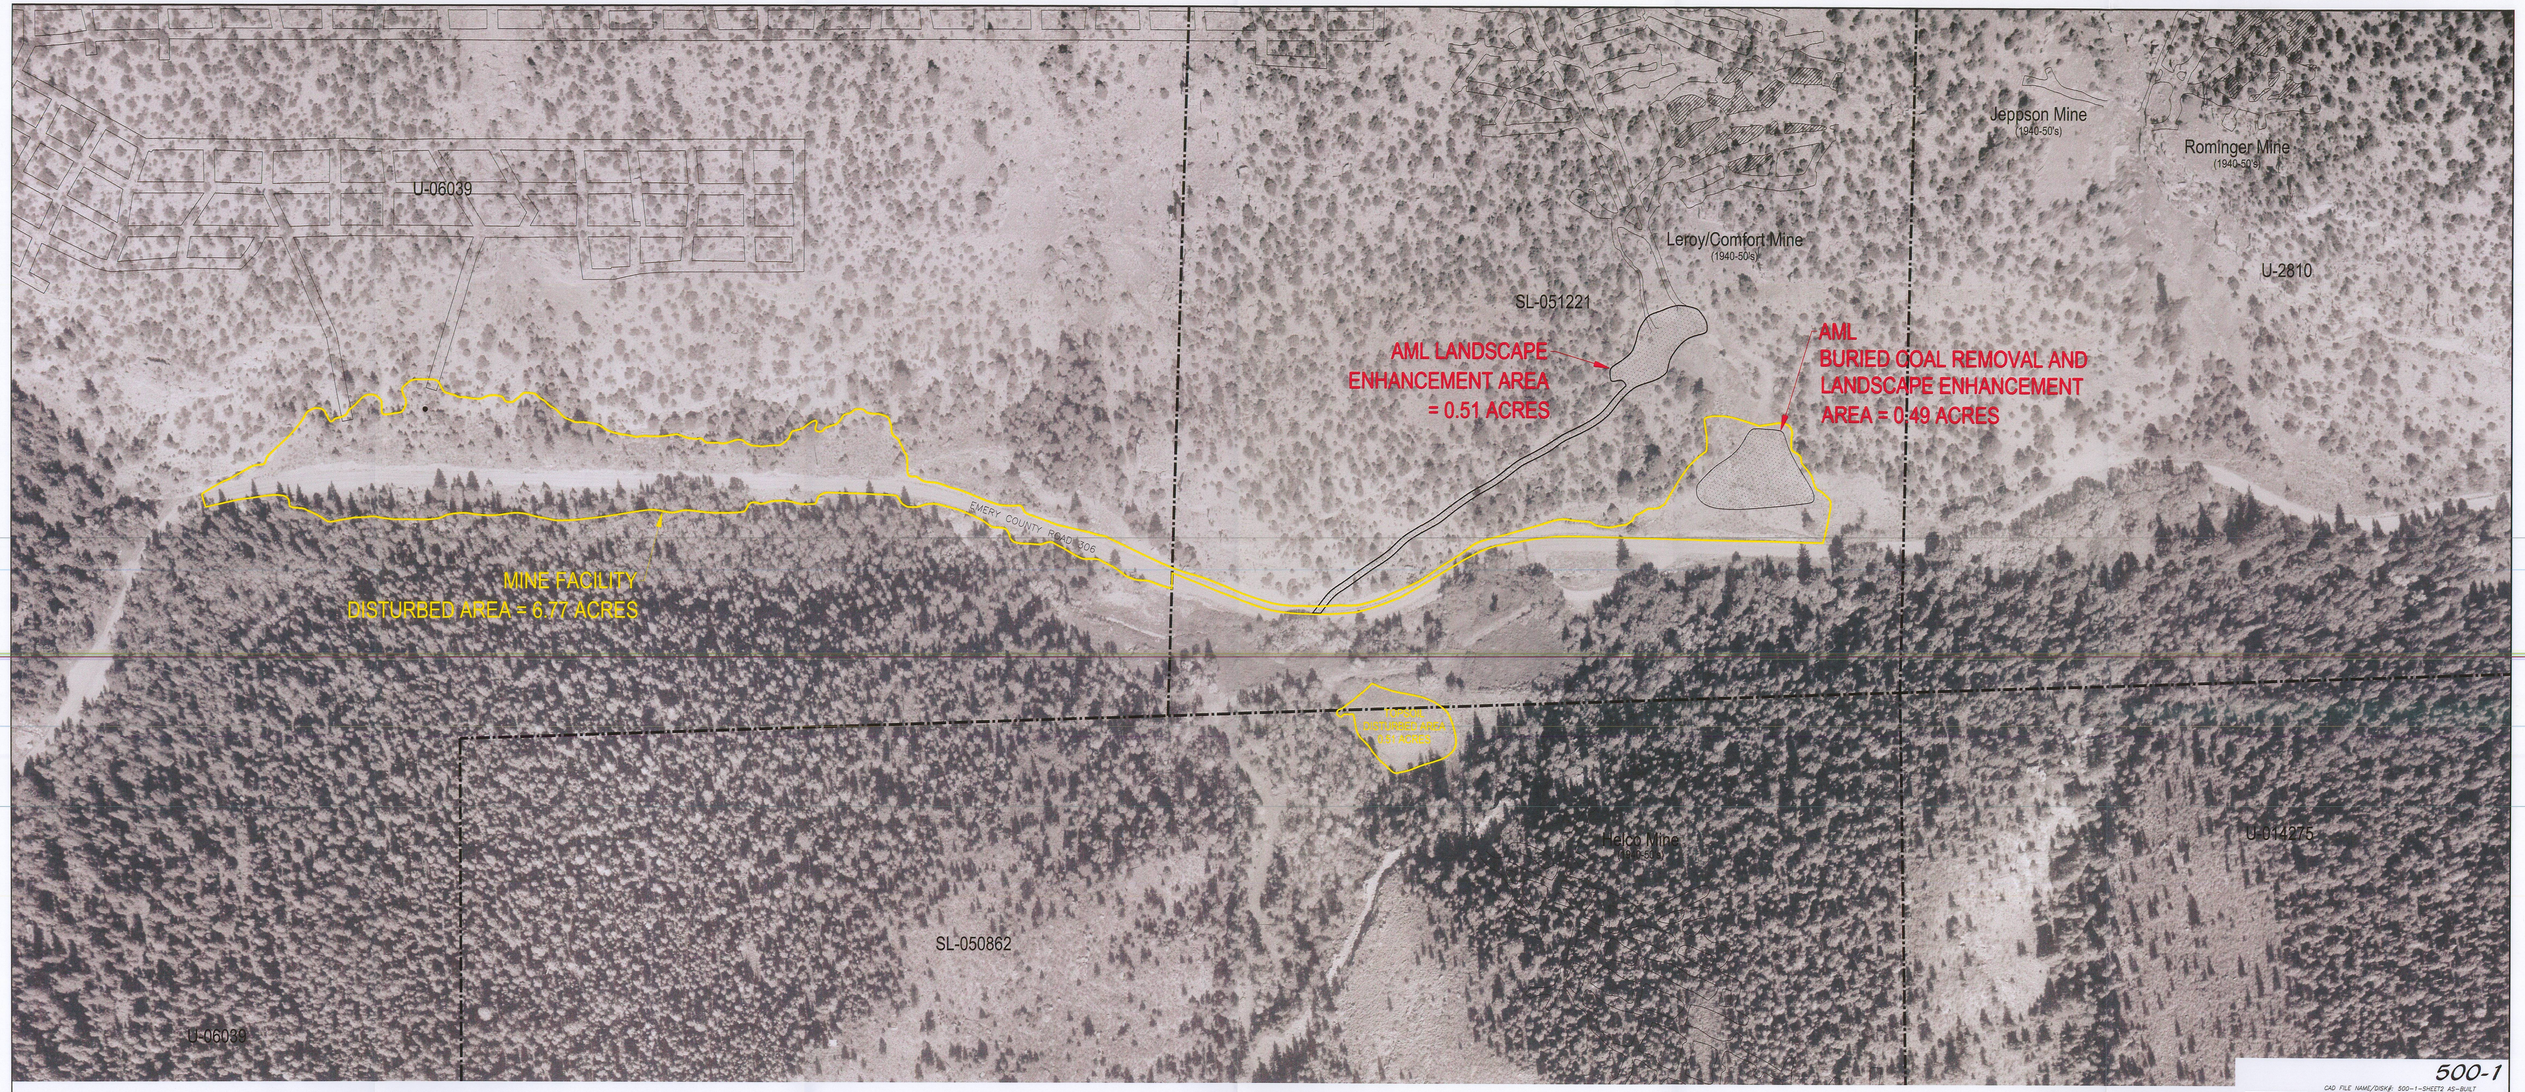


500-1

CAD FILE NAME/DISK#: 500-1-SHEET2 AS-BUILT

RECEIVED
JUN 30 2010
DIV. OF OIL, GAS & MINING

RECEIVED
SEP 09 2010
DIV. OF OIL, GAS & MINING

ENERGY WEST MINING COMPANY
A SUBSIDIARY OF PACIFICORP

DEER CREEK MINE
RILDA CANYON
PRE-DISTURBANCE AERIAL

| DATE | REVISION | BY | CHK |
|---|---|---|---|
| 2/4/2010 | ADDED AS-BUILT DISTURBED AREA BOUNDARY AND AML LANDSCAPE ENHANCEMENT AREAS | KJL | |

DRAWN BY: K. LARSEN
SCALE: 1" = 100'
DATE: APRIL 16, 2010
DRAWING #: 500-1
SHEET 2 OF 3
REV. 1

File in:
☐ Confidential
☒ Shelf
☐ Expandable
Date Folder: 20910 0150018
See Jacomino for additional

LICENSED PROFESSIONAL ENGINEER
ARVIN CHRISTENSEN
No. 185851
STATE OF UTAH