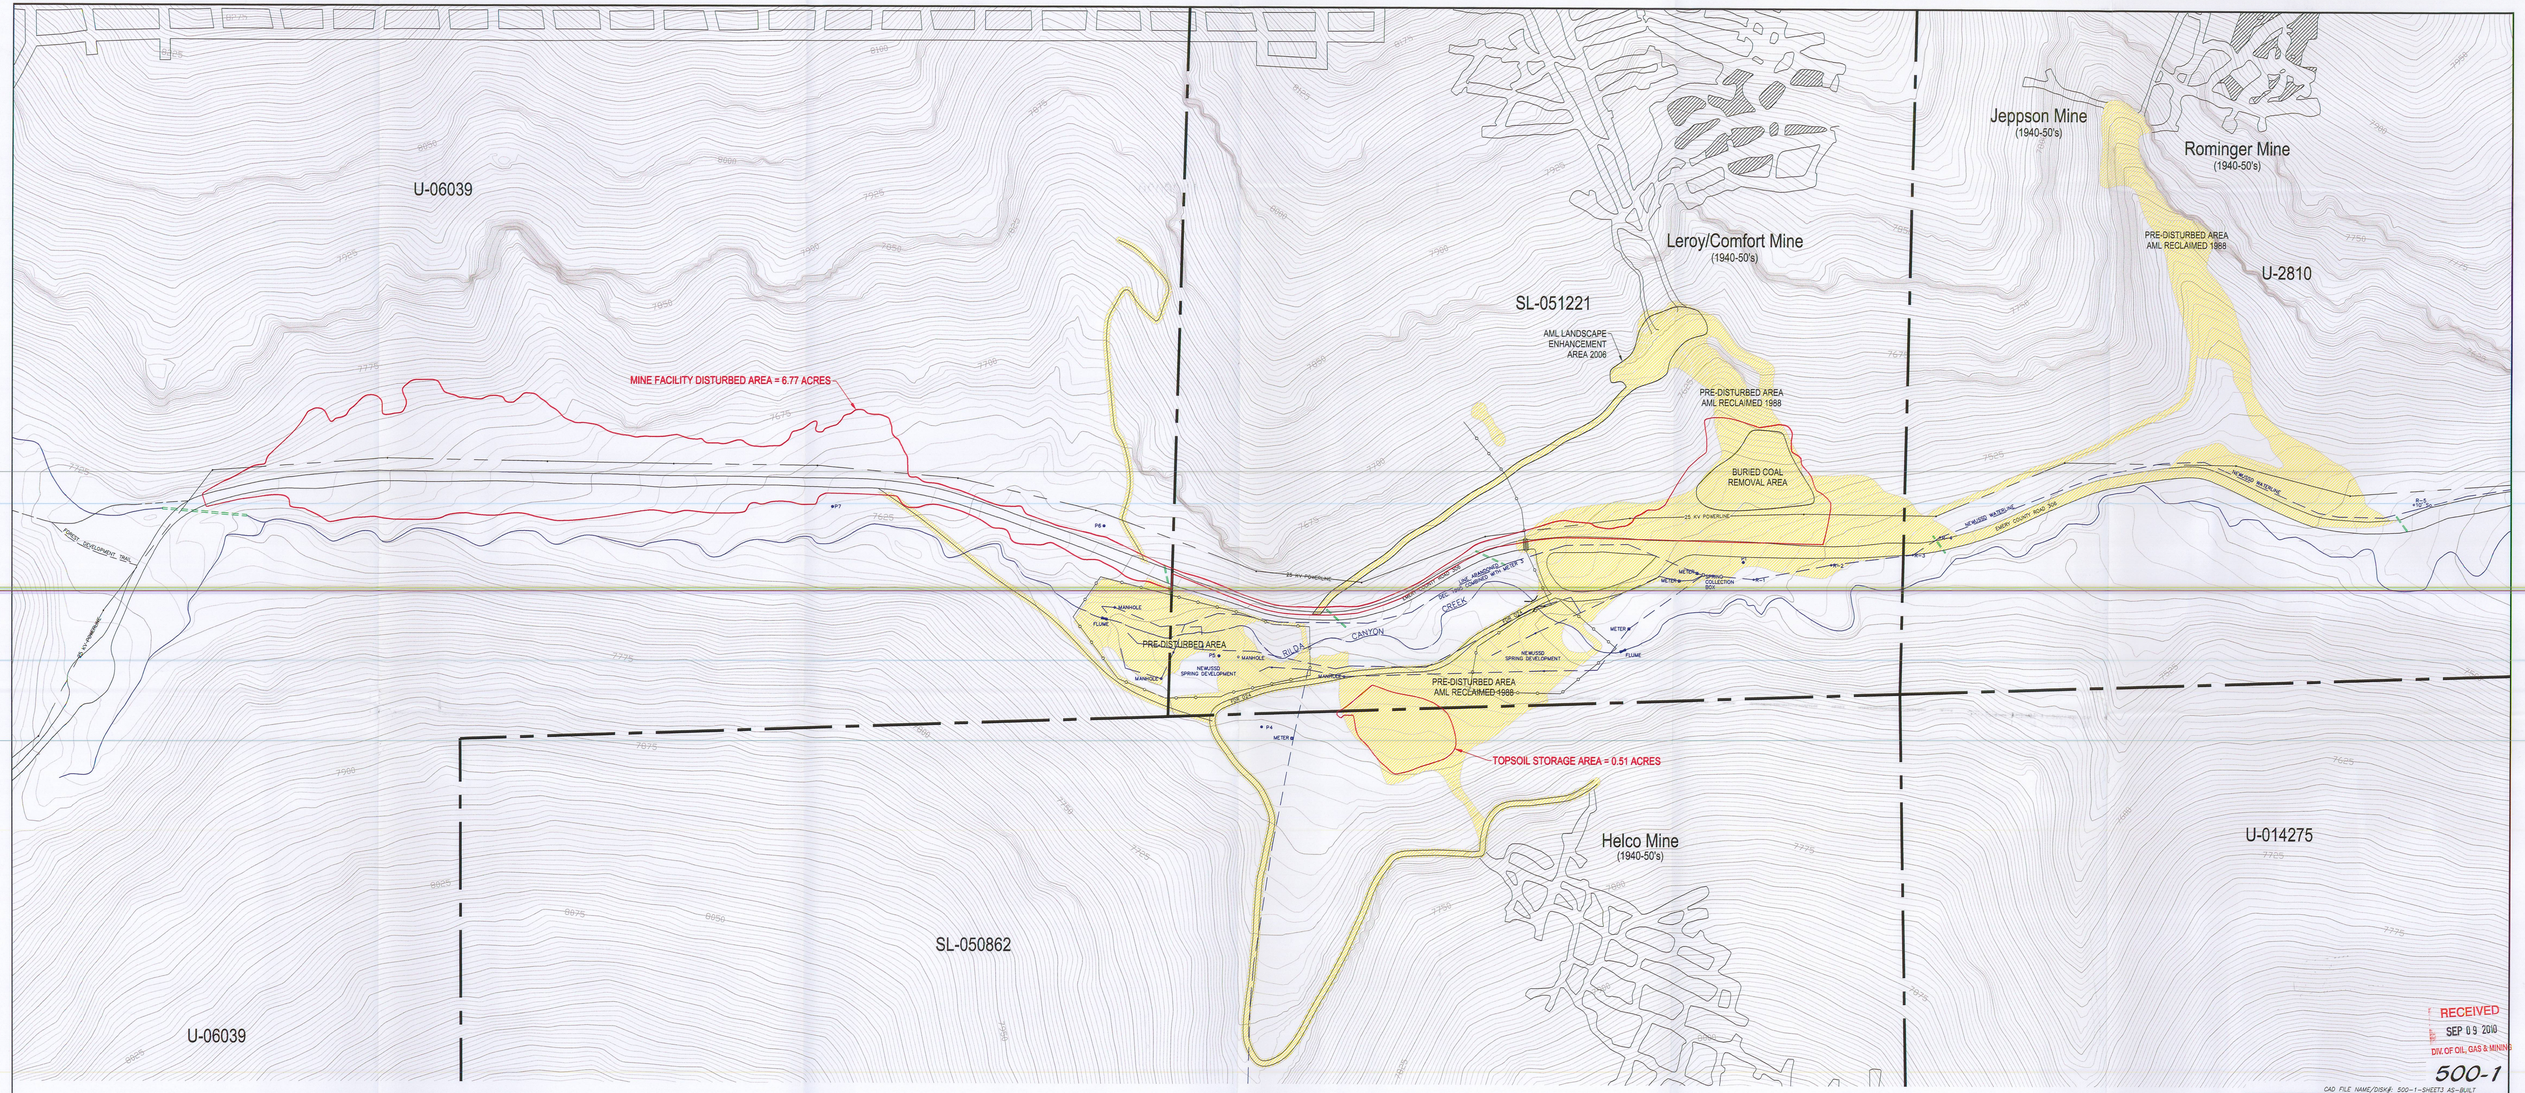

LEGEND

PRE-DISTURBED AREA (AML RECLAIMED 1988)
OF THE 7.28 TOTAL DISTURBED ACRES, 1.79 ACRES ARE ON LAND PRE-DISTURBED BY HISTORICAL MINE SITES. THE PRE-DISTURBED LAND IS 24.6% OF THE TOTAL DISTURBED AT THE RILDA CANYON PORTAL FACILITIES.

RECEIVED
SEP 09 2010
DIV. OF OIL, GAS & MINING

500-1

CAD FILE NAME/DISK#: 500-1-SHEET3 AS-BUILT

RECEIVED
JUN 30 2010
DIV. OF OIL, GAS & MINING

File in:
☐ Confidential
☒ Shelf
☐ Expandable
Date Folder 06/30/2010 coldcore

See Jerry Jensen for additional information

ENERGY WEST MINING COMPANY
A SUBSIDIARY OF PACIFICORP

DEER CREEK MINE
RILDA CANYON
PRE-DISTURBANCE TOPOGRAPHY

DATE	REVISION	BY	CHK
2/10/2010	ADDED AS-BUILT DISTURBED AREA BOUNDARY AND REVISED LEGEND NOTATION TO REFLECT AS-BUILT	K.JL	

DRAWN BY: K. LARSEN
SCALE: 1" = 100'
DATE: JUNE 16, 2009
DRAWING #: 500-1
SHEET 3 OF 3
REV. 1