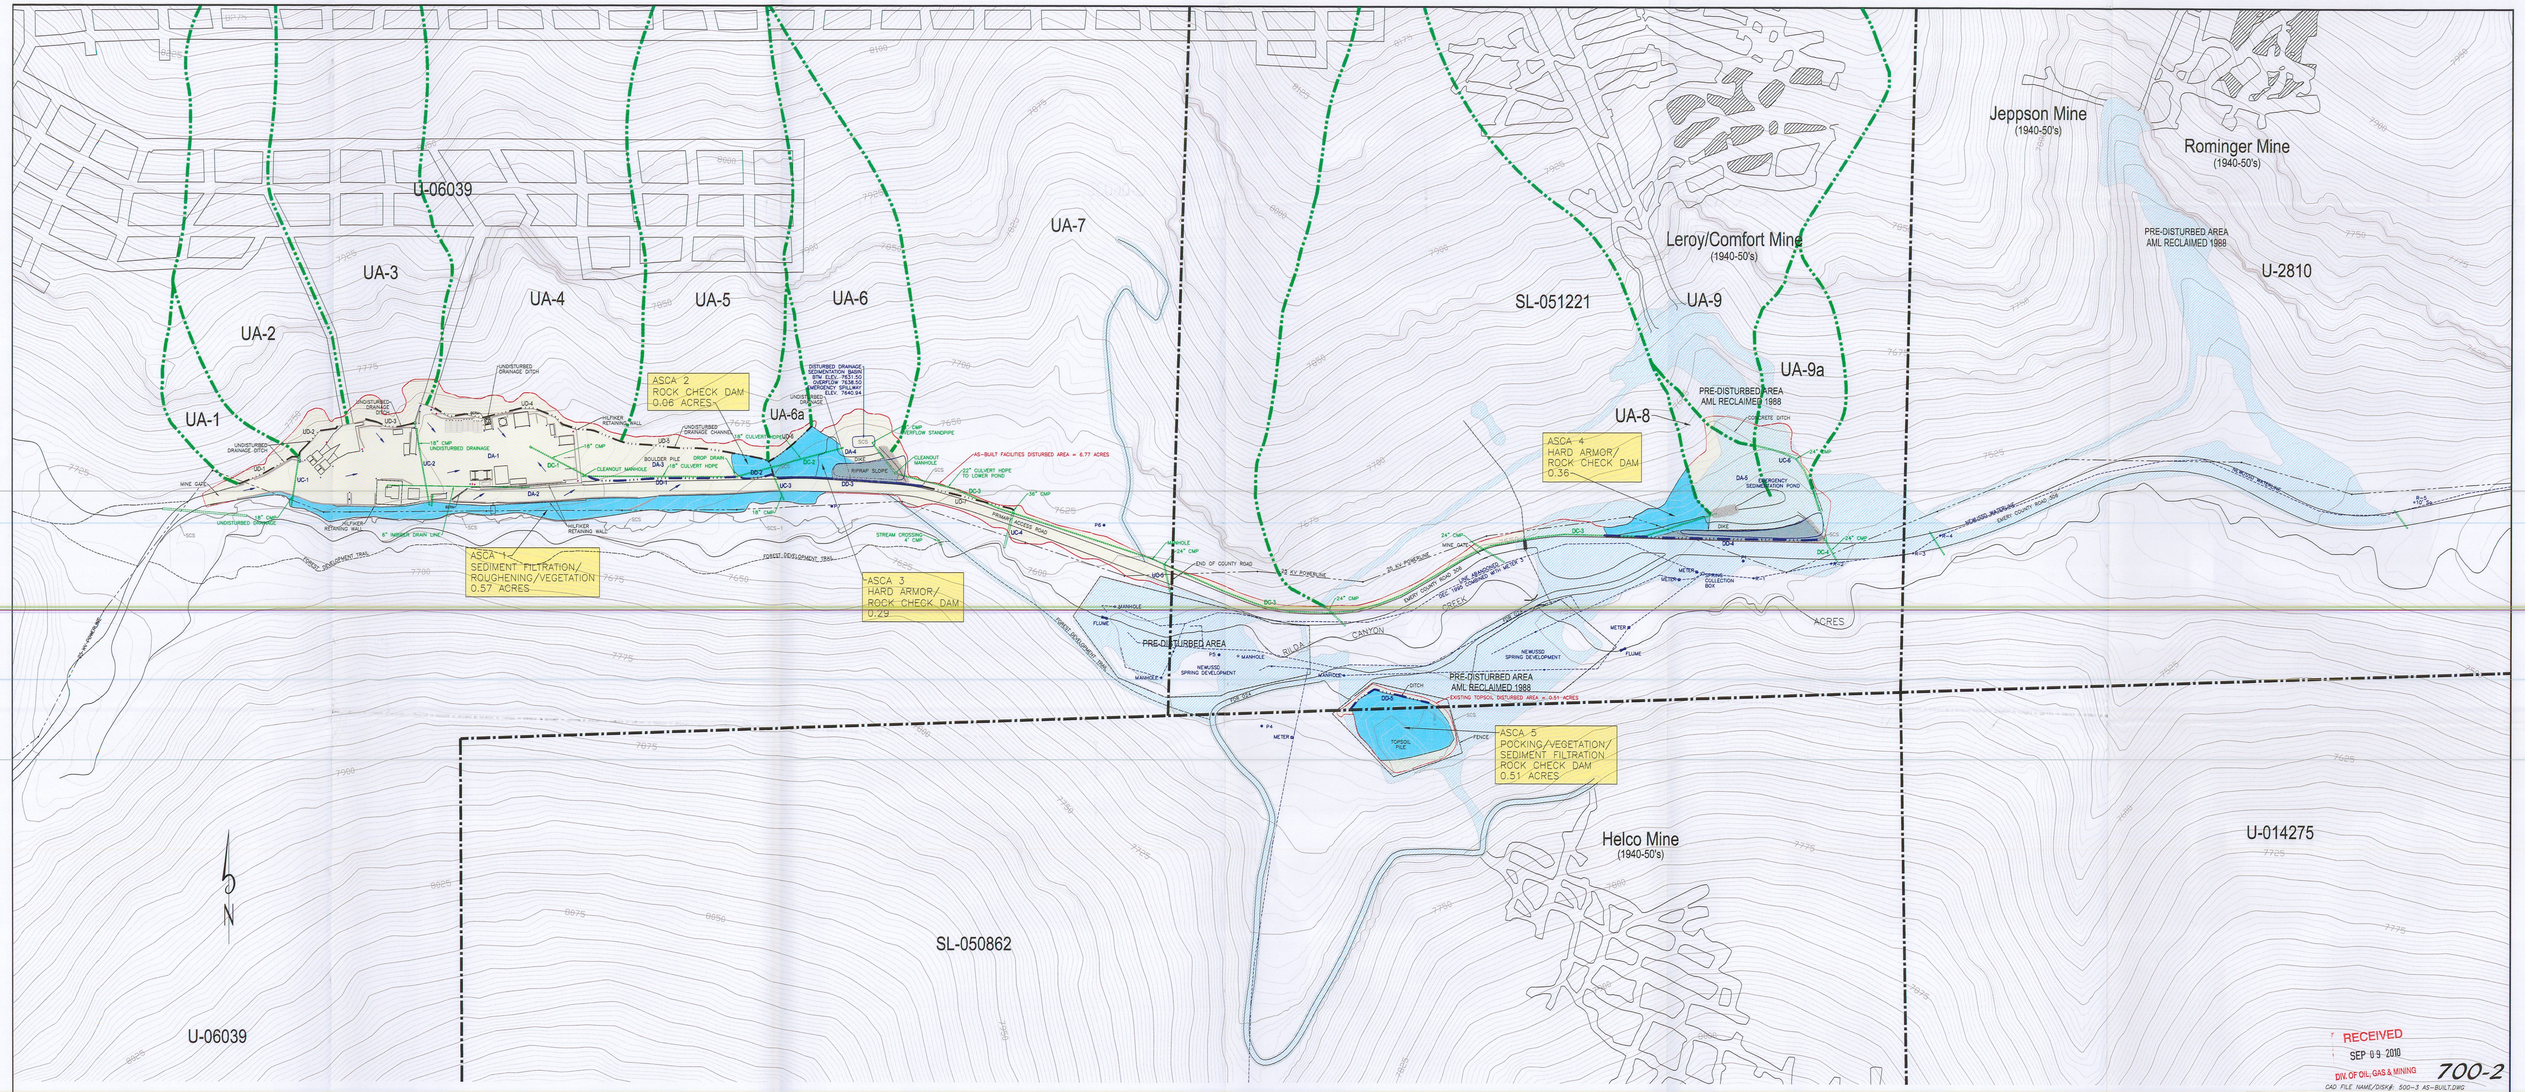

Legend:

- Undisturbed Drainage Area
- UA-5 (Numbers Report to Bypass Culverts)
- Disturbed Area Ditch
- Undisturbed Area Ditch
- Direction of Flow
- Power Pole
- As-Built Disturbed Area
- Pre-Disturbance Area
- ASCA (Alternative Sediment Control Area)
- Bollard
- Jersey Barrier
- Light Pole
- Drop Inlet
- Culvert
- Rip Rap
- Fence
- Dirt Berm
- SCS Sediment Control Structure (Refer to BMP Section)

File in:
☐ Confidential
☒ Shelf
☐ Expandable
Date Folder 20070100010E0018
Scanning For additional information

RECEIVED
JUN 30 2010
DIV. OF OIL, GAS & MINING

RECEIVED
SEP 09 2010
DIV. OF OIL, GAS & MINING

700-2

CAD FILE NAME/DISK#: 500-3 AS-BUILT.DWG

REGISTERED PROFESSIONAL ENGINEER
JOHN CHR STENSON
No. 6368
STATE OF UTAH

DATE	REVISION	BY	CHK
5/26/2010	ADDED ALTERNATIVE SEDIMENT CONTROL AREAS	KJL	
5/12/2010	CHANGED CULVERT NOTATIONS TO CMP	KJL	
2/15/2010	REVISED TO REFLECT THE AS-BUILT CONDITIONS, DISTURBED AREA BOUNDARY AND TOPOGRAPHY	KJL	
5-23-05	ADDED FOREST DEVELOPMENT ROAD 024	KJL	
9-7-04	REVISED CONTOUR ELEVATION NOTATIONS	KJL	

ENERGY WEST MINING COMPANY
A SUBSIDIARY OF PACIFICORP

DEER CREEK MINE
RILDA CANYON FACILITIES
MINE SITE DRAINAGE MAP

DRAWN BY: K. LARSEN
SCALE: 1"=100'
DATE: AUGUST 25, 2004
DRAWING #: 700-2
SHEET 1 OF 1
REV. 1