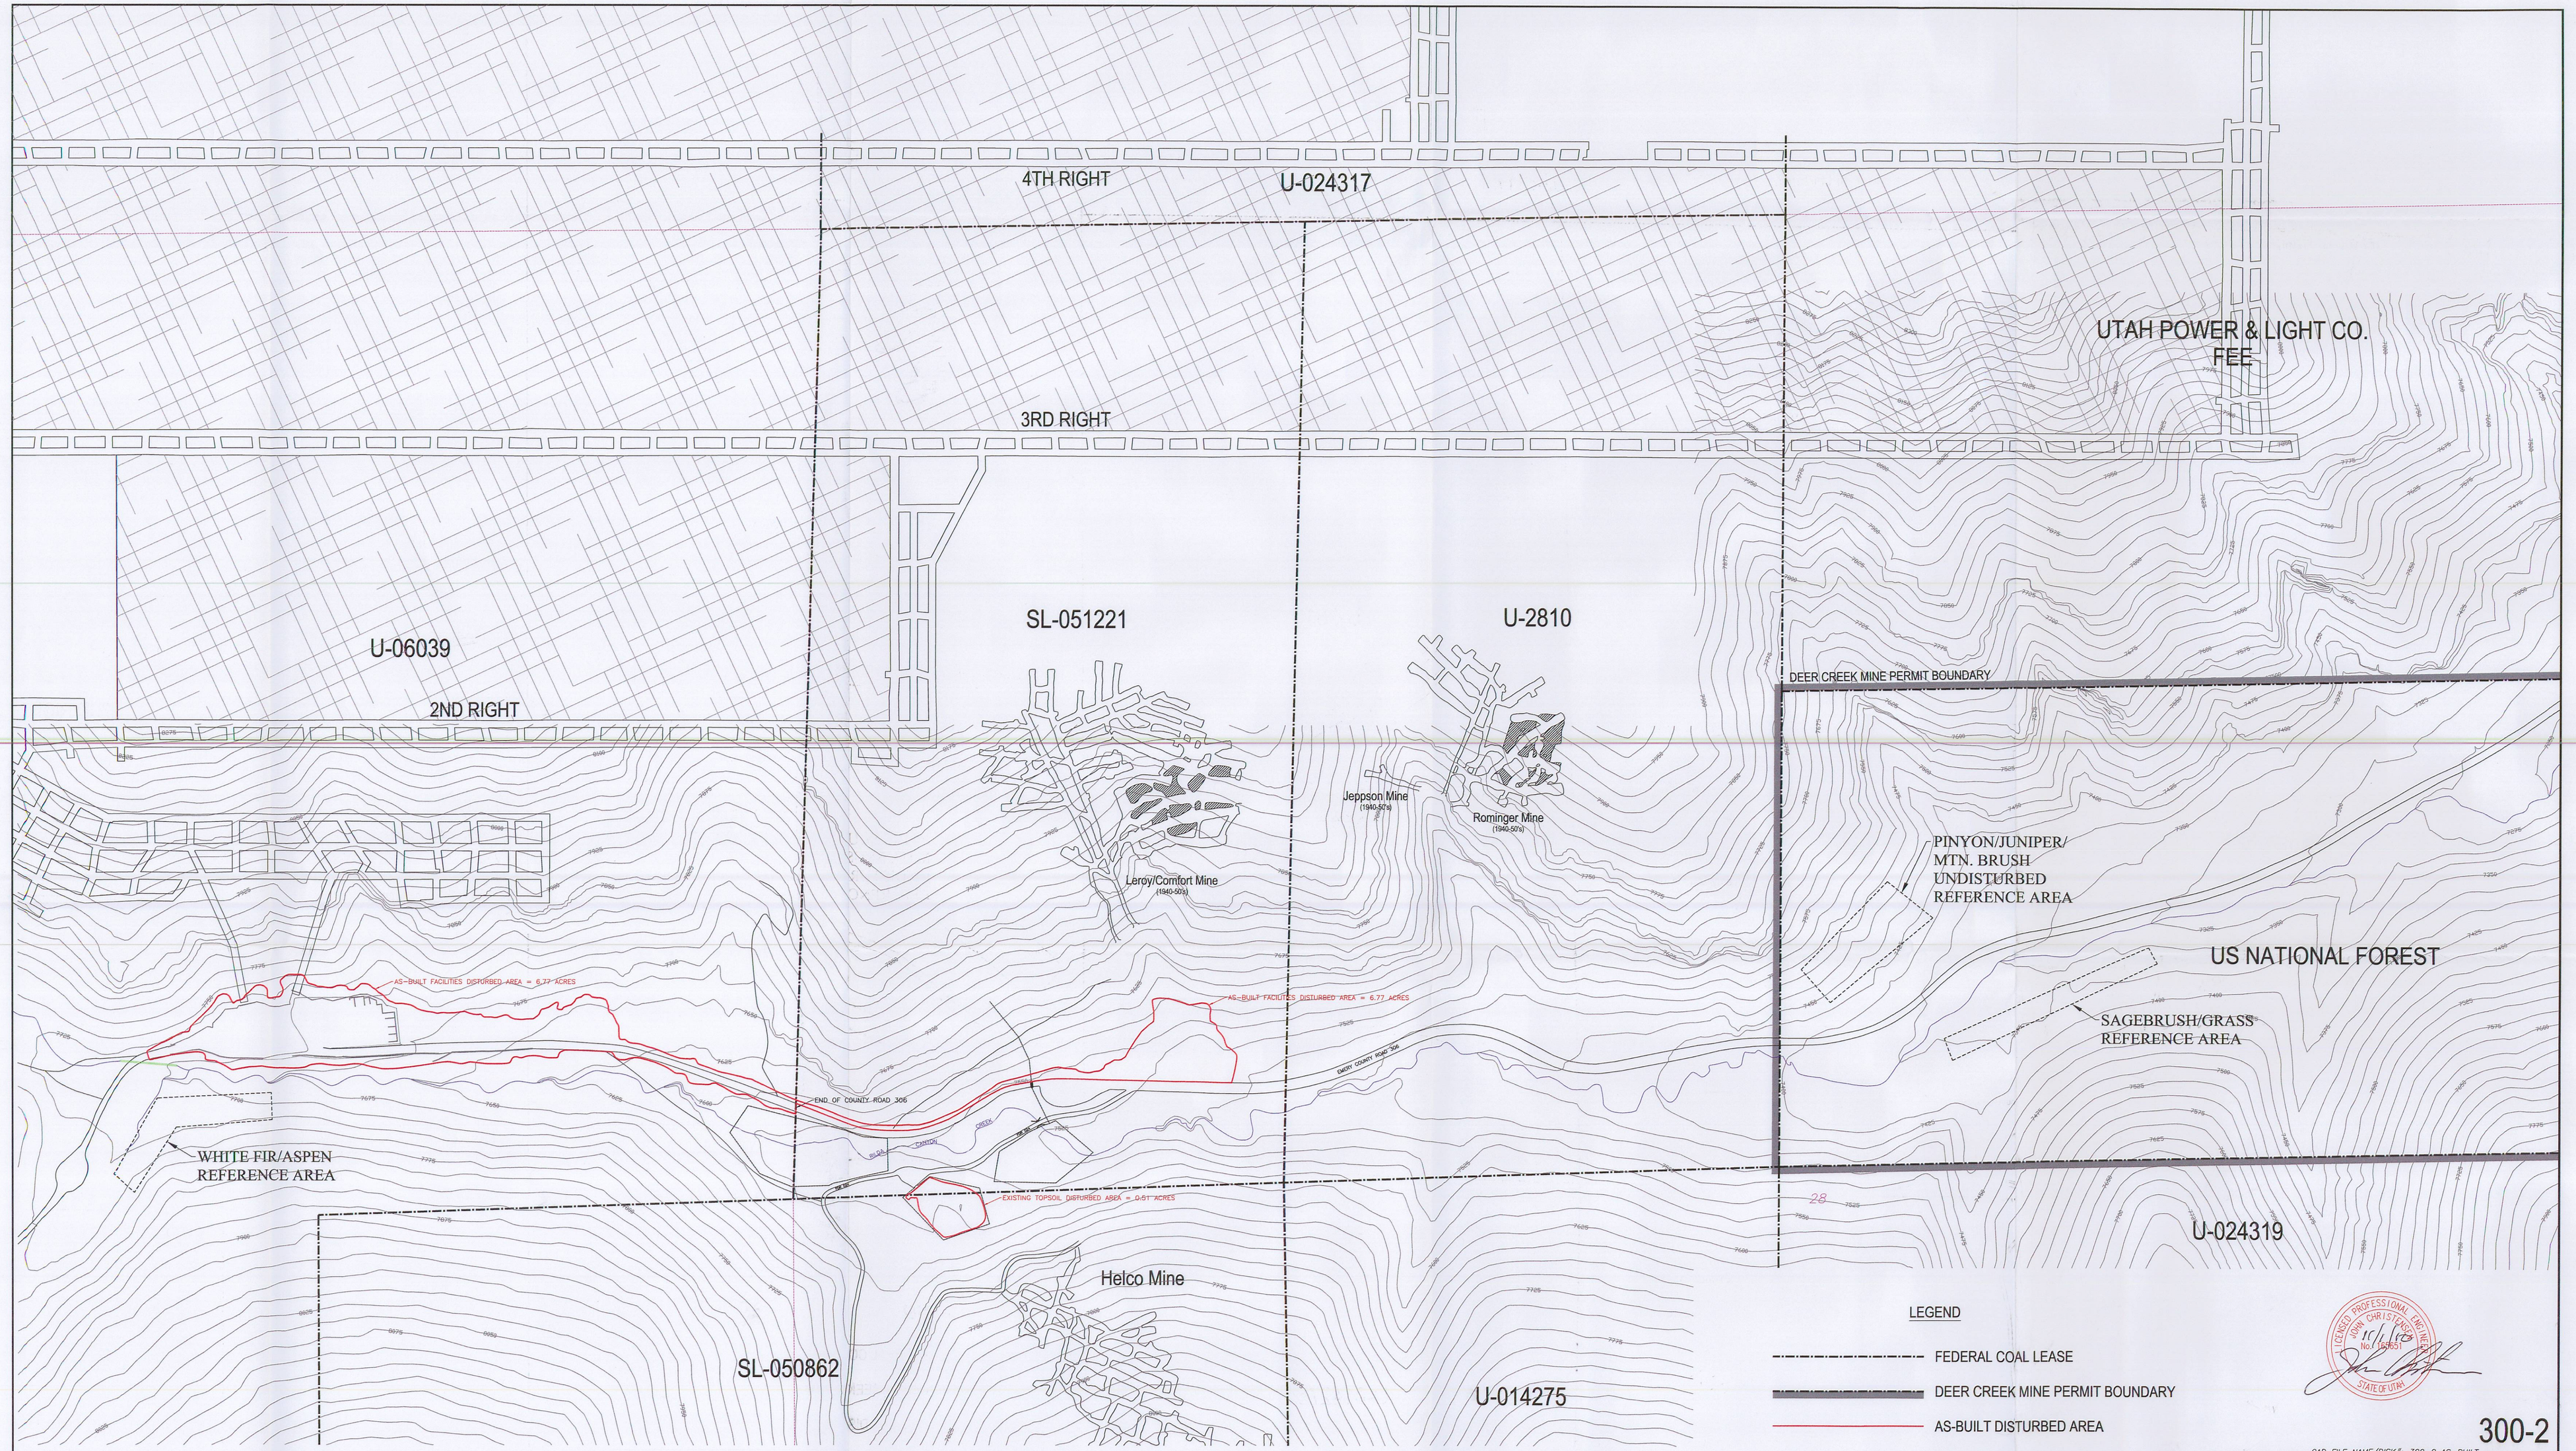

LEGEND

- FEDERAL COAL LEASE
- DEER CREEK MINE PERMIT BOUNDARY
- AS-BUILT DISTURBED AREA

LICENSED PROFESSIONAL ENGINEER
JOHN CHRISTENSEN
No. (156651)
STATE OF UTAH

300-2

CAD FILE NAME/DISK#: 300-2 AS-BUILT

File in:
☐ Confidential
☒ Shelf
☐ Expandable
In C0150018 Incoming
Date: 11/04/2010 For additional information

RECEIVED
NOV 04 2010
DIV. OF OIL, GAS & MINING

ENERGY WEST MINING COMPANY
A SUBSIDIARY OF PACIFICORP

DEER CREEK MINE
RILDA CANYON FACILITIES
VEGETATION REFERENCE AREAS

DATE	REVISION	BY	CHK
2/4/2010	ADDED AS-BUILT DISTURBED AREA BOUNDARY AND FENCE AROUND TOPSOIL PILE	KJL	

DRAWN BY: K. LARSEN		300-2	
SCALE: 1" =200'		DRAWING #:	
DATE: JUNE 16, 2009	SHEET 1 OF 1		REV. 1