DATE	REVISION	BY	CHK
2/4/2010	ADDED AS-BUILT DISTURBED AREA BOUNDARY AND NORTH MILDA CANYON PORTAL FACILITIES	KJL	

DEER CREEK MINE
RILDA CANYON
HISTORICAL MINING

DRAWN BY:	K. LARSEN	SCALE:	1"=200'	DRAWING #:	400-1
CHK		DATE:	JUNE 16, 2009	SHEET 1 OF 1	REV. 1

ENERGY WEST MINING COMPANY
A SUBSIDIARY OF PACIFICORP

RECEIVED
NOV 04 2010
DIV. OF OIL, GAS & MINING

LEGEND

FEDERAL COAL LEASE

PRE-DISTURBED AREA
(AML RECLAIMED 1988)

File in:
- Confidential
- Shelf
- Expandable

Date: 10/26/10 For additional information

400-1

CAD FILE NAME/DISK#: 400-1 AS-BUILT

RECEIVED
JUN 30 2010
DIV. OF OIL, GAS & MINING

RECEIVED
SEP 09 2010
DIV. OF OIL, GAS & MINING
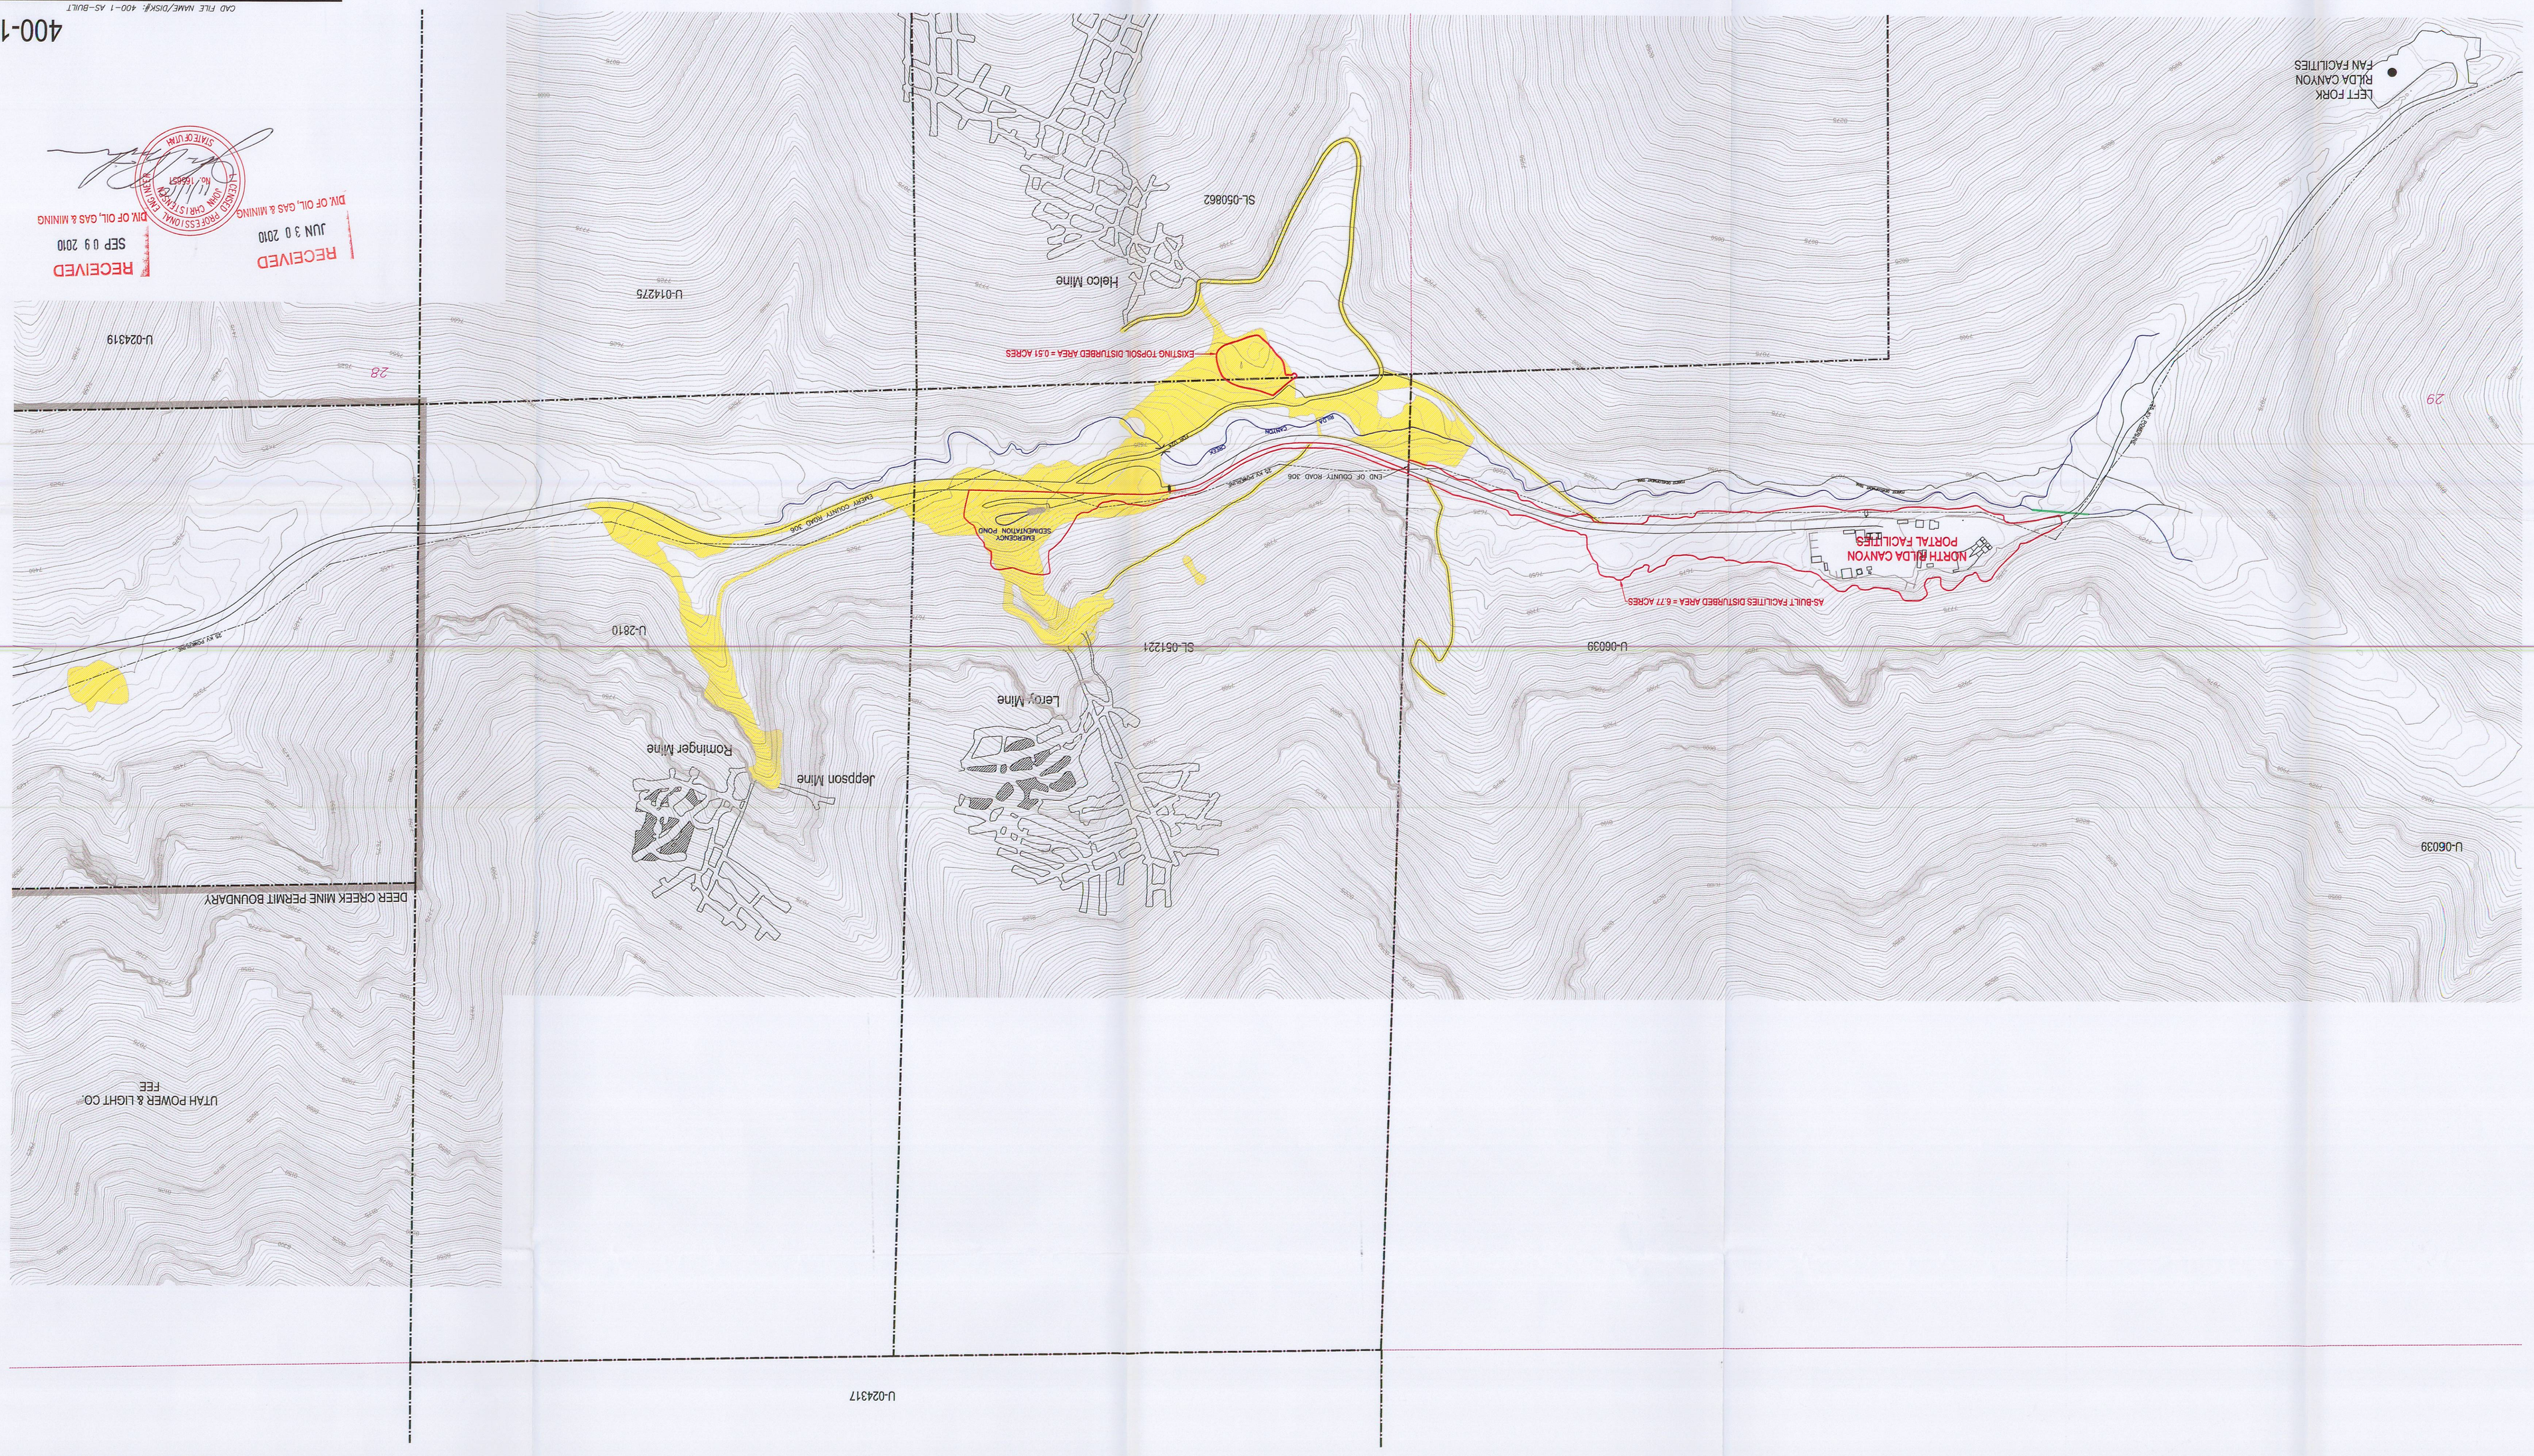
TERRY CARLSTROM
No. 166851
PROFESSIONAL ENGINEER
STATE OF UTAH