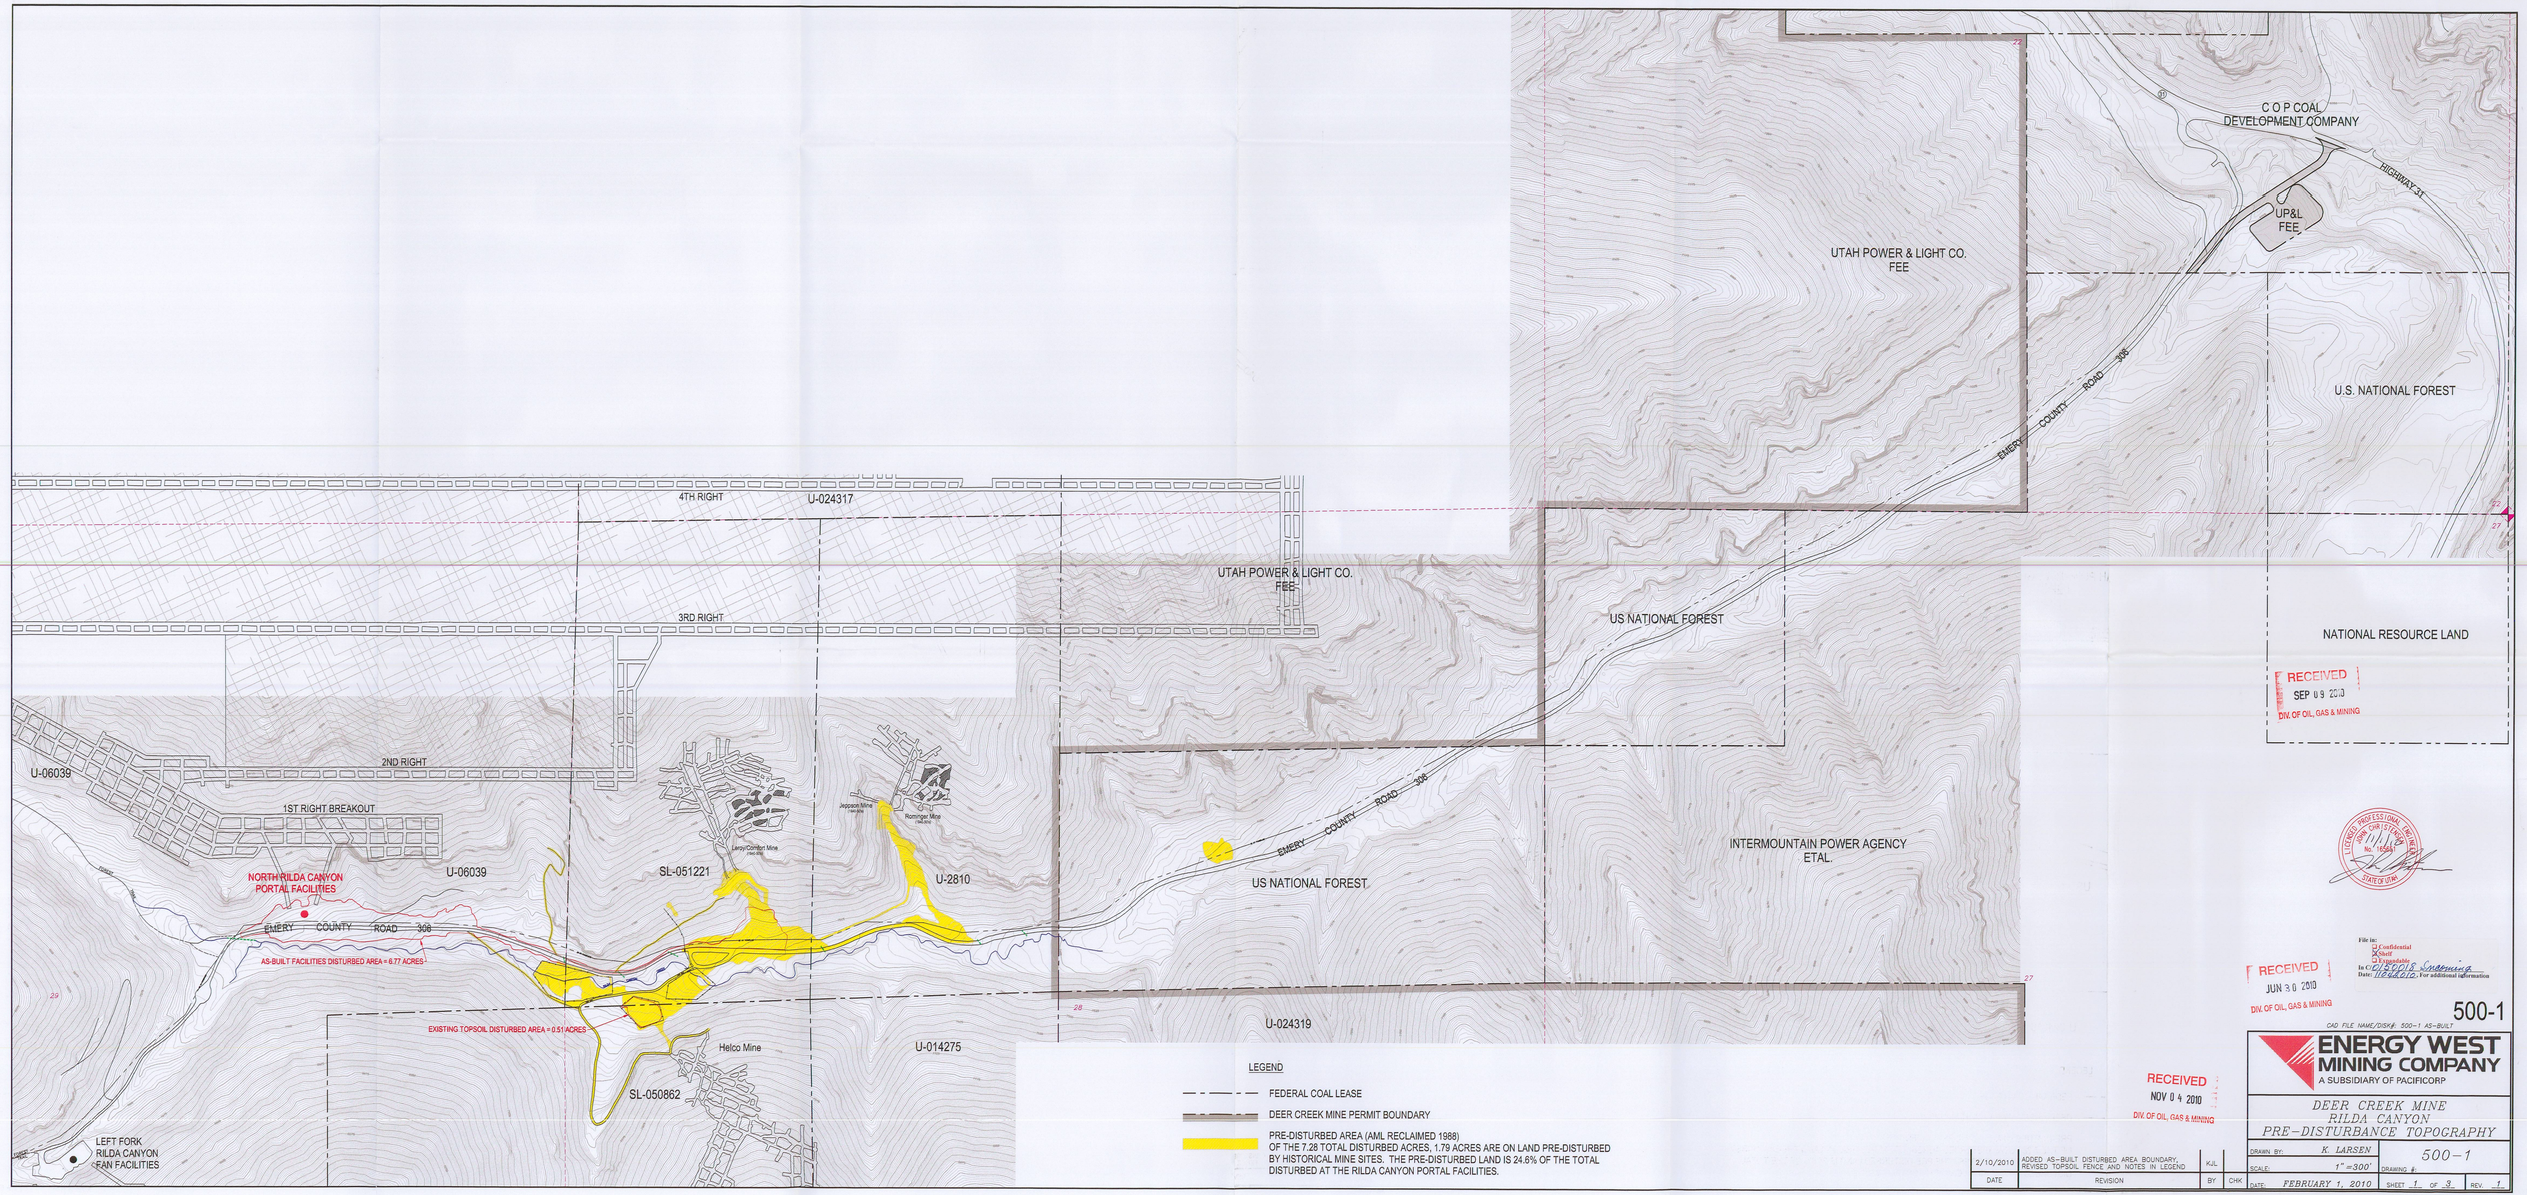

C O P COAL DEVELOPMENT COMPANY
HIGHWAY 31
UP&L FEE
UTAH POWER & LIGHT CO. FEE
U.S. NATIONAL FOREST
EMERY COUNTY ROAD 306
4TH RIGHT
U-024317
UTAH POWER & LIGHT CO. FEE
3RD RIGHT
US NATIONAL FOREST
NATIONAL RESOURCE LAND
2ND RIGHT
U-06039
1ST RIGHT BREAKOUT
NORTH RILDA CANYON PORTAL FACILITIES
U-06039
SL-051221
U-2810
US NATIONAL FOREST
INTERMOUNTAIN POWER AGENCY ETAL.
EMERY COUNTY ROAD 306
AS-BUILT FACILITIES DISTURBED AREA = 6.77 ACRES
EXISTING TOPSOIL DISTURBED AREA = 0.51 ACRES
Helco Mine
U-014275
U-024319
SL-050862
LEFT FORK RILDA CANYON FAN FACILITIES
LEGEND
FEDERAL COAL LEASE
DEER CREEK MINE PERMIT BOUNDARY
PRE-DISTURBED AREA (AML RECLAIMED 1988) OF THE 7.28 TOTAL DISTURBED ACRES, 1.79 ACRES ARE ON LAND PRE-DISTURBED BY HISTORICAL MINE SITES. THE PRE-DISTURBED LAND IS 24.6% OF THE TOTAL DISTURBED AT THE RILDA CANYON PORTAL FACILITIES.
RECEIVED SEP 09 2010 DIV. OF OIL, GAS & MINING
RECEIVED JUN 30 2010 DIV. OF OIL, GAS & MINING
RECEIVED NOV 04 2010 DIV. OF OIL, GAS & MINING
File in: Confidential Shelf Expandable
In C/C 0130018 Incoming
Date: 11/04/2010 For additional information
500-1
CAD FILE NAME/DISK#: 500-1 AS-BUILT
ENERGY WEST MINING COMPANY
A SUBSIDIARY OF PACIFICORP
DEER CREEK MINE
RILDA CANYON
PRE-DISTURBANCE TOPOGRAPHY
DRAWN BY: K. LARSEN
SCALE: 1"=300'
DATE: FEBRUARY 1, 2010
DRAWING #: 500-1
SHEET 1 OF 3
REV. 1
2/10/2010 ADDED AS-BUILT DISTURBED AREA BOUNDARY, REVISED TOPSOIL FENCE AND NOTES IN LEGEND KJL
DATE REVISION BY CHK