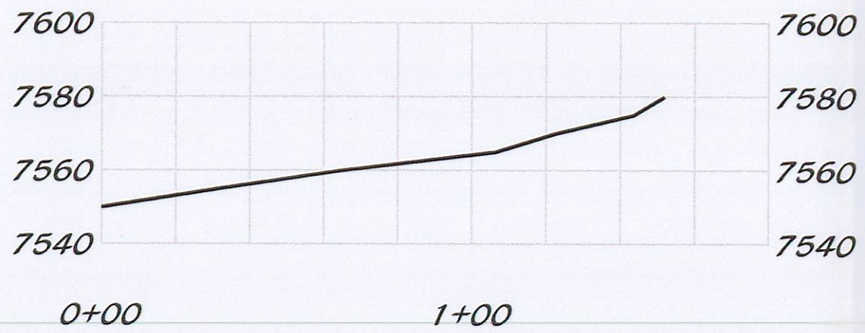

2+50

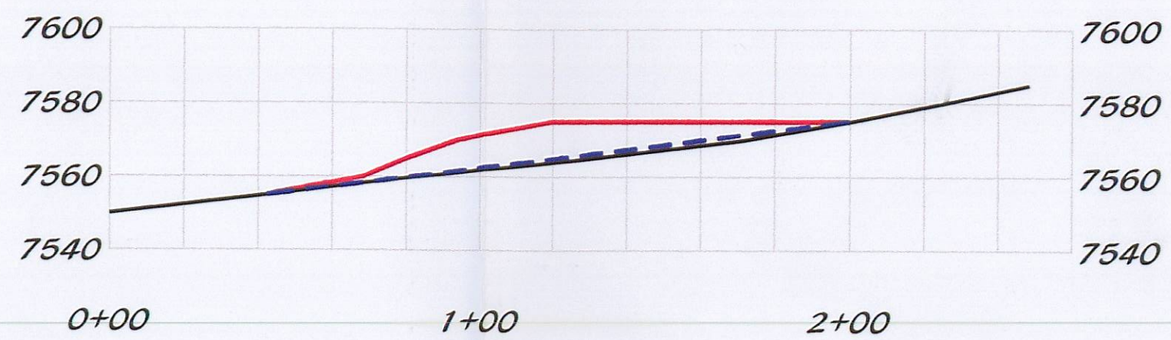

1+00

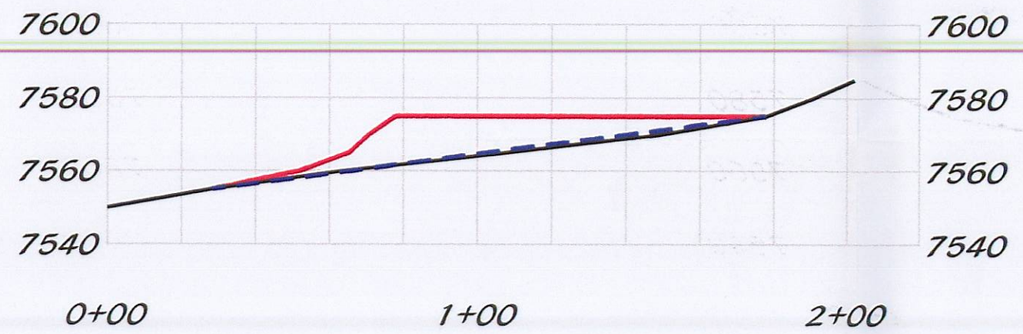

2+00

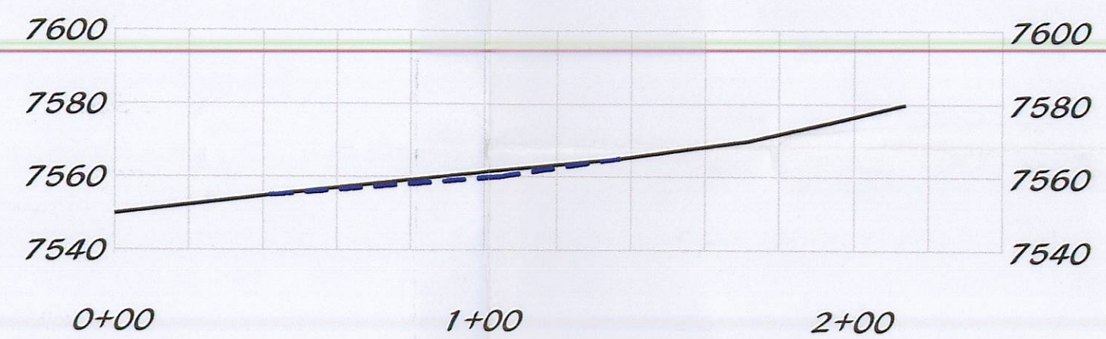

0+50

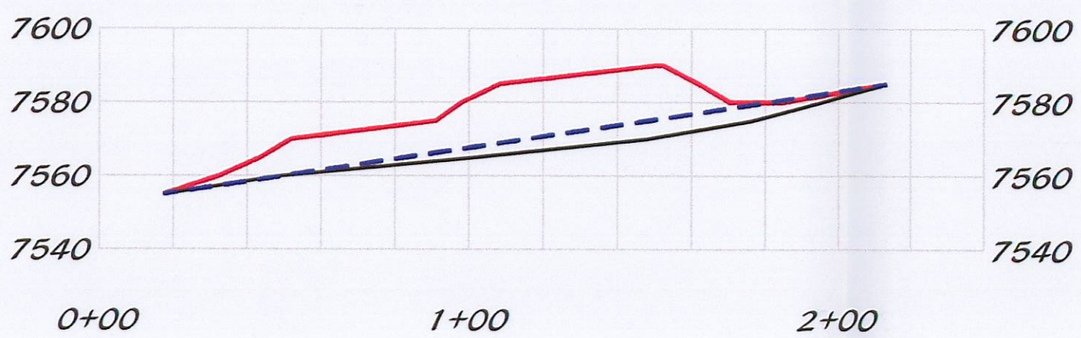

1+50

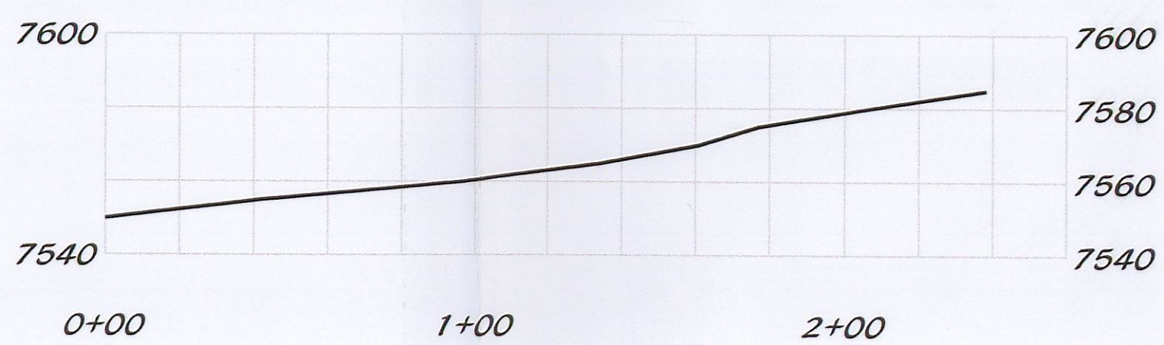

0+00

RECEIVED
SEP 09 2010
DIV. OF OIL, GAS & MINING

File in:
☐ Confidential
☒ Shelf
☐ Expandable
In C/0150018 Incoming
Date: 11/04/2010 For additional information

500-4

CAD FILE NAME/DISK#: 500-4 AS-BUILT

LICENSED PROFESSIONAL ENGINEER
JOHN CHRISTENSEN
No. 165651
STATE OF UTAH

NOTES

1. PRE-EXISTING LINE REPRESENTS FINAL RECLAMATION (NO PLANNED EXCAVATION DURING DEVELOPMENT OF SOIL STORAGE PILES)
2. CROSS SECTIONS REFERENCE FROM 500-3

LEGEND

- PRE-EXISTING LINE
- POST CONSTRUCTION LINE
- FINAL RECLAMATION LINE

RECEIVED
NOV 04 2010
DIV. OF OIL, GAS & MINING

DATE	REVISION	BY	CHK
2/19/2010	REVISED TO REFLECT THE AS-BUILT CONDITIONS	KJL	

ENERGY WEST MINING COMPANY
A SUBSIDIARY OF PACIFICORP

DEER CREEK MINE
RILDA CANYON FACILITIES
TOPSOIL STORAGE CROSS SECTIONS

DRAWN BY: K. LARSEN
SCALE: 1" =40'
DATE: MARCH 25, 2009
DRAWING #: 500-4
SHEET 3 OF 4
REV. 1