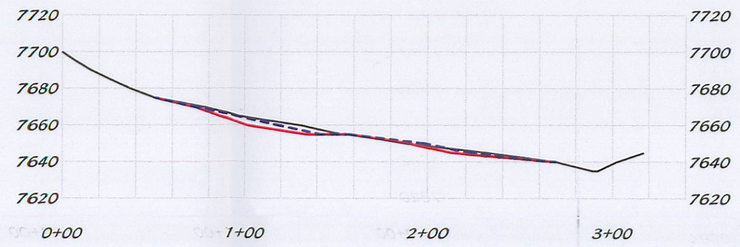

9+50

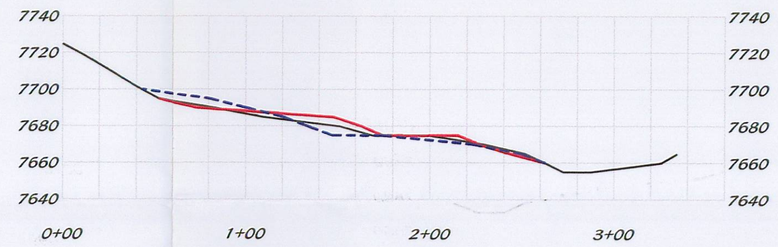

7+00

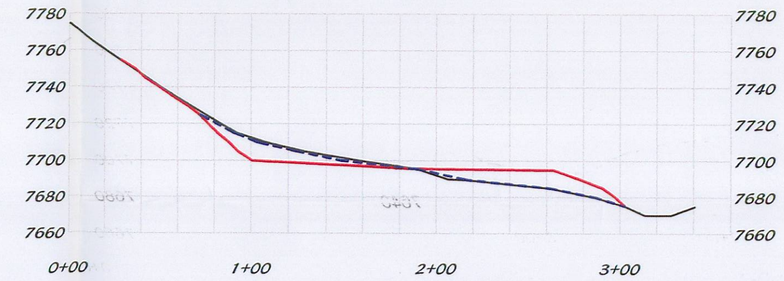

4+50

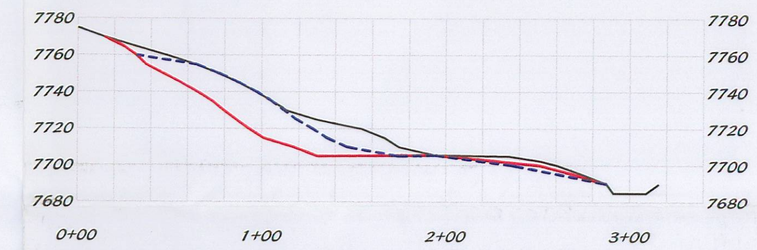

2+00

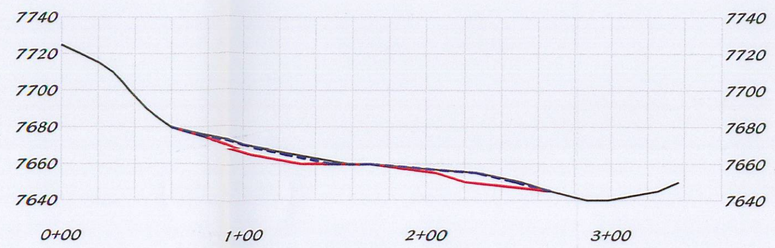

9+00

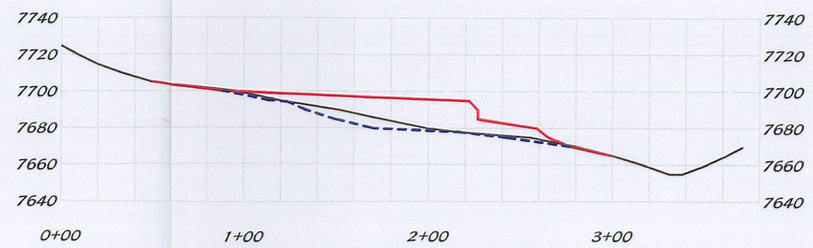

6+50

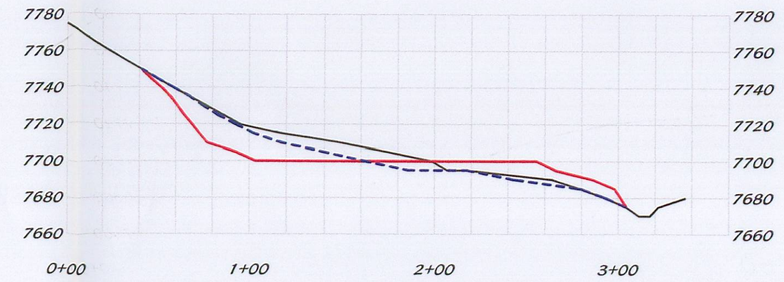

4+00

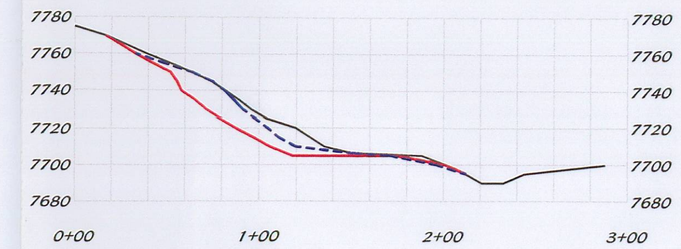

1+50

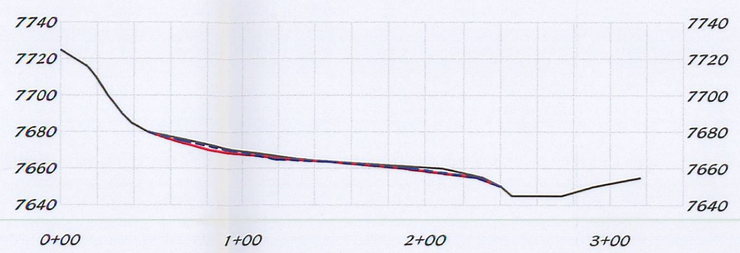

8+50

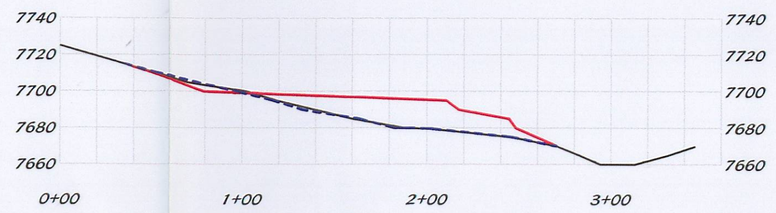

6+00

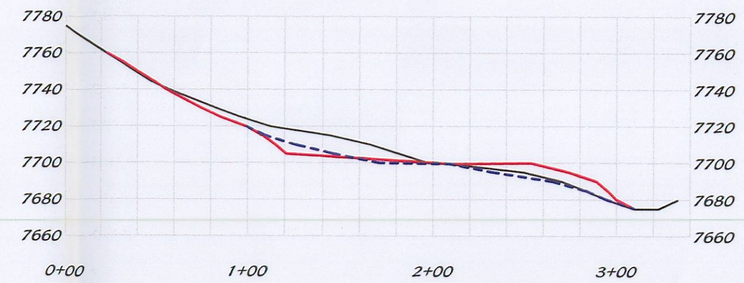

3+50

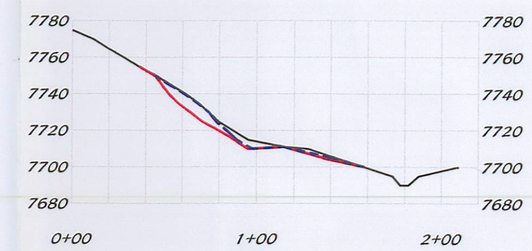

1+00

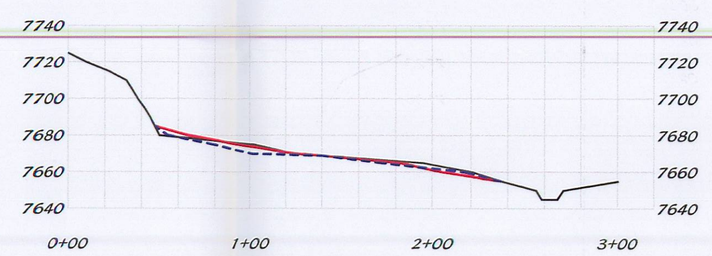

8+00

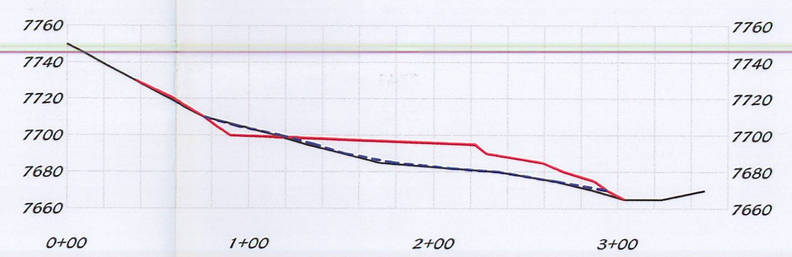

5+50

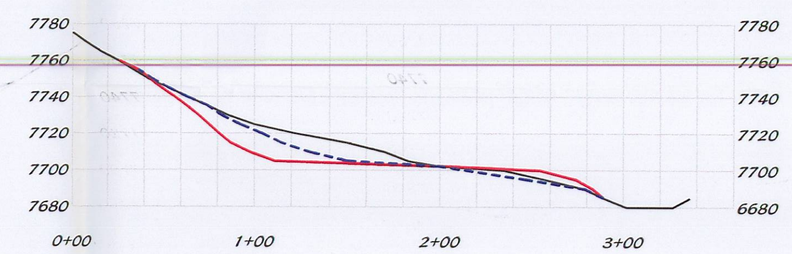

3+00

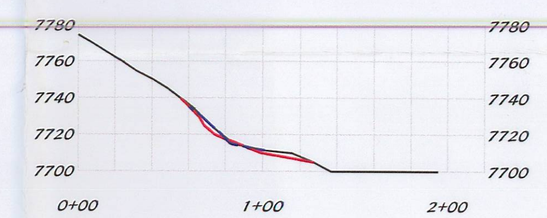

0+50

RECEIVED
SEP 09 2010
DIV. OF OIL, GAS & MINING

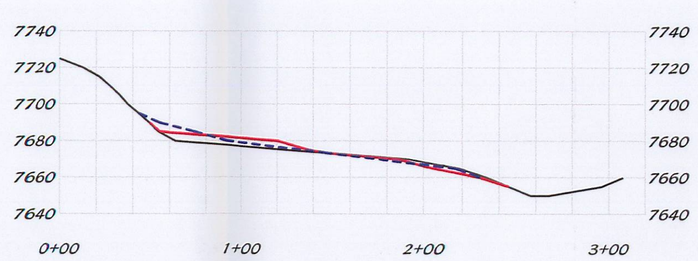

7+50

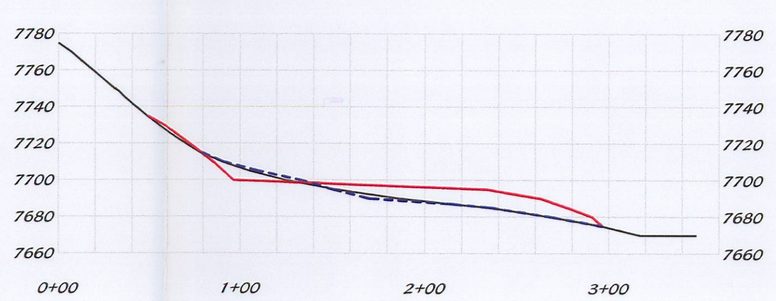

5+00

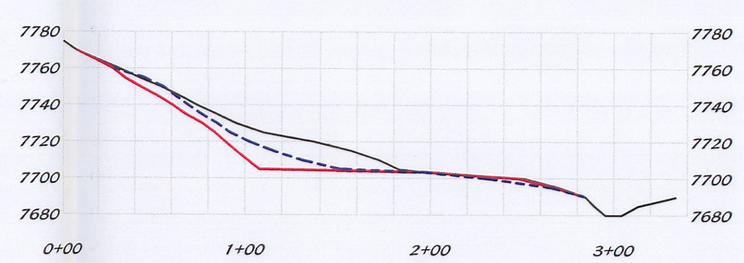

2+50

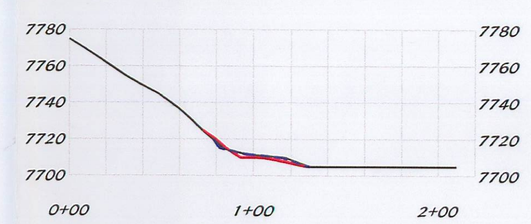

0+00

RECEIVED
JUN 30 2010
DIV. OF OIL, GAS & MINING

500-4

CAD FILE NAME/DISK#: 500-4 AS-BUILT

File in:
☐ Confidential
☒ Shelf
☐ Expandable

In C0150018 Incoming
Date: 11/04/2010 For additional information

LICENSED PROFESSIONAL ENGINEER
JOHN CHRIS STARR
No. 156847
STATE OF UTAH

NOTES

1. CROSS SECTIONS REFERENCE FROM 500-3
2. REFER TO VOLUME 11 APPENDIX VOLUME ENGINEERING APPENDIX F FOR SLOPE STABILITY ANALYSIS

LEGEND

PRE-EXISTING LINE
POST CONSTRUCTION LINE
FINAL RECLAMATION LINE

RECEIVED
NOV 04 2010
DIV. OF OIL, GAS & MINING

DATE	REVISION	BY	CHK
2/19/2010	REVISED TO REFLECT THE AS-BUILT CONDITIONS	KJL	

ENERGY WEST MINING COMPANY
A SUBSIDIARY OF PACIFICORP

DEER CREEK MINE
RILDA CANYON FACILITIES
CROSS SECTIONS

DRAWN BY: K. LARSEN		500-4	
SCALE: 1"=60'	DRAWING #:		
DATE: MARCH 25, 2009	SHEET 1 OF 4		REV. 1