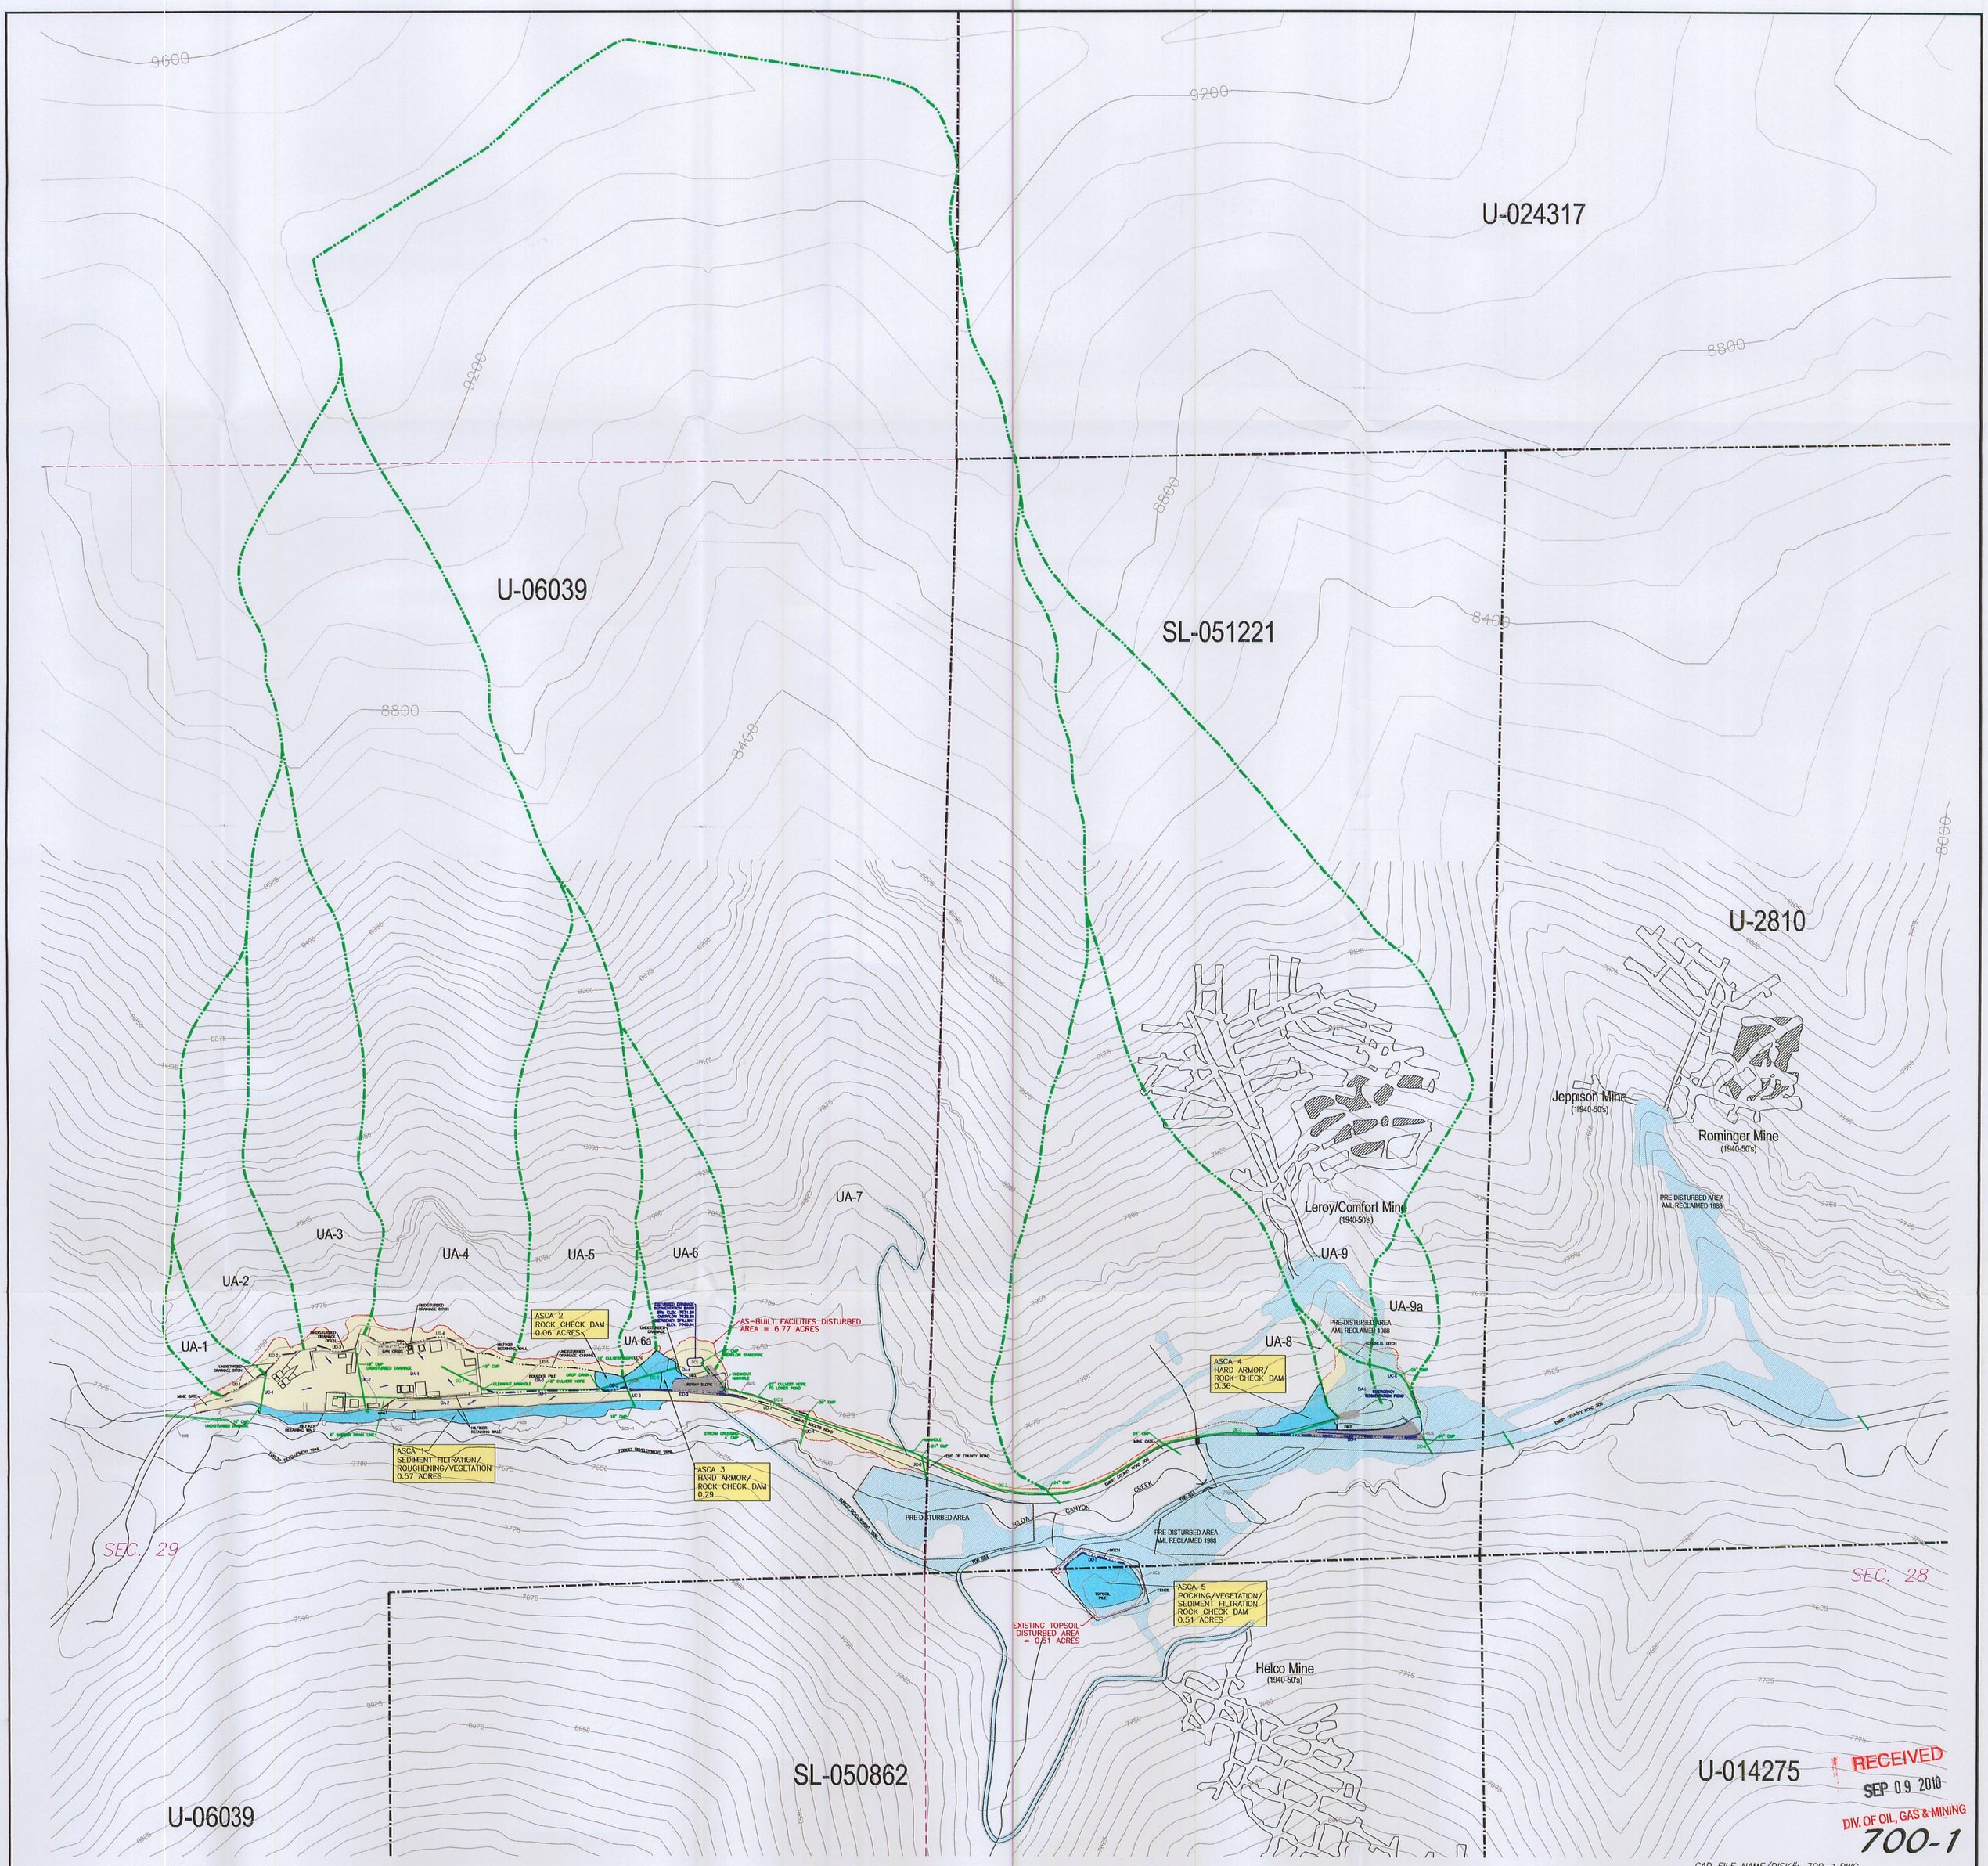

Legend:

- Undisturbed Drainage Area
- UA-5a (Numbers Report to Bypass Culverts)
- Disturbed Area Ditch
- Undisturbed Area Ditch
- Direction of Flow
- As-Built Disturbed Area
- Pre-Disturbance Area
- Jersey Barrier
- Drop Inlet
- Culvert
- Rip Rap
- Fence
- Dirt Berm
- SCS Sediment Control Structure

LICENSED PROFESSIONAL ENGINEER
JOHN CHRISTENSEN
No. 155651
STATE OF UTAH

File in:
☐ Confidential
☒ Shelf
☐ Expandable
Date Folder 11042010_C0150018
See: Incoming For additional

RECEIVED
NOV 04 2010
DIV. OF OIL, GAS & MINING

RECEIVED
JUN 30 2010
DIV. OF OIL, GAS & MINING

RECEIVED
SEP 09 2010
DIV. OF OIL, GAS & MINING

700-1

CAD FILE NAME/DISK#: 700-1.DWG

DATE	REVISION	BY	CHK
6/16/2010	REVISED TO REFLECT THE AS-BUILT CONDITIONS, DISTURBED AREA BOUNDARY AND TOPOGRAPHY	KJL	

ENERGY WEST MINING COMPANY
A SUBSIDIARY OF PACIFICORP

DEER CREEK MINE
RILDA CANYON FACILITIES
DRAINAGE AREA MAP

DRAWN BY: K. LARSEN
SCALE: 1" =200'
DATE: AUGUST 25, 2004
DRAWING #: 700-1
SHEET 1 OF 1
REV. ___