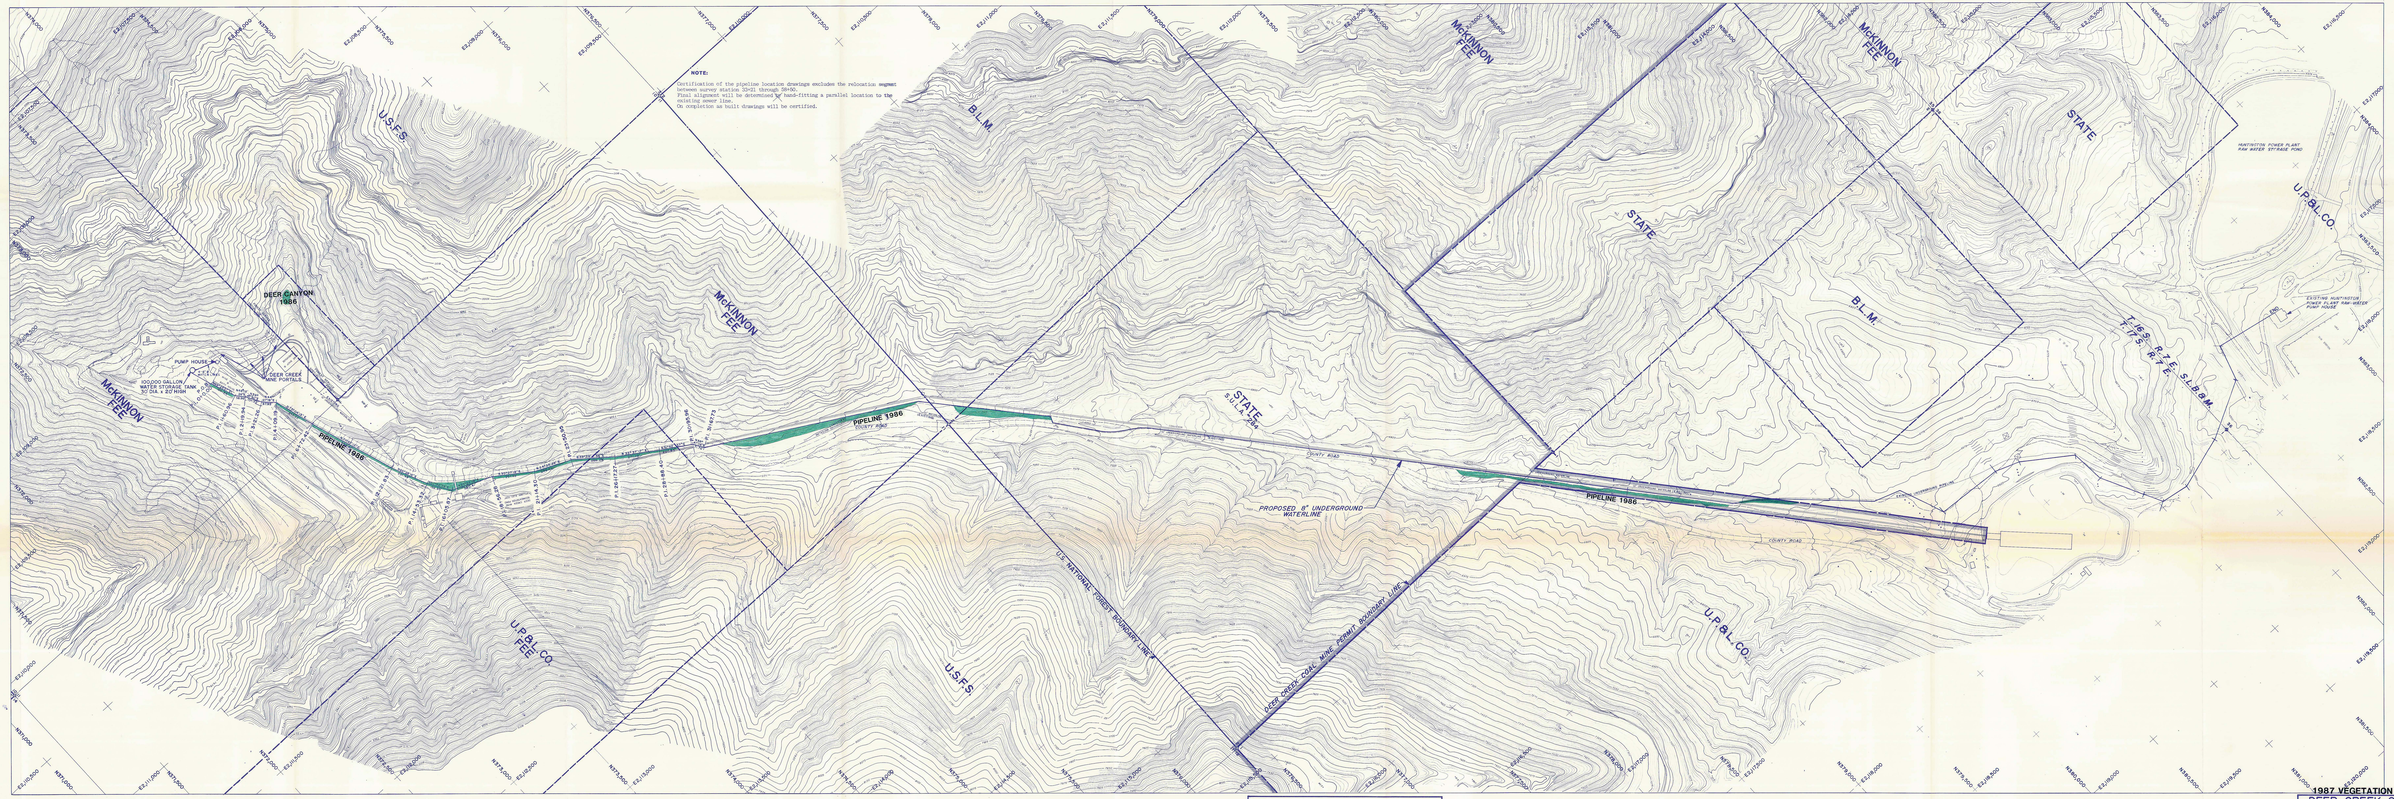

NOTE:

Certification of the pipeline location drawings excludes the relocation segment between survey station 20+21 through 58+50.
Final alignment will be determined by hand-fitting a parallel location to the existing sewer line.
On completion as built drawings will be certified.

LEGEND

- U.P.&L. Co. PERMIT BOUNDARY
- FOREST SERVICE BOUNDARY
- SURFACE OWNERSHIP BOUNDARY
- SECTION CORNER
- FOUND SECTION CORNER

(SALT LAKE BASE & MERIDIAN)

DATE	REVISIONS	BY	CHK.
8/11/86	REVISED PIPE LOCATION BETWEEN STA. 20+00 & STA. 23+00, & BETWEEN STA. 57+00 & STA. 101+00 AS PER FIELD PIT	CBW	


DEER CREEK COAL MINE
EMERY COUNTY, UTAH

LAYOUT & PLAN VIEW
OF THE 8" UNDERGROUND PIPELINE
HUNTINGTON POND TO DEER CREEK MINE

UTAH POWER & LIGHT COMPANY
DEPARTMENT OF MINING AND EXPLORATION

DRAWN BY: C. WETZLER	CHECKED BY: J.C.	DATE: APRIL 08, 1986	
SCALE: 1" = 200'	SHEET NO. 1 of 1	DRAWING NUMBER: CM-10673-DR	