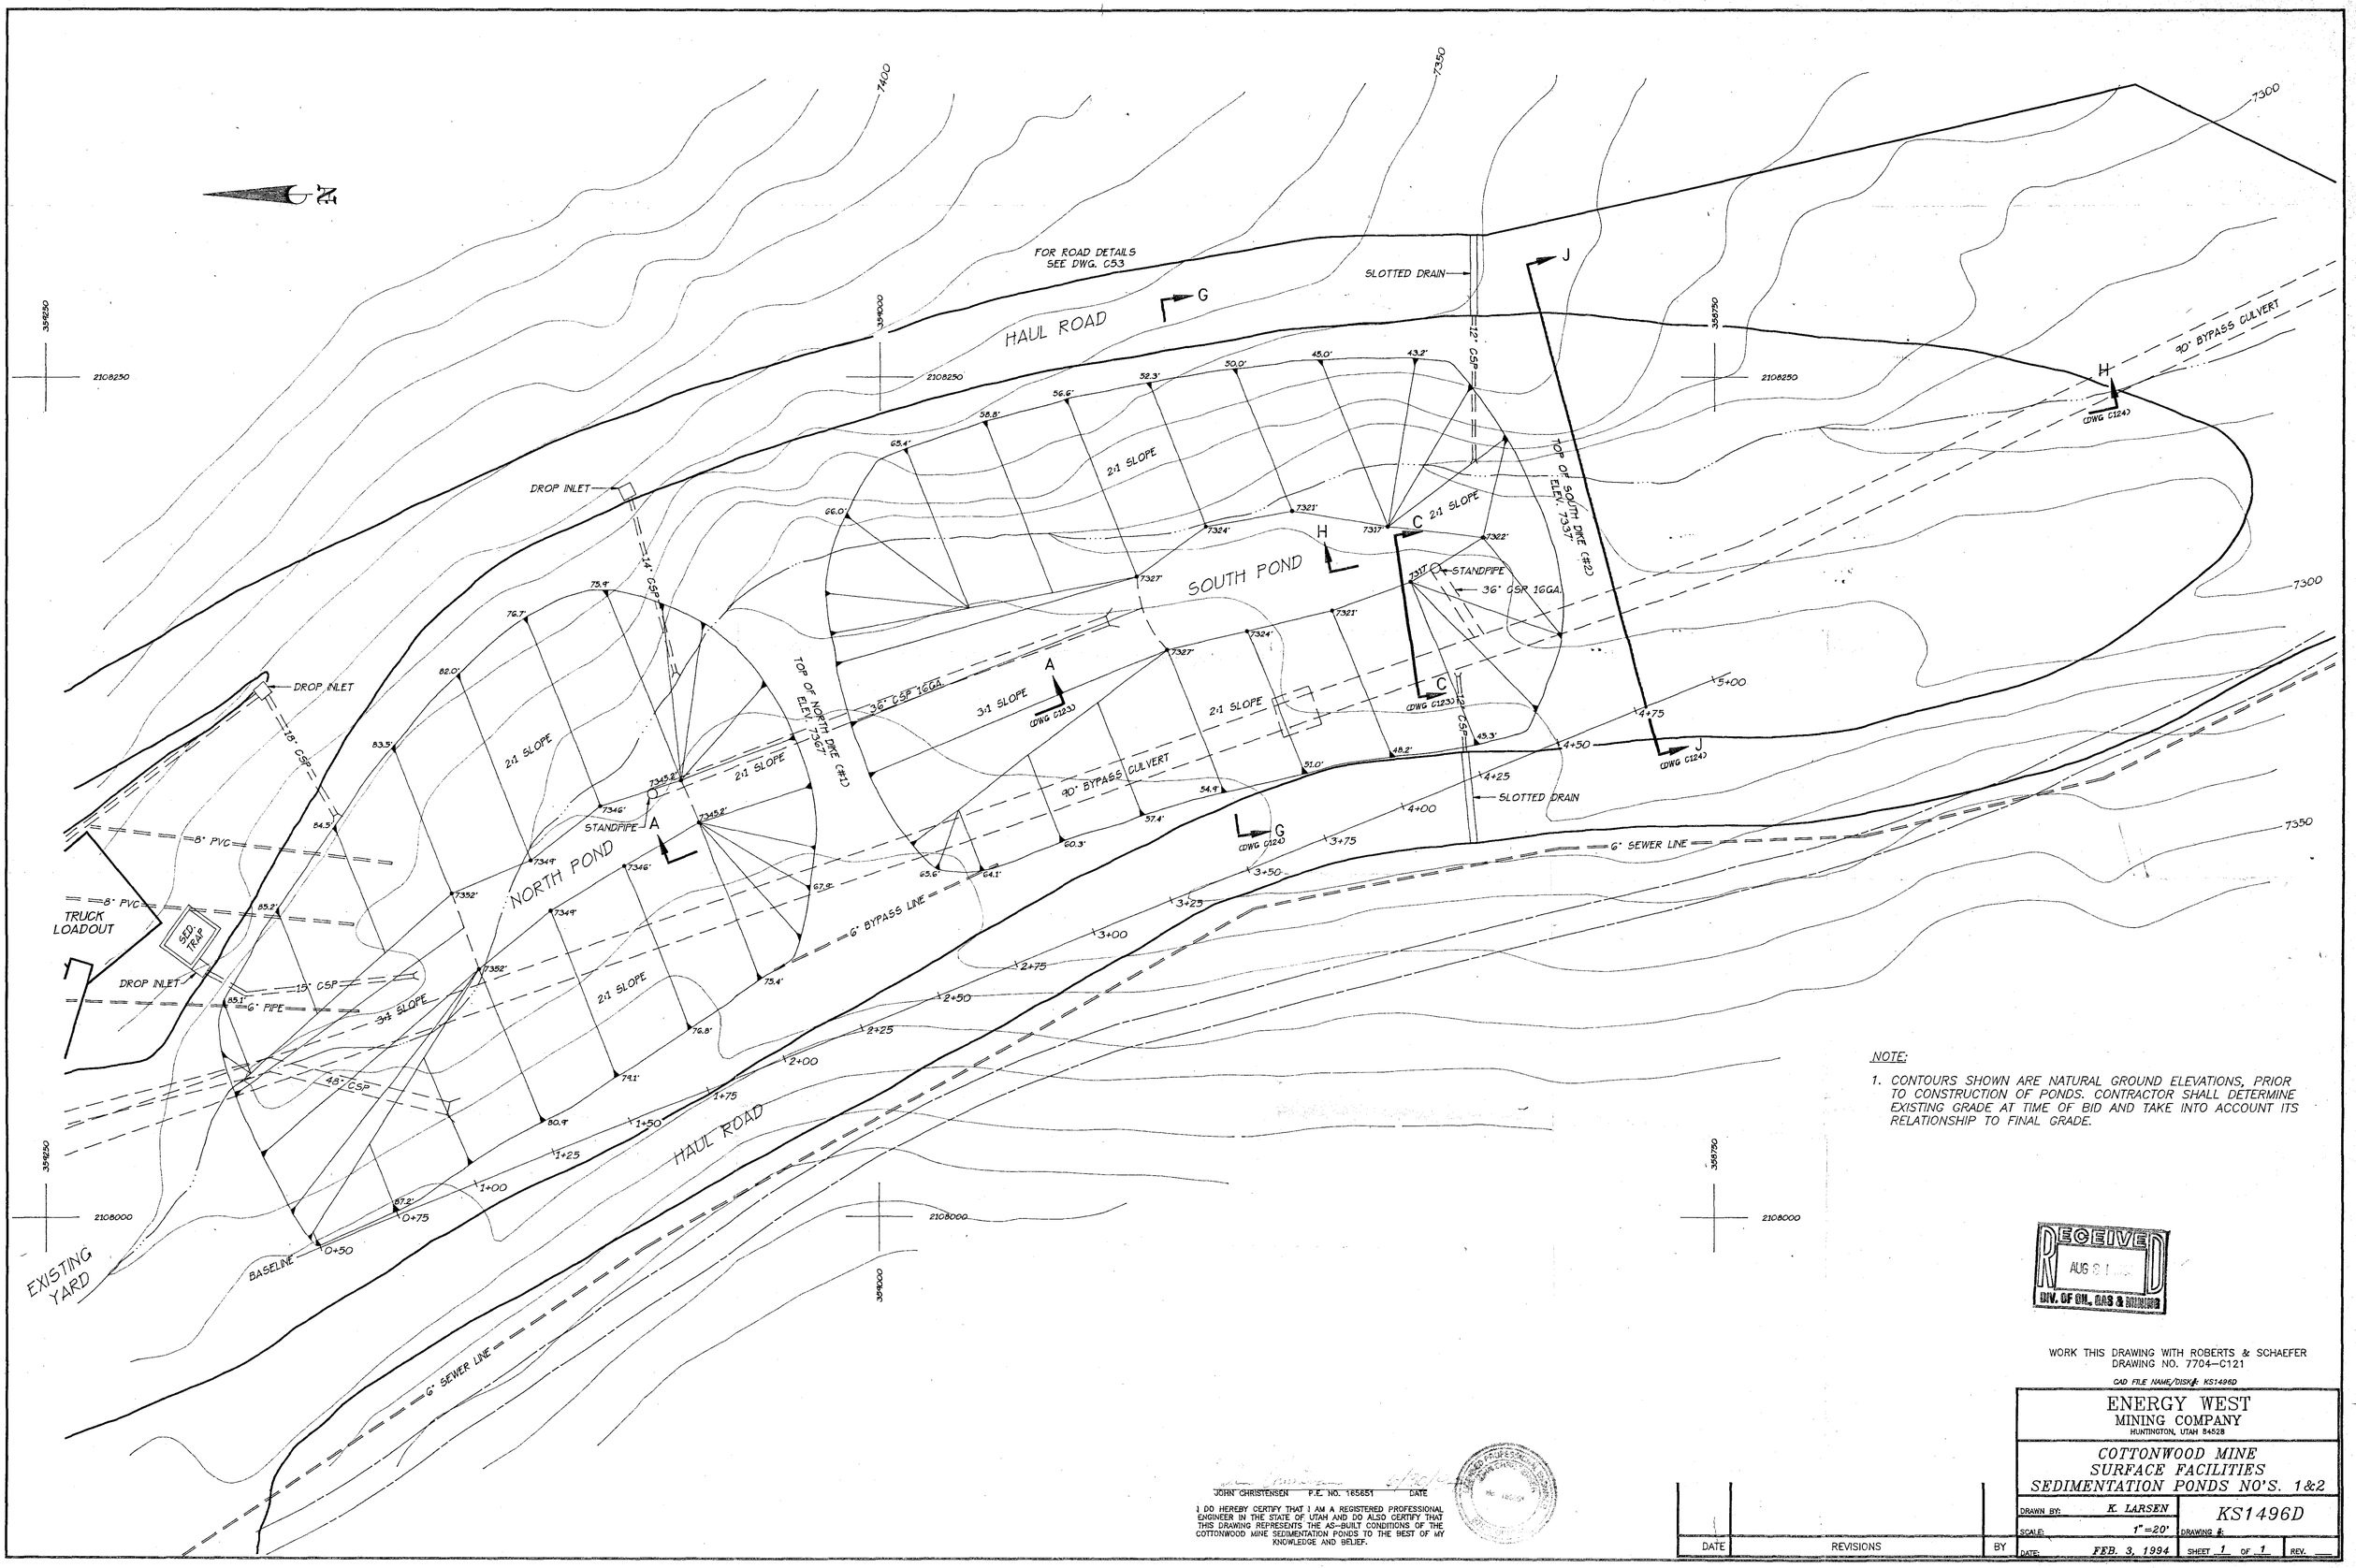

NOTE:

1. CONTOURS SHOWN ARE NATURAL GROUND ELEVATIONS, PRIOR TO CONSTRUCTION OF PONDS. CONTRACTOR SHALL DETERMINE EXISTING GRADE AT TIME OF BID AND TAKE INTO ACCOUNT ITS RELATIONSHIP TO FINAL GRADE.

RECEIVED
AUG 2 1
DIV. OF OIL, GAS & MINING

WORK THIS DRAWING WITH ROBERTS & SCHAEFER DRAWING NO. 7704-C121

CAD FILE NAME/DISK#: KS1496D

ENERGY WEST
MINING COMPANY
HUNTINGTON, UTAH 84528

COTTONWOOD MINE
SURFACE FACILITIES
SEDIMENTATION PONDS NO'S. 1&2

DRAWN BY: K. LARSEN
SCALE: 1"=20'
DATE: FEB. 3, 1994
DRAWING #: KS1496D
SHEET 1 OF 1
REV. ___

DATE	REVISIONS	BY

JOHN CHRISTENSEN P.E. NO. 165651 DATE

I DO HEREBY CERTIFY THAT I AM A REGISTERED PROFESSIONAL ENGINEER IN THE STATE OF UTAH AND DO ALSO CERTIFY THAT THIS DRAWING REPRESENTS THE AS-BUILT CONDITIONS OF THE COTTONWOOD MINE SEDIMENTATION PONDS TO THE BEST OF MY KNOWLEDGE AND BELIEF.