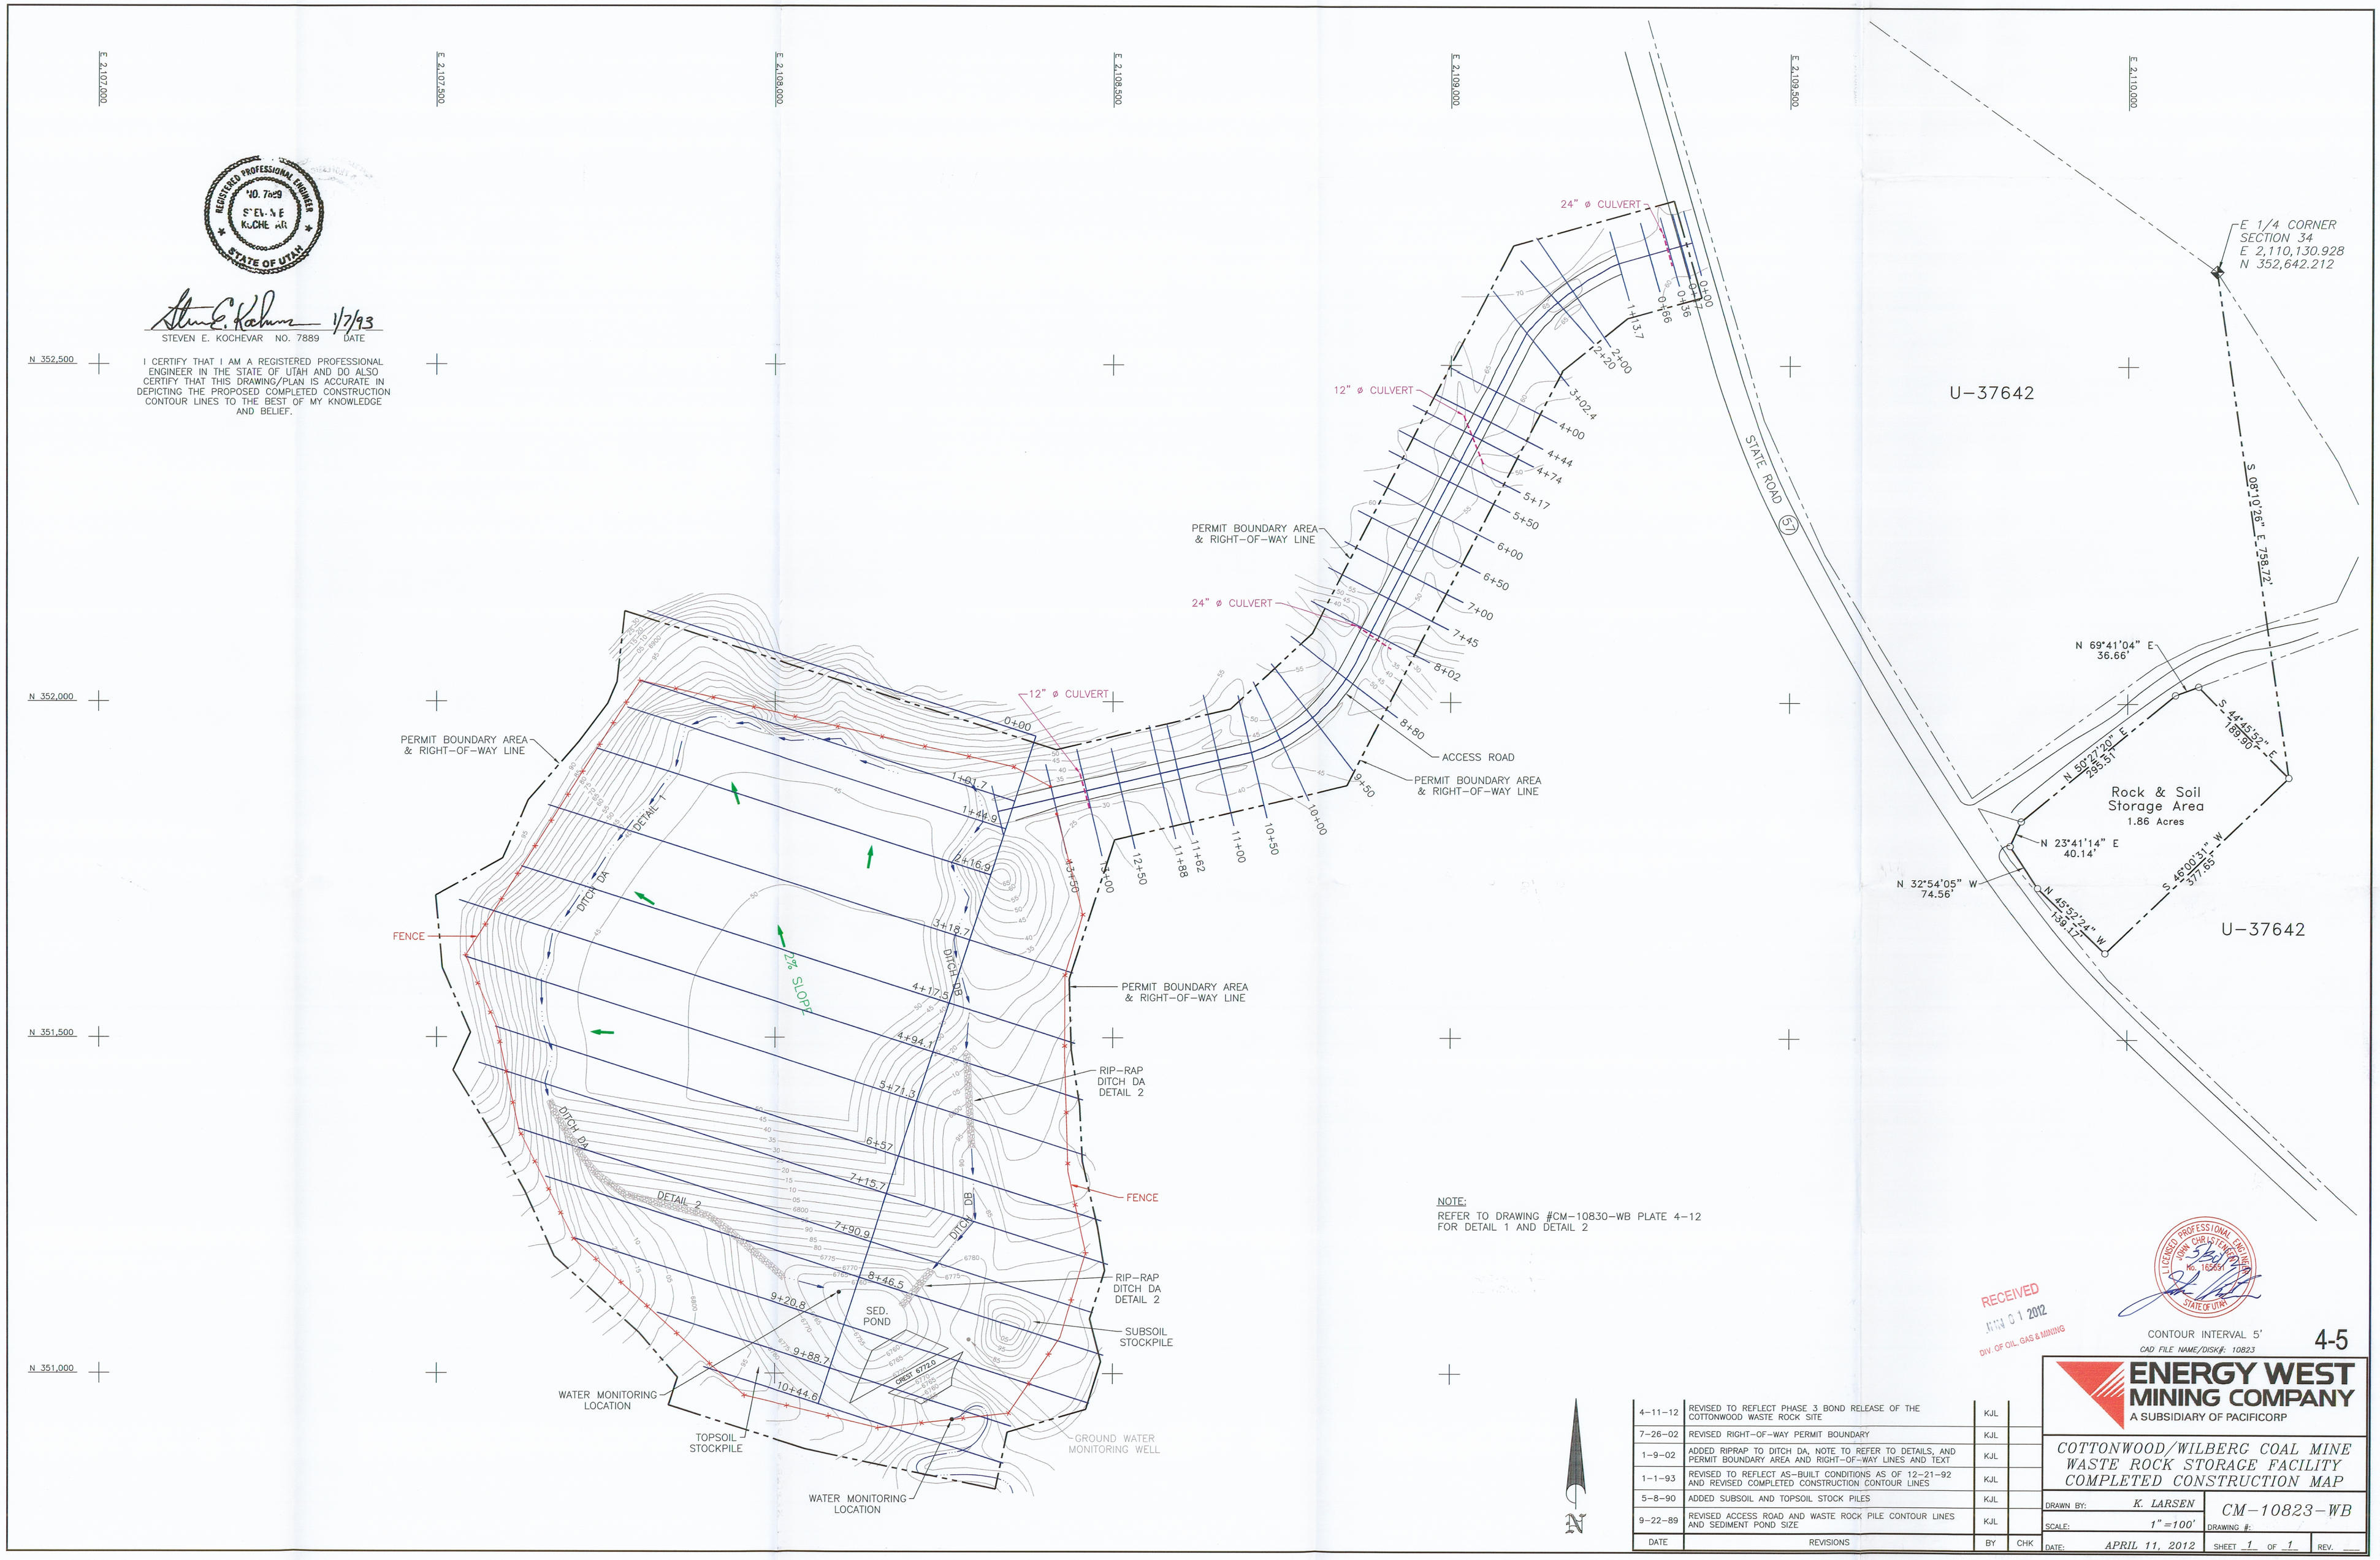

DATE	REVISIONS	BY	CHK
4-11-12	REVISED TO REFLECT PHASE 3 BOND RELEASE OF THE COTTONWOOD WASTE ROCK SITE	KJL	
7-26-02	REVISED RIGHT-OF-WAY PERMIT BOUNDARY	KJL	
1-9-02	ADDED RIPRAP TO DITCH DA, NOTE TO REFER TO DETAILS, AND PERMIT BOUNDARY AREA AND RIGHT-OF-WAY LINES AND TEXT	KJL	
1-1-93	REVISED TO REFLECT AS-BUILT CONDITIONS AS OF 12-21-92 AND REVISED COMPLETED CONSTRUCTION CONTOUR LINES	KJL	
5-8-90	ADDED SUBSOIL AND TOPSOIL STOCK PILES	KJL	
9-22-89	REVISED ACCESS ROAD AND WASTE ROCK PILE CONTOUR LINES AND SEDIMENT POND SIZE	KJL	

ENERGY WEST MINING COMPANY
A SUBSIDIARY OF PACIFICORP

COTTONWOOD/WILBERG COAL MINE
WASTE ROCK STORAGE FACILITY
COMPLETED CONSTRUCTION MAP

DRAWN BY:	K. LARSEN	CM-10823-WB	
SCALE:	1"=100'	DRAWING #:	
DATE:	APRIL 11, 2012	SHEET 1 OF 1	REV.