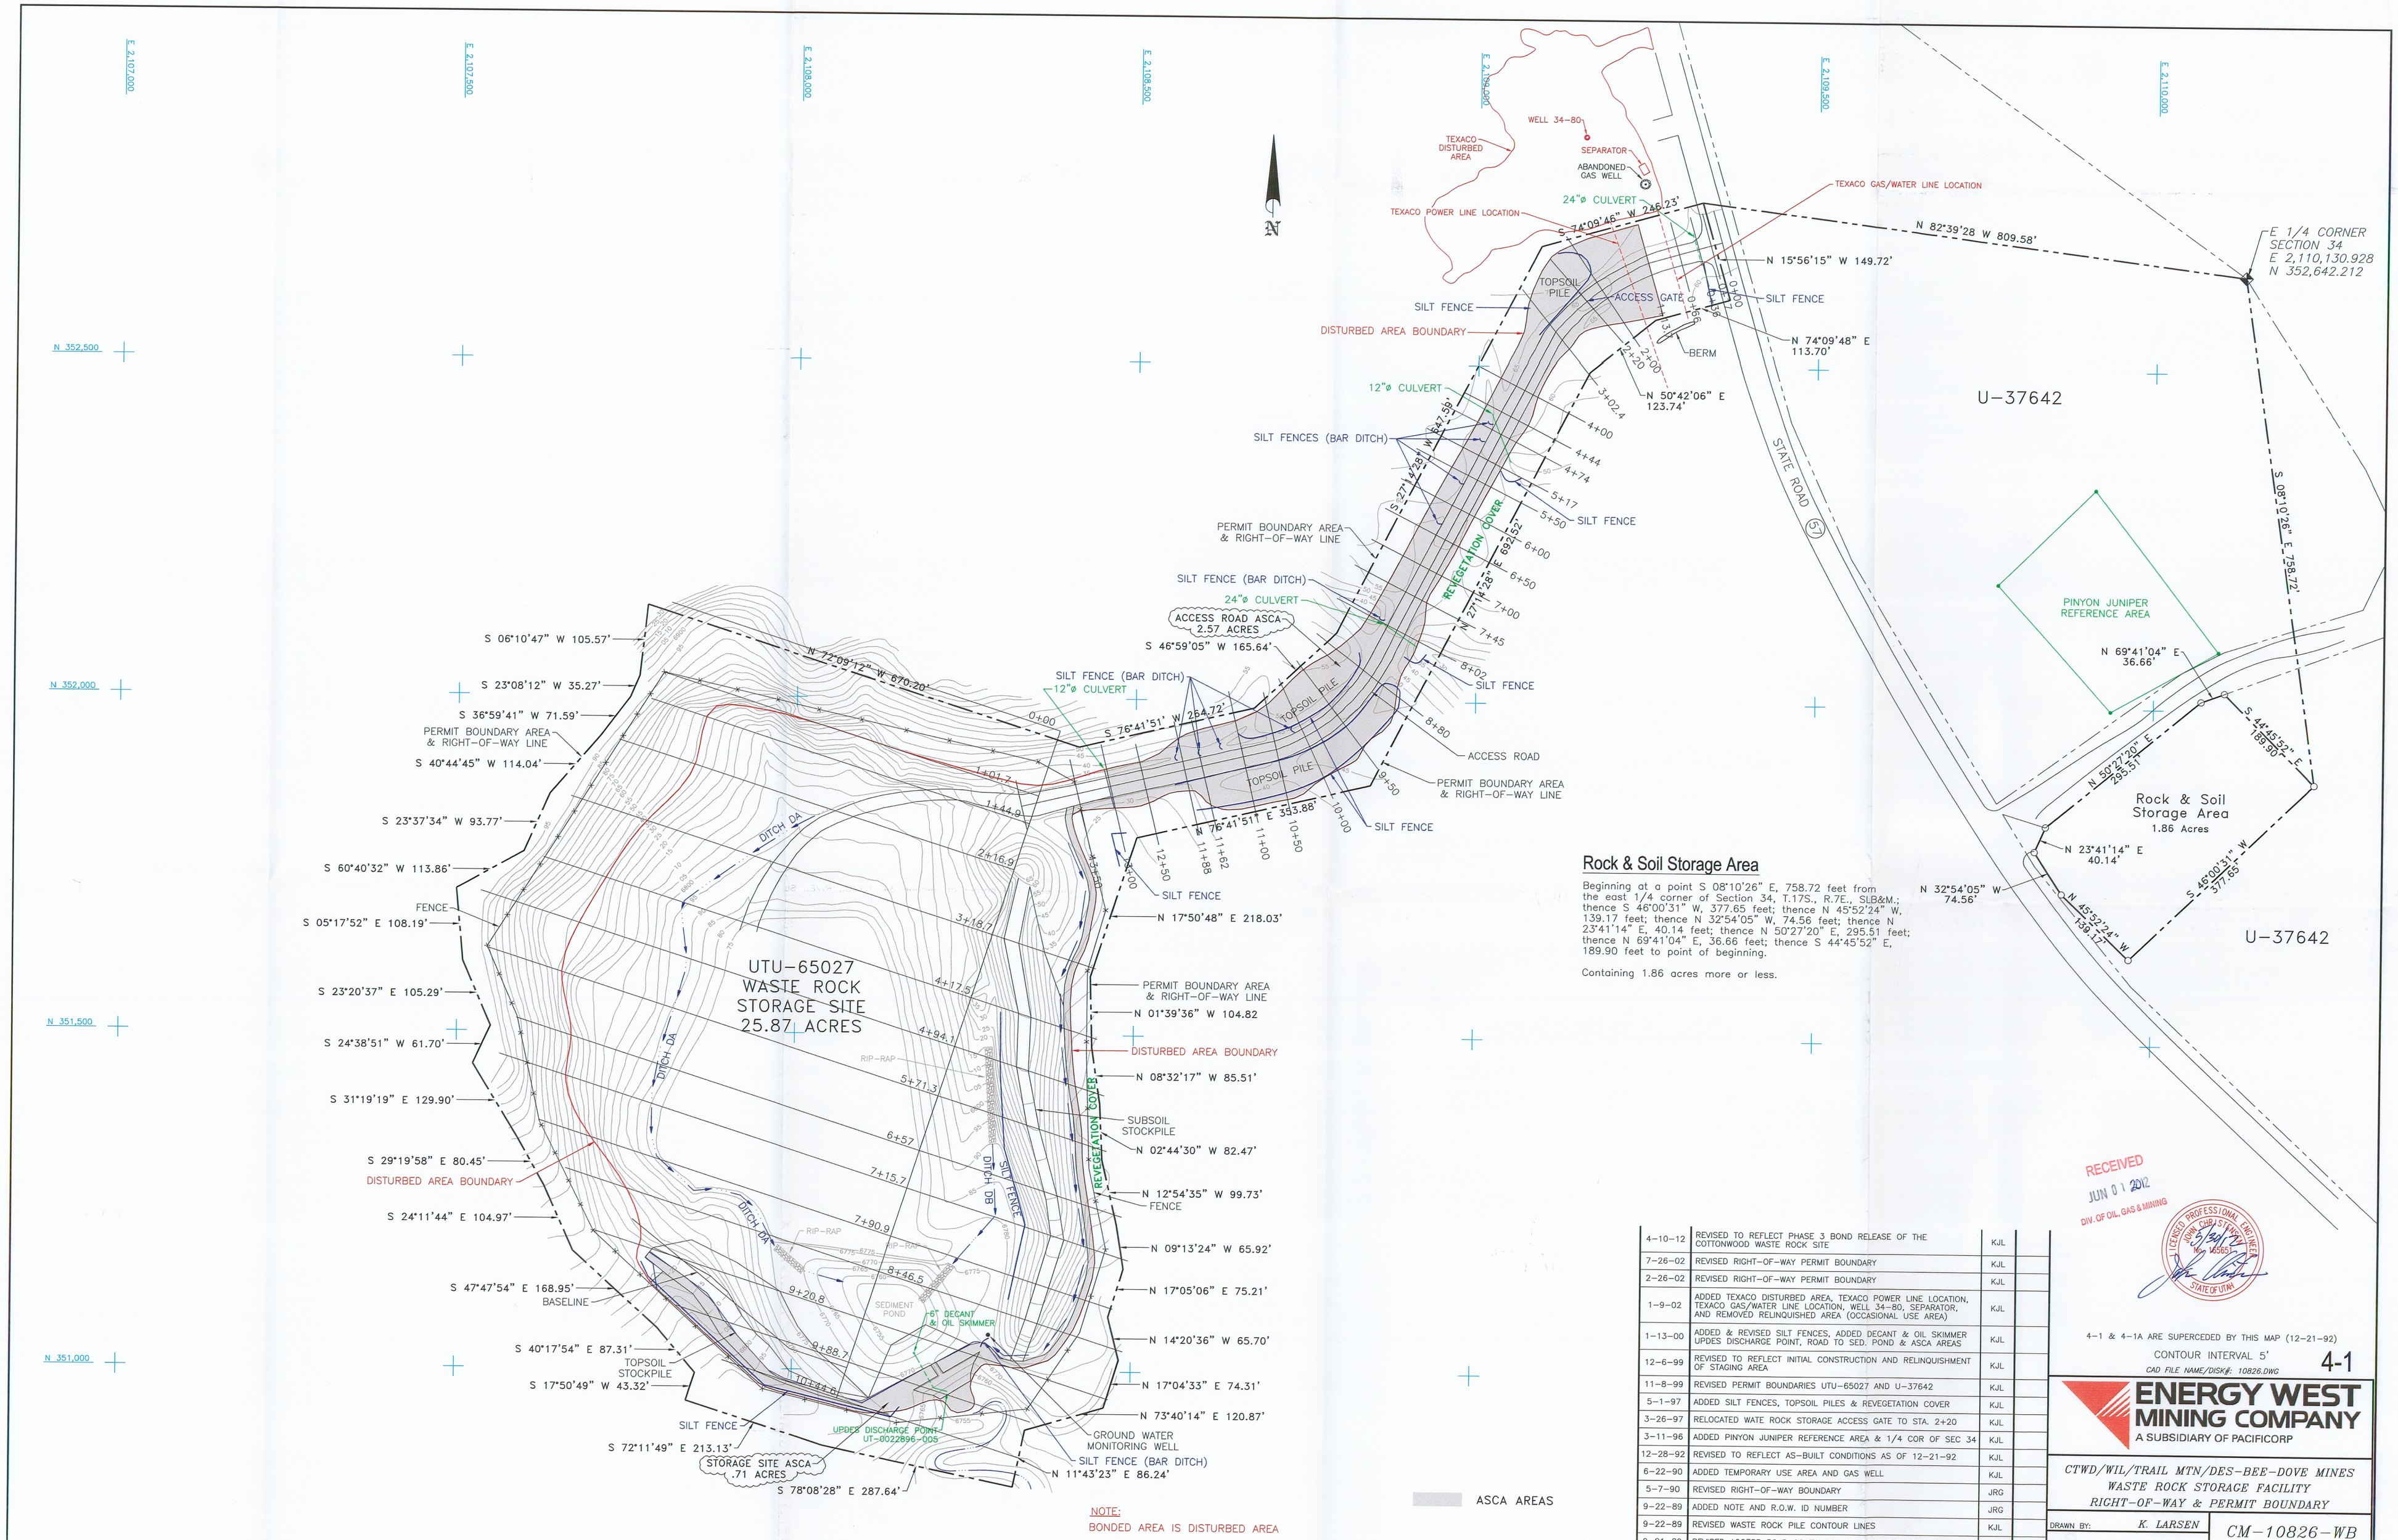

Rock & Soil Storage Area

Beginning at a point S 08°10'26" E, 758.72 feet from the east 1/4 corner of Section 34, T.17S., R.7E., SLB&M.; thence S 46°00'31" W, 377.65 feet; thence N 45°52'24" W, 139.17 feet; thence N 32°54'05" W, 74.56 feet; thence N 23°41'14" E, 40.14 feet; thence N 50°27'20" E, 295.51 feet; thence N 69°41'04" E, 36.66 feet; thence S 44°45'52" E, 189.90 feet to point of beginning.

Containing 1.86 acres more or less.

NOTE:
BONDED AREA IS DISTURBED AREA

DATE	REVISIONS	BY	CHK
4-10-12	REVISED TO REFLECT PHASE 3 BOND RELEASE OF THE COTTONWOOD WASTE ROCK SITE	KJL	
7-26-02	REVISED RIGHT-OF-WAY PERMIT BOUNDARY	KJL	
2-26-02	REVISED RIGHT-OF-WAY PERMIT BOUNDARY	KJL	
1-9-02	ADDED TEXACO DISTURBED AREA, TEXACO POWER LINE LOCATION, TEXACO GAS/WATER LINE LOCATION, WELL 34-80, SEPARATOR, AND REMOVED RELINQUISHED AREA (OCCASIONAL USE AREA)	KJL	
1-13-00	ADDED & REVISED SILT FENCES, ADDED DECANT & OIL SKIMMER UPDES DISCHARGE POINT, ROAD TO SED. POND & ASCA AREAS	KJL	
12-6-99	REVISED TO REFLECT INITIAL CONSTRUCTION AND RELINQUISHMENT OF STAGING AREA	KJL	
11-8-99	REVISED PERMIT BOUNDARIES UTU-65027 AND U-37642	KJL	
5-1-97	ADDED SILT FENCES, TOPSOIL PILES & REVEGETATION COVER	KJL	
3-26-97	RELOCATED WATE ROCK STORAGE ACCESS GATE TO STA. 2+20	KJL	
3-11-96	ADDED PINYON JUNIPER REFERENCE AREA & 1/4 COR OF SEC 34	KJL	
12-28-92	REVISED TO REFLECT AS-BUILT CONDITIONS AS OF 12-21-92	KJL	
6-22-90	ADDED TEMPORARY USE AREA AND GAS WELL	KJL	
5-7-90	REVISED RIGHT-OF-WAY BOUNDARY	JRG	
9-22-89	ADDED NOTE AND R.O.W. ID NUMBER	JRG	
9-22-89	REVISED WASTE ROCK PILE CONTOUR LINES	KJL	
9-21-89	REVISED ACCESS ROAD CONTOURS AND SEDIMENT POND SIZE	KJL	

RECEIVED
JUN 01 2012
DIV. OF OIL, GAS & MINING

LICENSED PROFESSIONAL ENGINEER
JOHN CRAIG STEWART
No. 163651
5/30/12
STATE OF UTAH

4-1 & 4-1A ARE SUPERCEDED BY THIS MAP (12-21-92)

CONTOUR INTERVAL 5'

CAD FILE NAME/DISK#: 10826.DWG

4-1

ENERGY WEST MINING COMPANY
A SUBSIDIARY OF PACIFICORP

CTWD/WIL/TRAIL MTN/DES-BEE-DOVE MINES
WASTE ROCK STORAGE FACILITY
RIGHT-OF-WAY & PERMIT BOUNDARY

DRAWN BY: K. LARSEN
SCALE: 1"=100'
DRAWING #: CM-10826-WB
DATE: APRIL 10, 2012
SHEET 1 OF 1
REV.