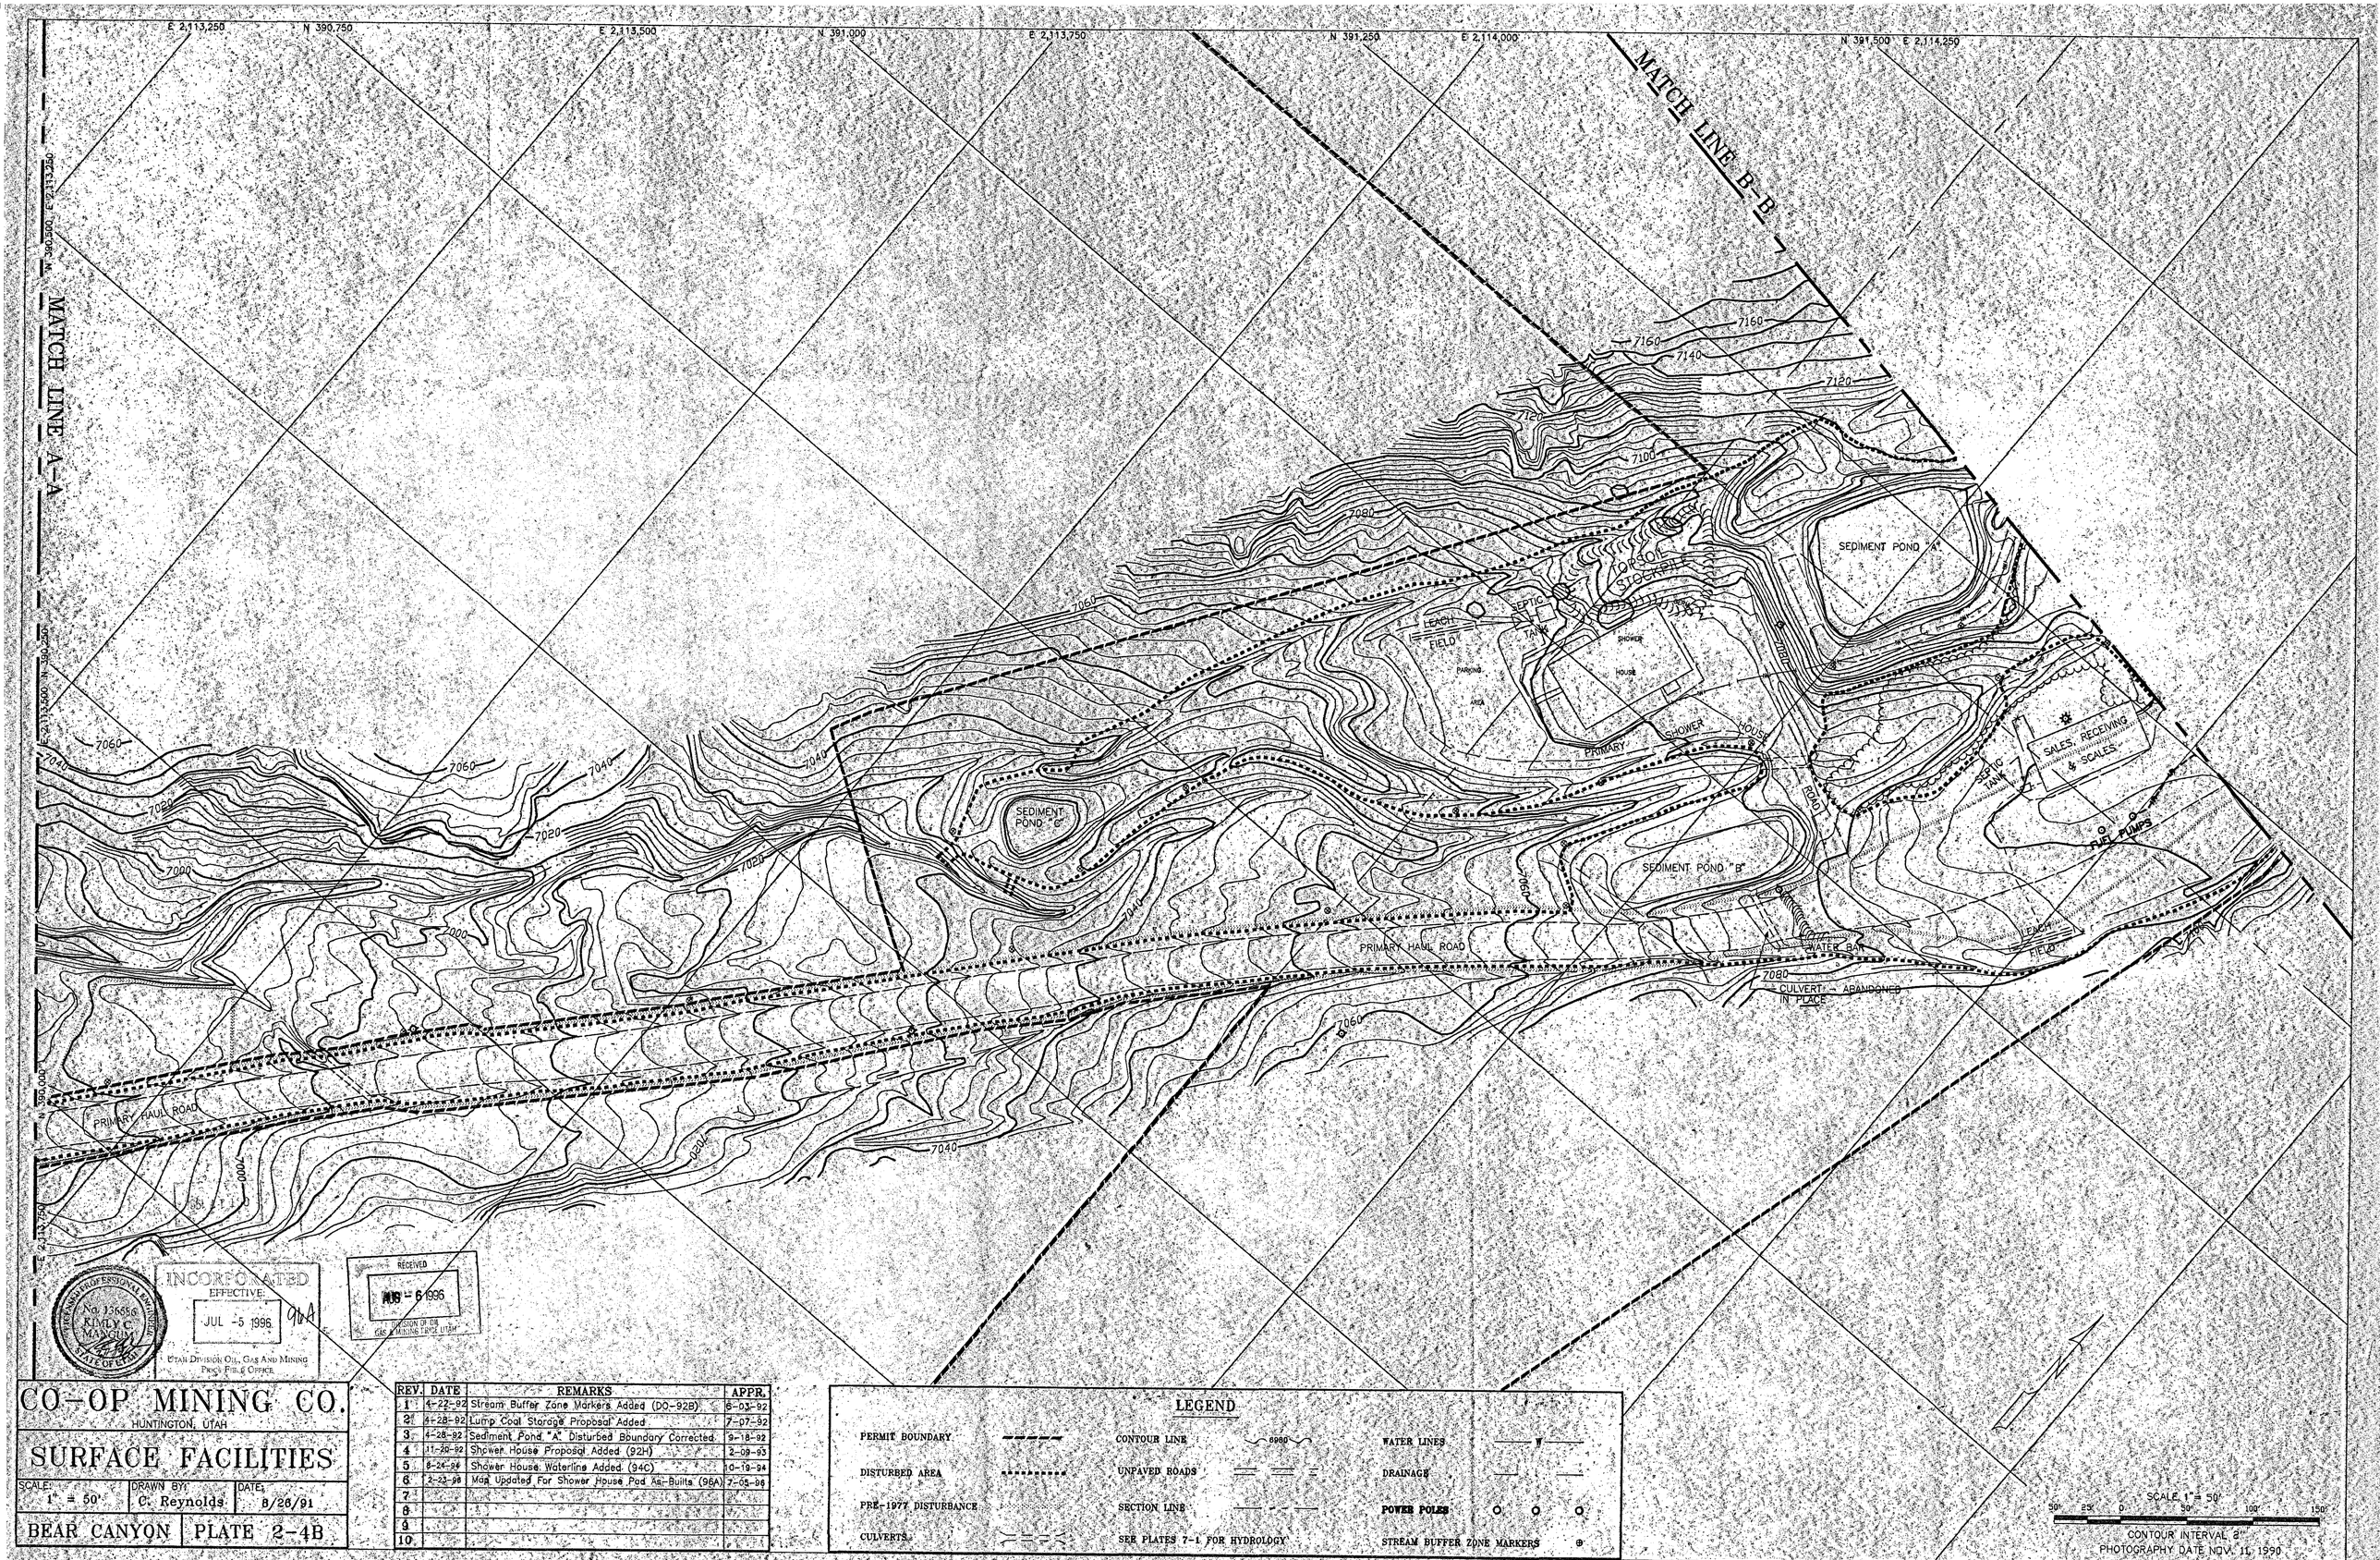

INCORPORATED
EFFECTIVE:
JUL -5 1996
96A
UTAH DIVISION OIL, GAS AND MINING
PRICE FIELD OFFICE

RECEIVED
AUG - 6 1996
DIVISION OF OIL GAS & MINING PRICE UTAH

PROFESSIONAL ENGINEER
No. 136556
KIMLY C. MANGUM
STATE OF UTAH

CO-OP MINING CO.

HUNTINGTON, UTAH

SURFACE FACILITIES

SCALE:	DRAWN BY:	DATE:
1" = 50'	C. Reynolds	8/26/91

BEAR CANYON | PLATE 2-4B

REV.	DATE	REMARKS	APPR.
1	4-22-92	Stream Buffer Zone Markers Added (DO-92B)	6-03-92
2	4-28-92	Lump Coal Storage Proposal Added	7-07-92
3	4-28-92	Sediment Pond "A" Disturbed Boundary Corrected	9-18-92
4	11-20-92	Shower House Proposal Added (92H)	2-09-93
5	8-24-94	Shower House Waterline Added (94C)	10-19-94
6	2-23-96	Map Updated For Shower House Pad As-Builts (96A)	7-05-96
7			
8			
9			
10			

LEGEND

PERMIT BOUNDARY		CONTOUR LINE	6980	WATER LINES	W
DISTURBED AREA		UNPAVED ROADS		DRAINAGE	
PRE-1977 DISTURBANCE		SECTION LINE		POWER POLES	
CULVERTS		SEE PLATES 7-1 FOR HYDROLOGY		STREAM BUFFER ZONE MARKERS	

SCALE 1" = 50'
50' 25' 0 50' 100' 150'
CONTOUR INTERVAL 2'
PHOTOGRAPHY DATE NOV. 11, 1990