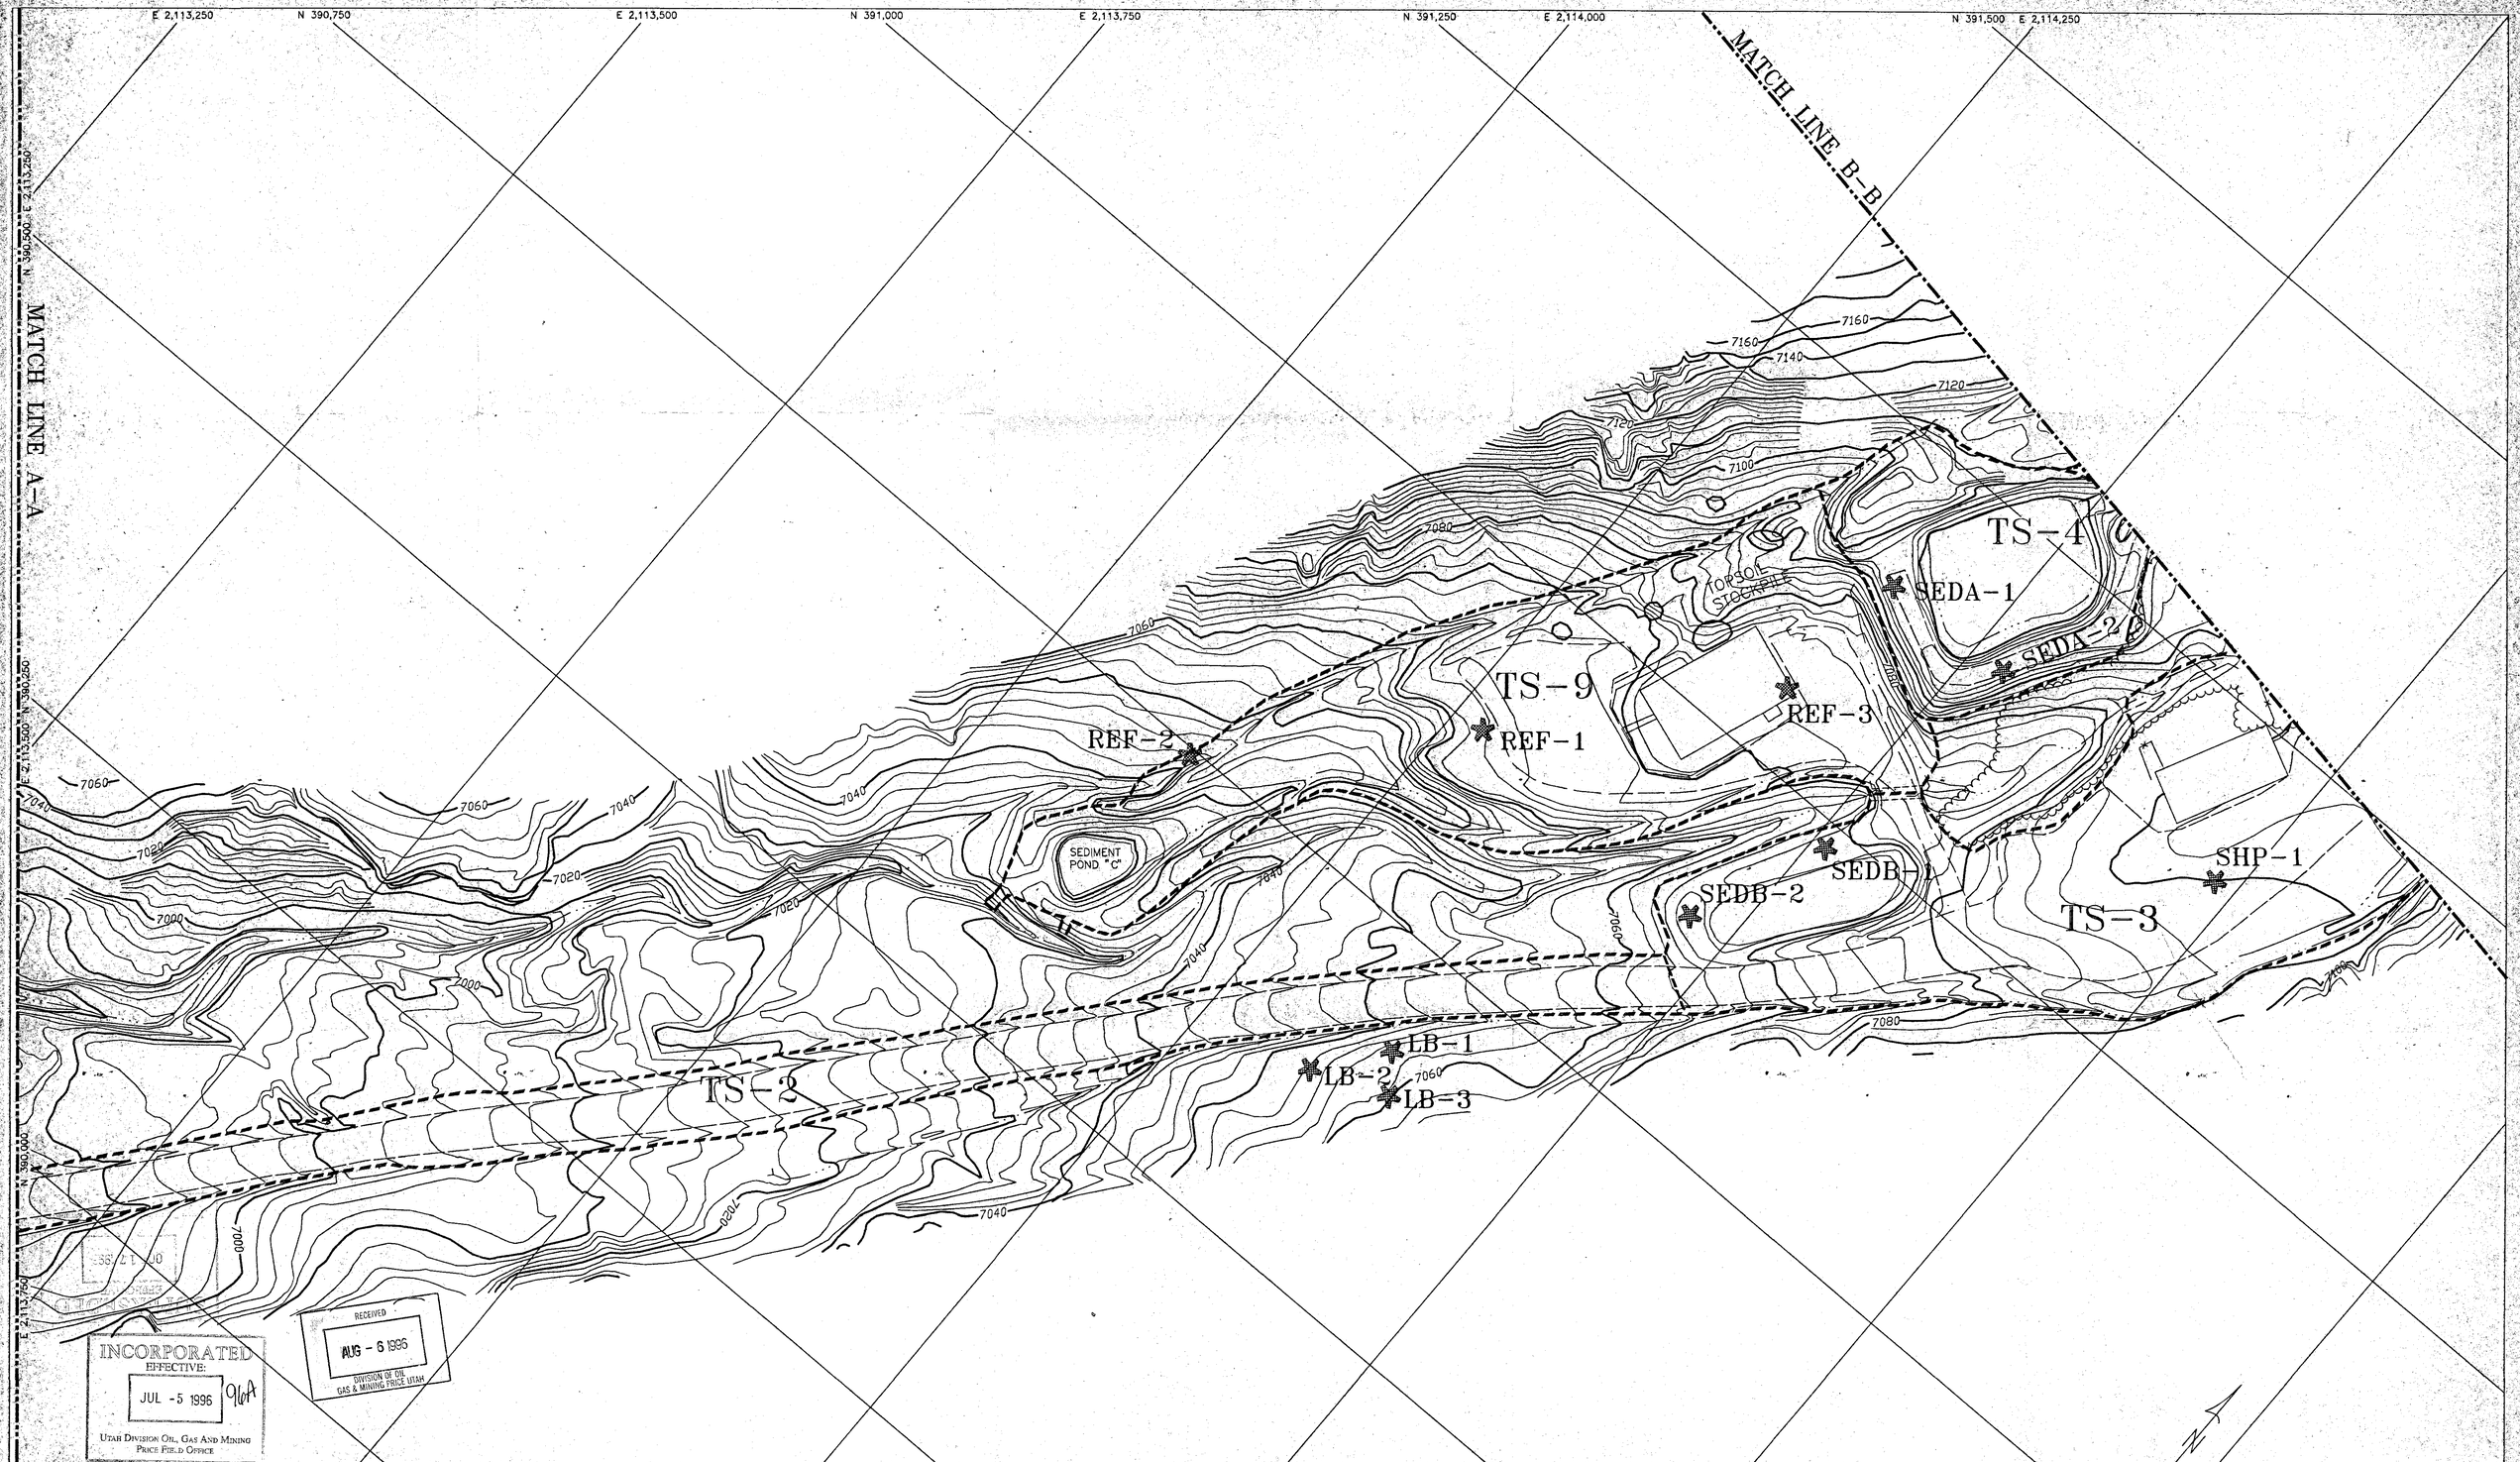

INCORPORATED
EFFECTIVE:
JUL -5 1996 96A
UTAH DIVISION OIL, GAS AND MINING
PRICE FIELD OFFICE

RECEIVED
AUG - 6 1996
DIVISION OF OIL, GAS & MINING PRICE UTAH

CO-OP MINING CO.

HUNTINGTON, UTAH

RECLAMATION AREA

SCALE:	DRAWN BY:	DATE:
1" = 50'	C. REYNOLDS	5/13/91

BEAR CANYON | PLATE 8-5B

REV.	DATE	REMARKS	APPR.
1	10/91	Soil Sample Locations Plotted	10/91
2	04/28/92	Lump Coal Storage Proposal Added	07/07/92
3	04/28/92	Sed. Pond "A" Dist. Bound. Corrected	09/18/92
4	11/20/92	Shower House Proposal Added (92H)	02/09/93
5	2/23/96	Updated for Shower House Pad As-Builts (96A)	7/05/96
6			
7			
8			
9			
10			

LEGEND

DISTURBED AREA

CONTOUR LINE 6900

RECLAMATION AREA

AREA NOT REQUIRING RECONTOURING OR TOPSOIL WITHIN THE DISTURBED AREA

TOPSOIL SAMPLE LOCATIONS

NOTE: WHERE DISTURBED AND RECLAMATION BOUNDARIES COINCIDE, ONLY THE RECLAMATION BOUNDARY IS SHOWN.

SEE PLATE 7-7 FOR POST MINING DRAINAGE.

SEE PLATES 2-4 FOR SURFACE FACILITIES, PERMIT BOUNDARY AND PRE-1977 DISTURBANCE.

SCALE 1" = 50'

50' 25' 0 50' 100' 150'

CONTOUR INTERVAL 2'

PHOTOGRAPHY DATE NOV. 11, 1990