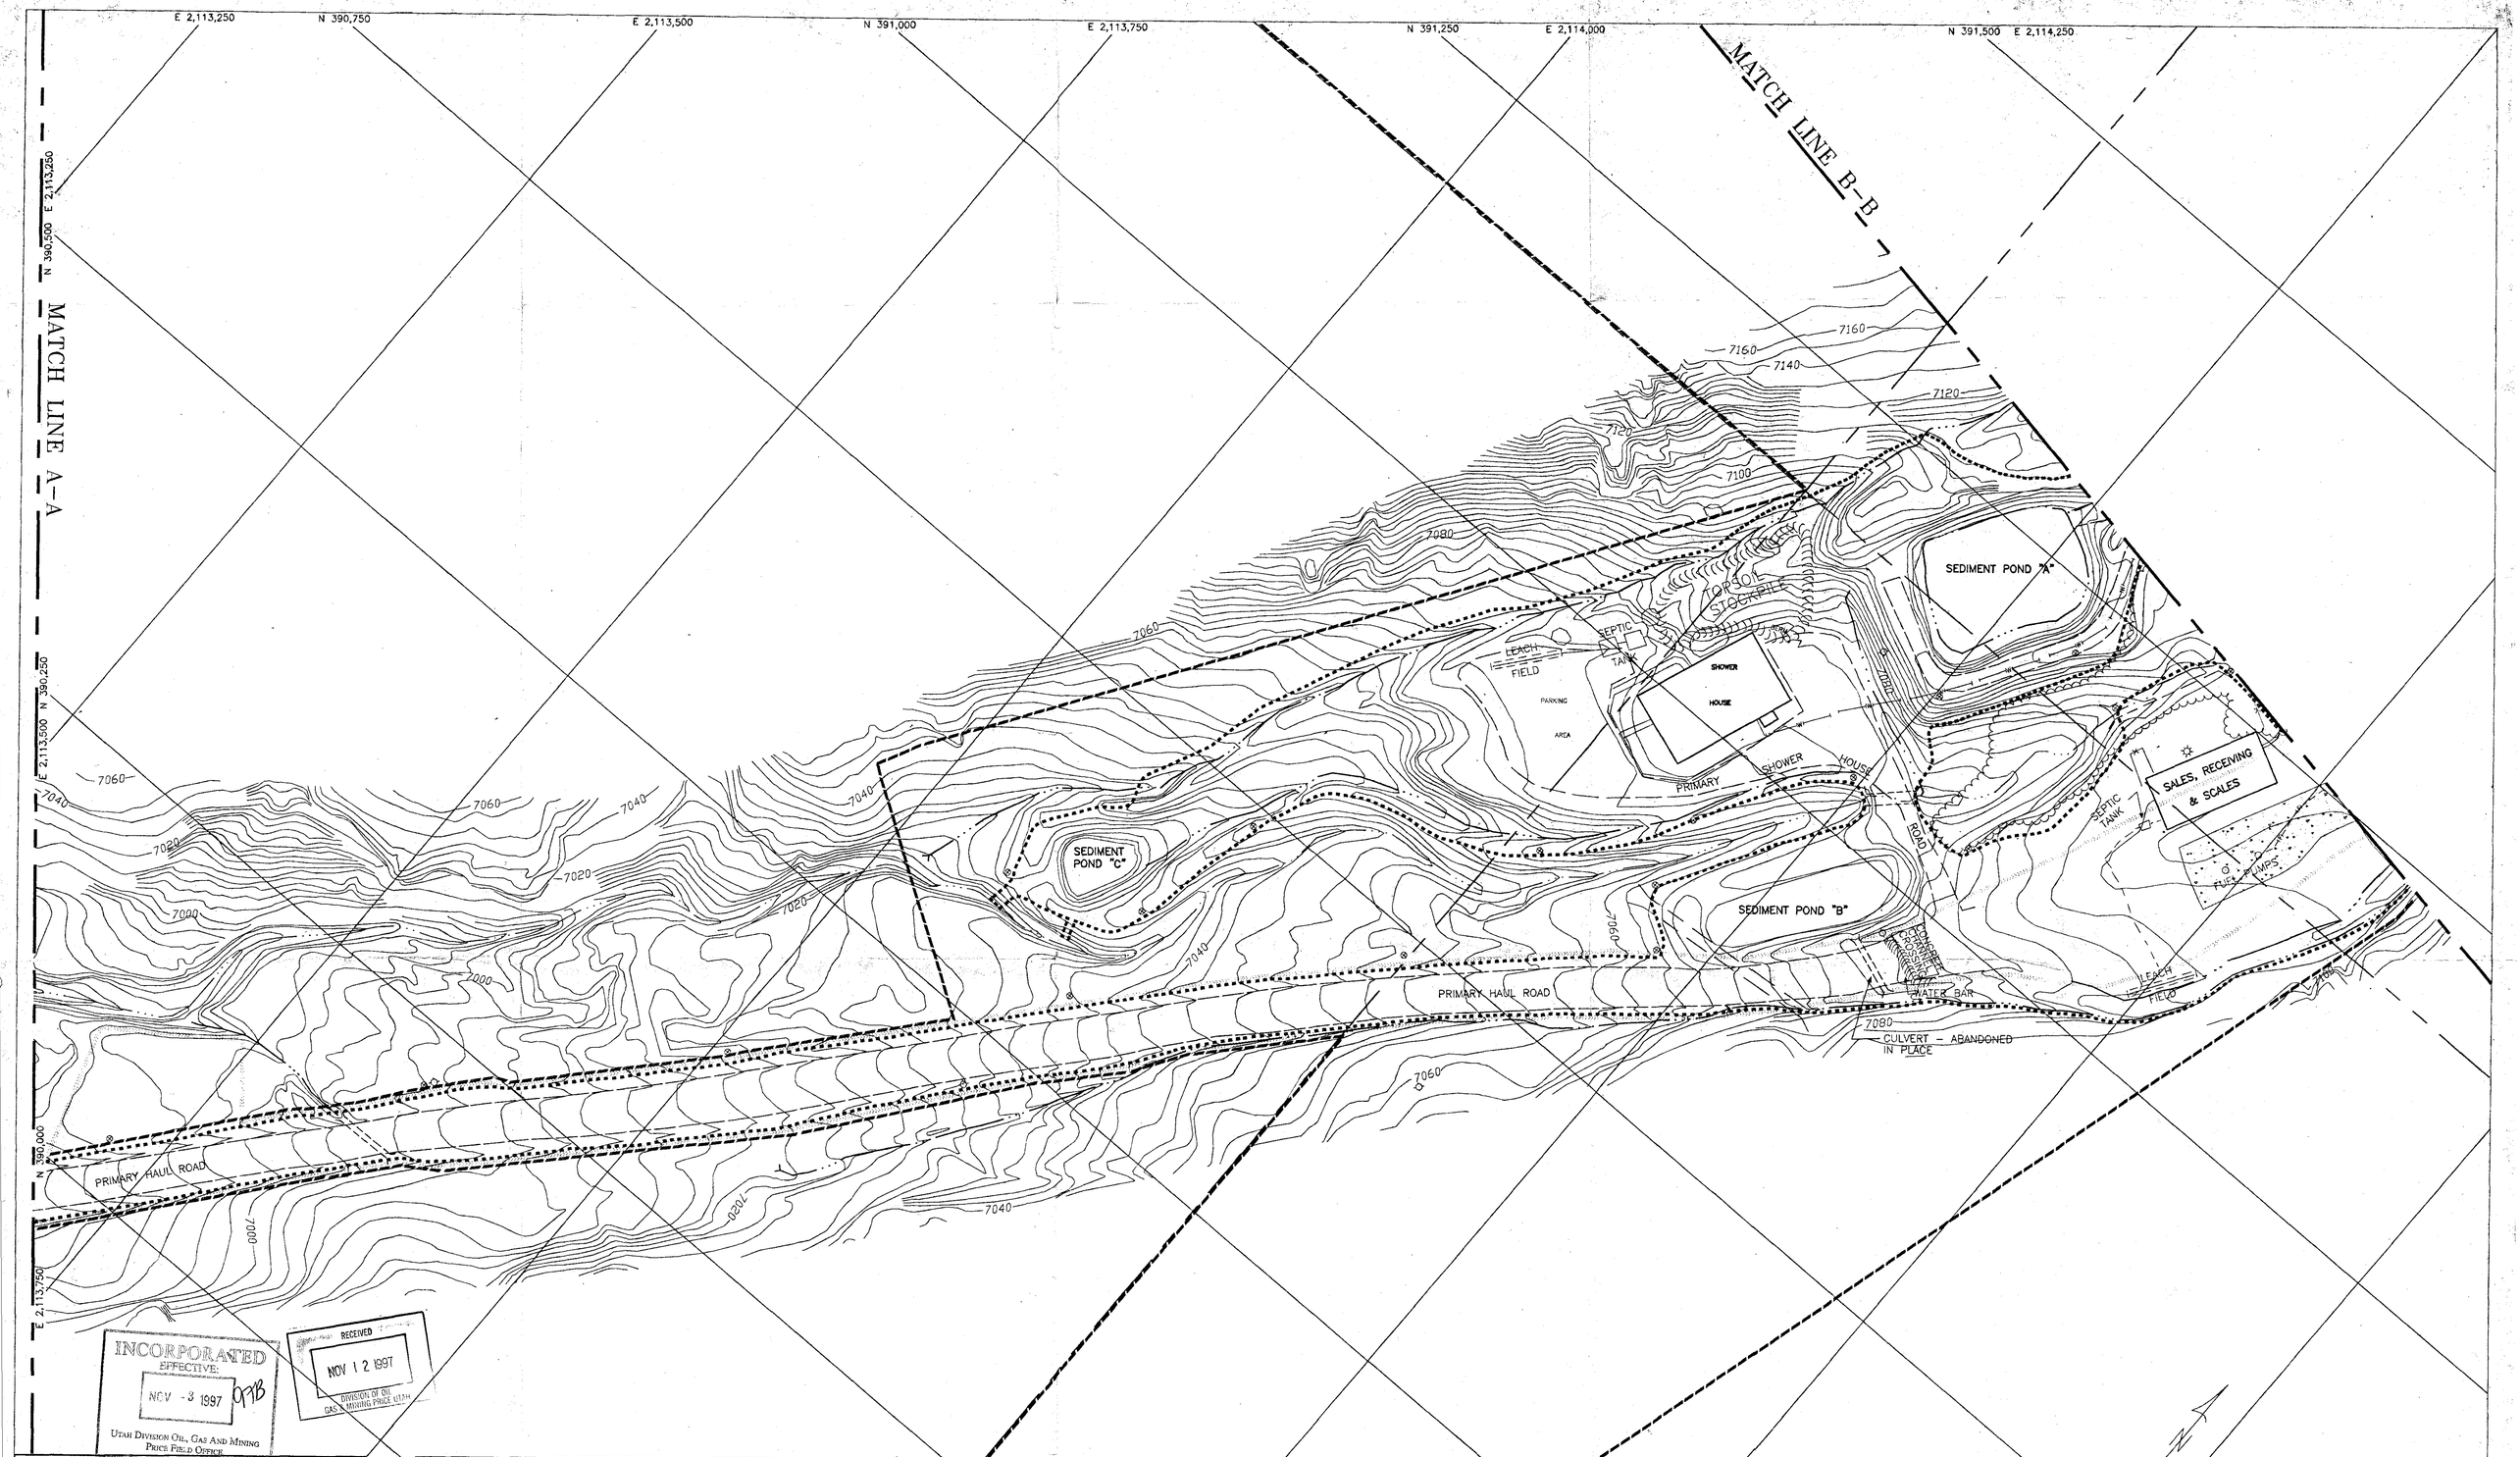

INCORPORATED
EFFECTIVE:
NOV -3 1997
UTAH DIVISION OIL, GAS AND MINING
PRICE FIELD OFFICE

RECEIVED
NOV 12 1997
DIVISION OF OIL GAS & MINING PRICE UTAH

CO-OP MINING CO.

HUNTINGTON, UTAH

SURFACE FACILITIES

SCALE:	DRAWN BY:	DATE:
1" = 50'	C. Reynolds	8/26/91

BEAR CANYON | PLATE 2-4B

REV.	DATE	REMARKS	APPR.
1	4-22-92	Stream Buffer Zone Markers Added (DO-92B)	6-03-92
2	4-28-92	Lump Coal Storage Proposal Added	7-07-92
3	4-28-92	Sediment Pond "A" Disturbed Boundary Corrected	9-18-92
4	11-20-92	Shower House Proposal Added (92H)	2-09-93
5	6-24-94	Shower House Waterline Added (94C)	10-19-94
6	2-23-96	Map Updated For Shower House Pad As-Builts (96A)	7-05-96
7	7-22-96	D-BD Water Bar Concrete Crossing Added (96C)	9-04-96
8	6-23-97	Scalehouse Pavement Added (97B)	11-3-97
9			
10			

LEGEND

PERMIT BOUNDARY		CONTOUR LINE	6980	PAVEMENT	
DISTURBED AREA		UNPAVED ROADS		WATER LINES	W
PRE-1977 DISTURBANCE		SECTION LINE		DRAINAGE	
CULVERTS		SEE PLATES 7-1 FOR HYDROLOGY		POWER POLES	
				STREAM BUFFER ZONE MARKERS	⊕

LICENSED PROFESSIONAL ENGINEER
CHARLES REYNOLDS
No. 179670
STATE OF UTAH
10-28-97

SCALE 1" = 50'
50' 25' 0 50' 100' 150'
CONTOUR INTERVAL 2'
PHOTOGRAPHY DATE NOV. 11, 1990