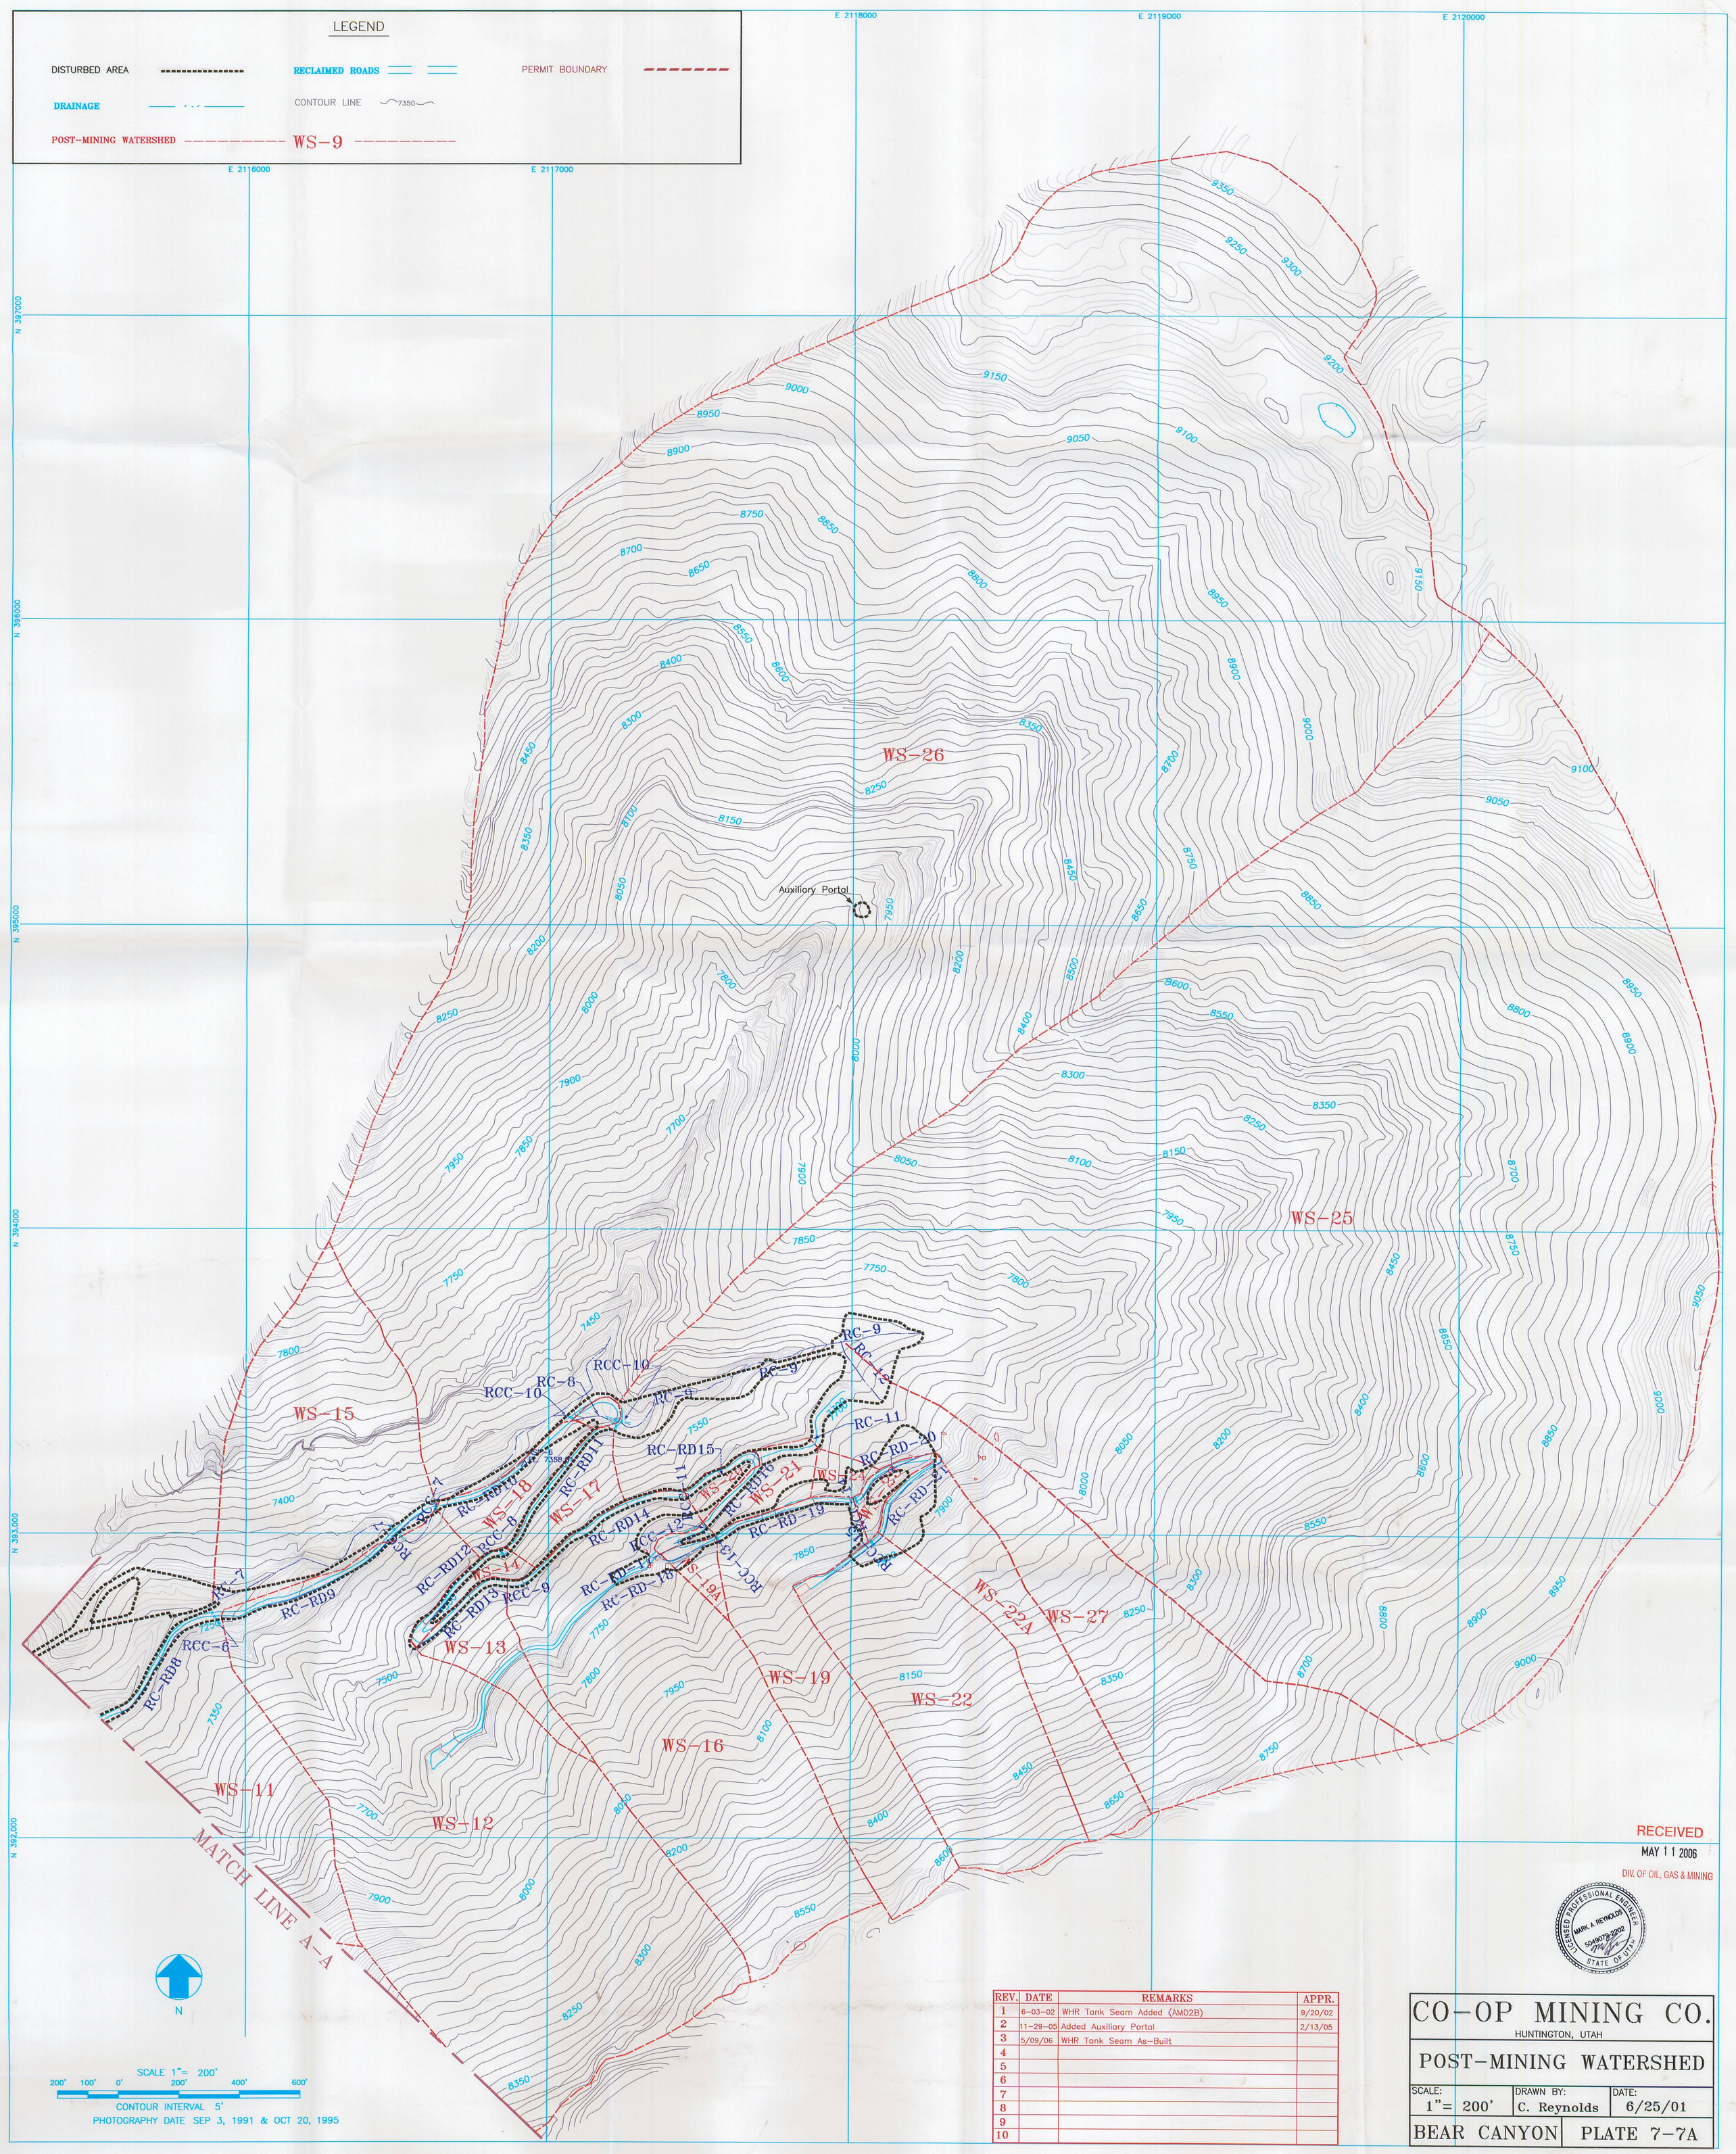

REV.	DATE	REMARKS	APPR.
1	6-03-02	WHR Tank Seam Added (AM02B)	9/20/02
2	11-29-05	Added Auxiliary Portal	2/13/05
3	5/09/06	WHR Tank Seam As-Built	
4			
5			
6			
7			
8			
9			
10			

CO-OP MINING CO.

HUNTINGTON, UTAH

POST-MINING WATERSHED

SCALE:	DRAWN BY:	DATE:
1"= 200'	C. Reynolds	6/25/01

BEAR CANYON — PLATE 7-7A