CO-OP MINING CO.

HUNTINGTON, UTAH

HYDROLOGY MAP

SCALE:	DRAWN BY:	DATE:
1" = 50'	C. Reynolds	6-25-01

BEAR CANYON | PLATE 7-1F
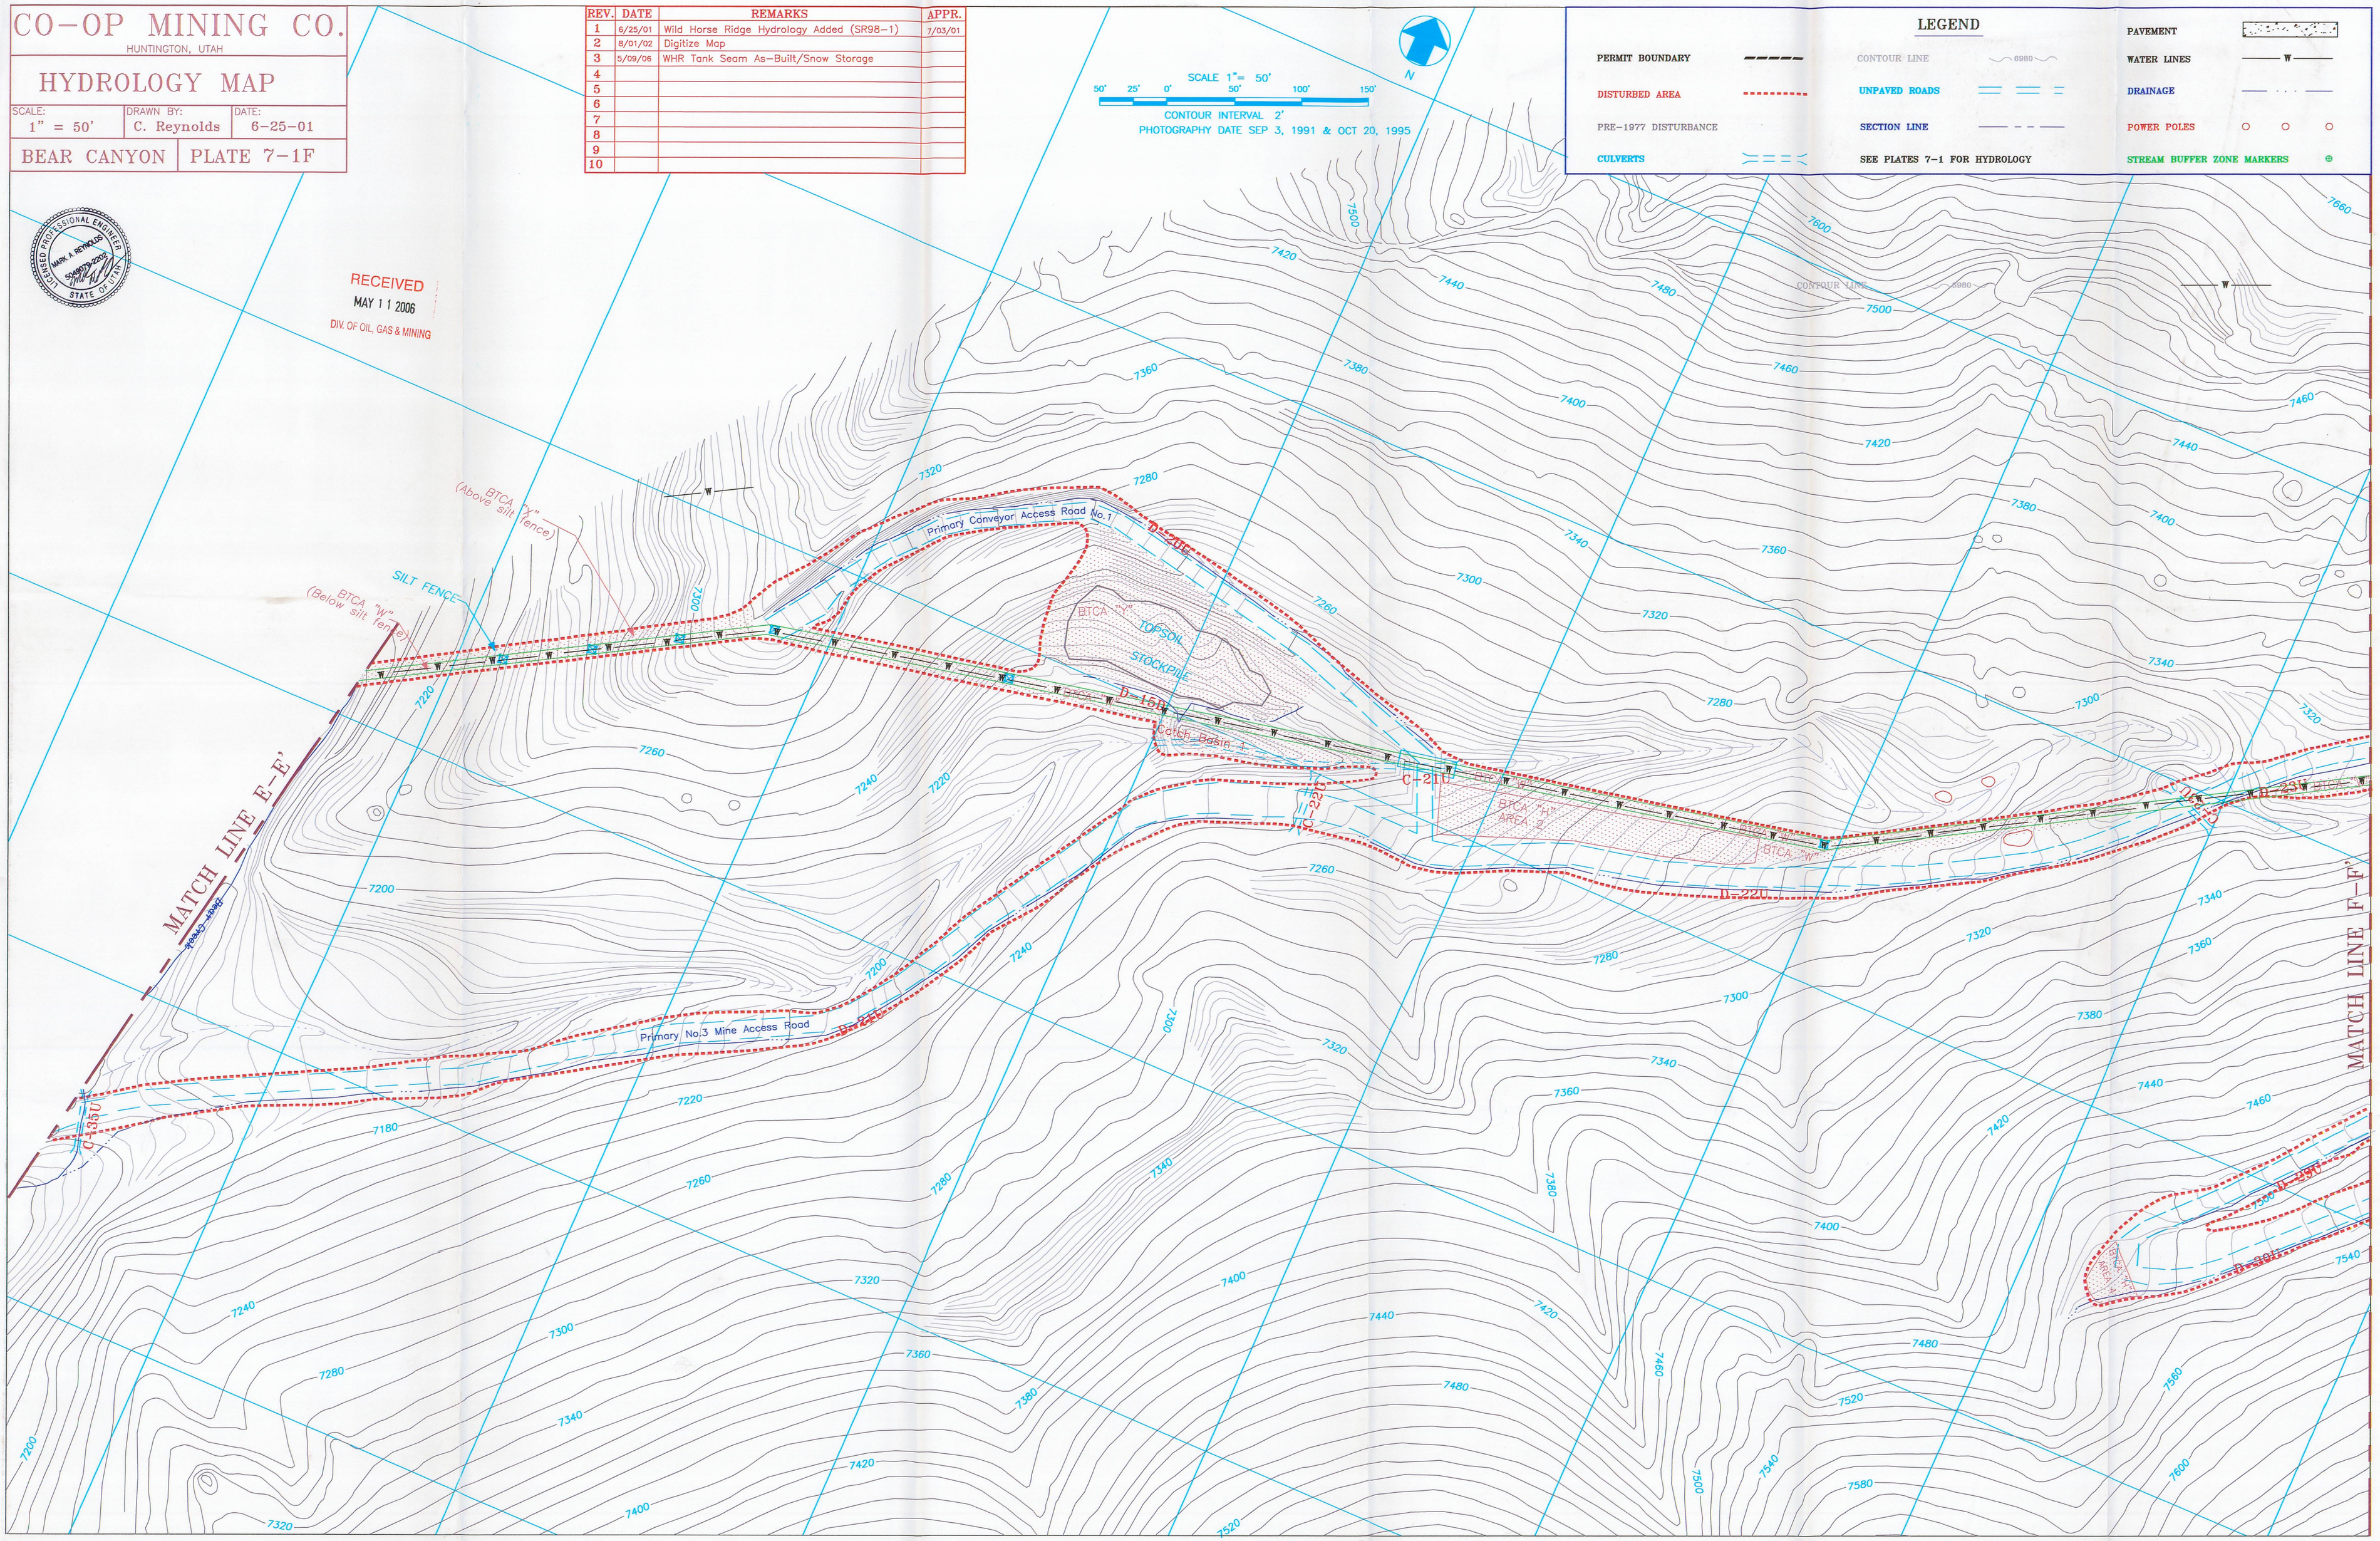
REV.	DATE	REMARKS	APPR.
1	6/25/01	Wild Horse Ridge Hydrology Added (SR98-1)	7/03/01
2	8/01/02	Digitize Map	
3	5/09/06	WHR Tank Seam As-Built/Snow Storage	
4			
5			
6			
7			
8			
9			
10