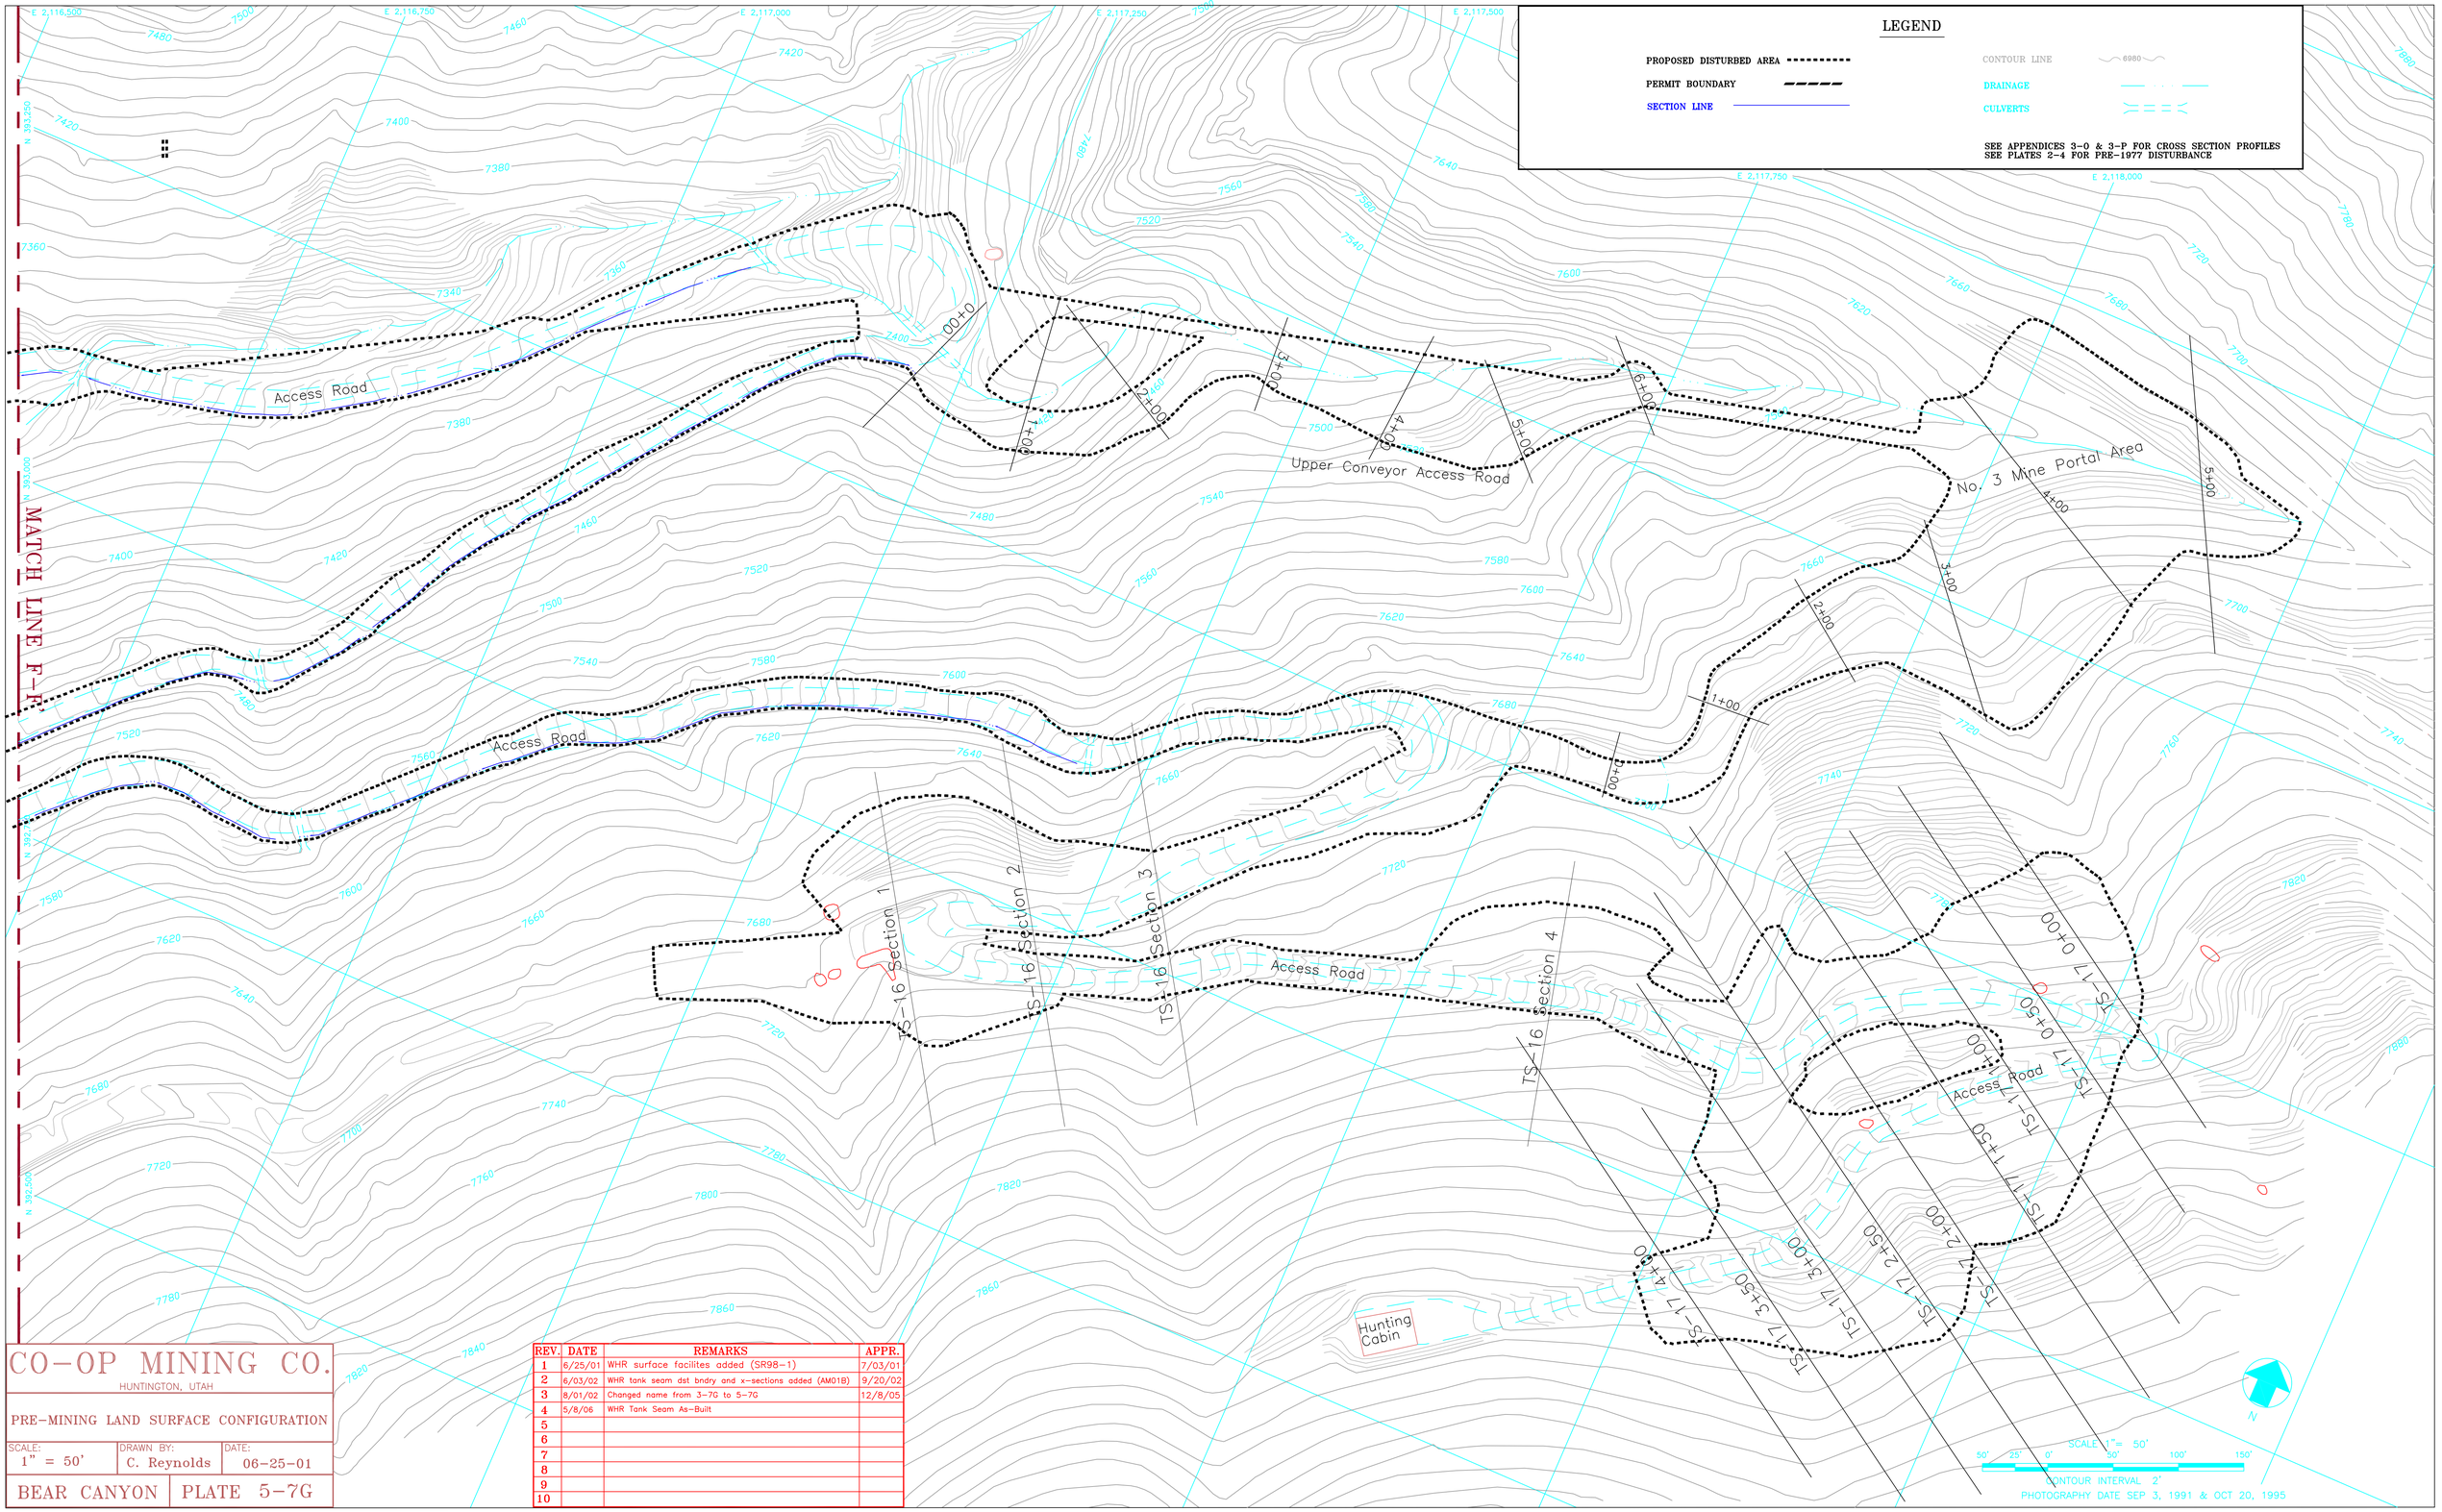

CO-OP MINING CO.

HUNTINGTON, UTAH

PRE-MINING LAND SURFACE CONFIGURATION

SCALE:	DRAWN BY:	DATE:
1" = 50'	C. Reynolds	06-25-01

BEAR CANYON | PLATE 5-7G

REV.	DATE	REMARKS	APPR.
1	6/25/01	WHR surface facilites added (SR98-1)	7/03/01
2	6/03/02	WHR tank seam dst bndry and x-sections added (AM01B)	9/20/02
3	8/01/02	Changed name from 3-7G to 5-7G	12/8/05
4	5/8/06	WHR Tank Seam As-Built	
5			
6			
7			
8			
9			
10			