CO-OP MINING CO.

HUNTINGTON, UTAH

HYDROLOGY MAP

SCALE:	DRAWN BY:	DATE:
1" = 50'	C. Reynolds	6-25-01

BEAR CANYON | PLATE 7-1F

REV.	DATE	REMARKS	APPR.
1	6/25/01	Wild Horse Ridge Hydrology Added (SR98-1)	7/03/01
2	8/01/02	Digitize Map	
3	5/09/06	WHR Tank Seam As-Built/Snow Storage	
4			
5			
6			
7			
8			
9			
10			

SCALE 1"= 50'

50' 25' 0' 50' 100' 150'

CONTOUR INTERVAL 2'

PHOTOGRAPHY DATE SEP 3, 1991 & OCT 20, 1995

N

LEGEND
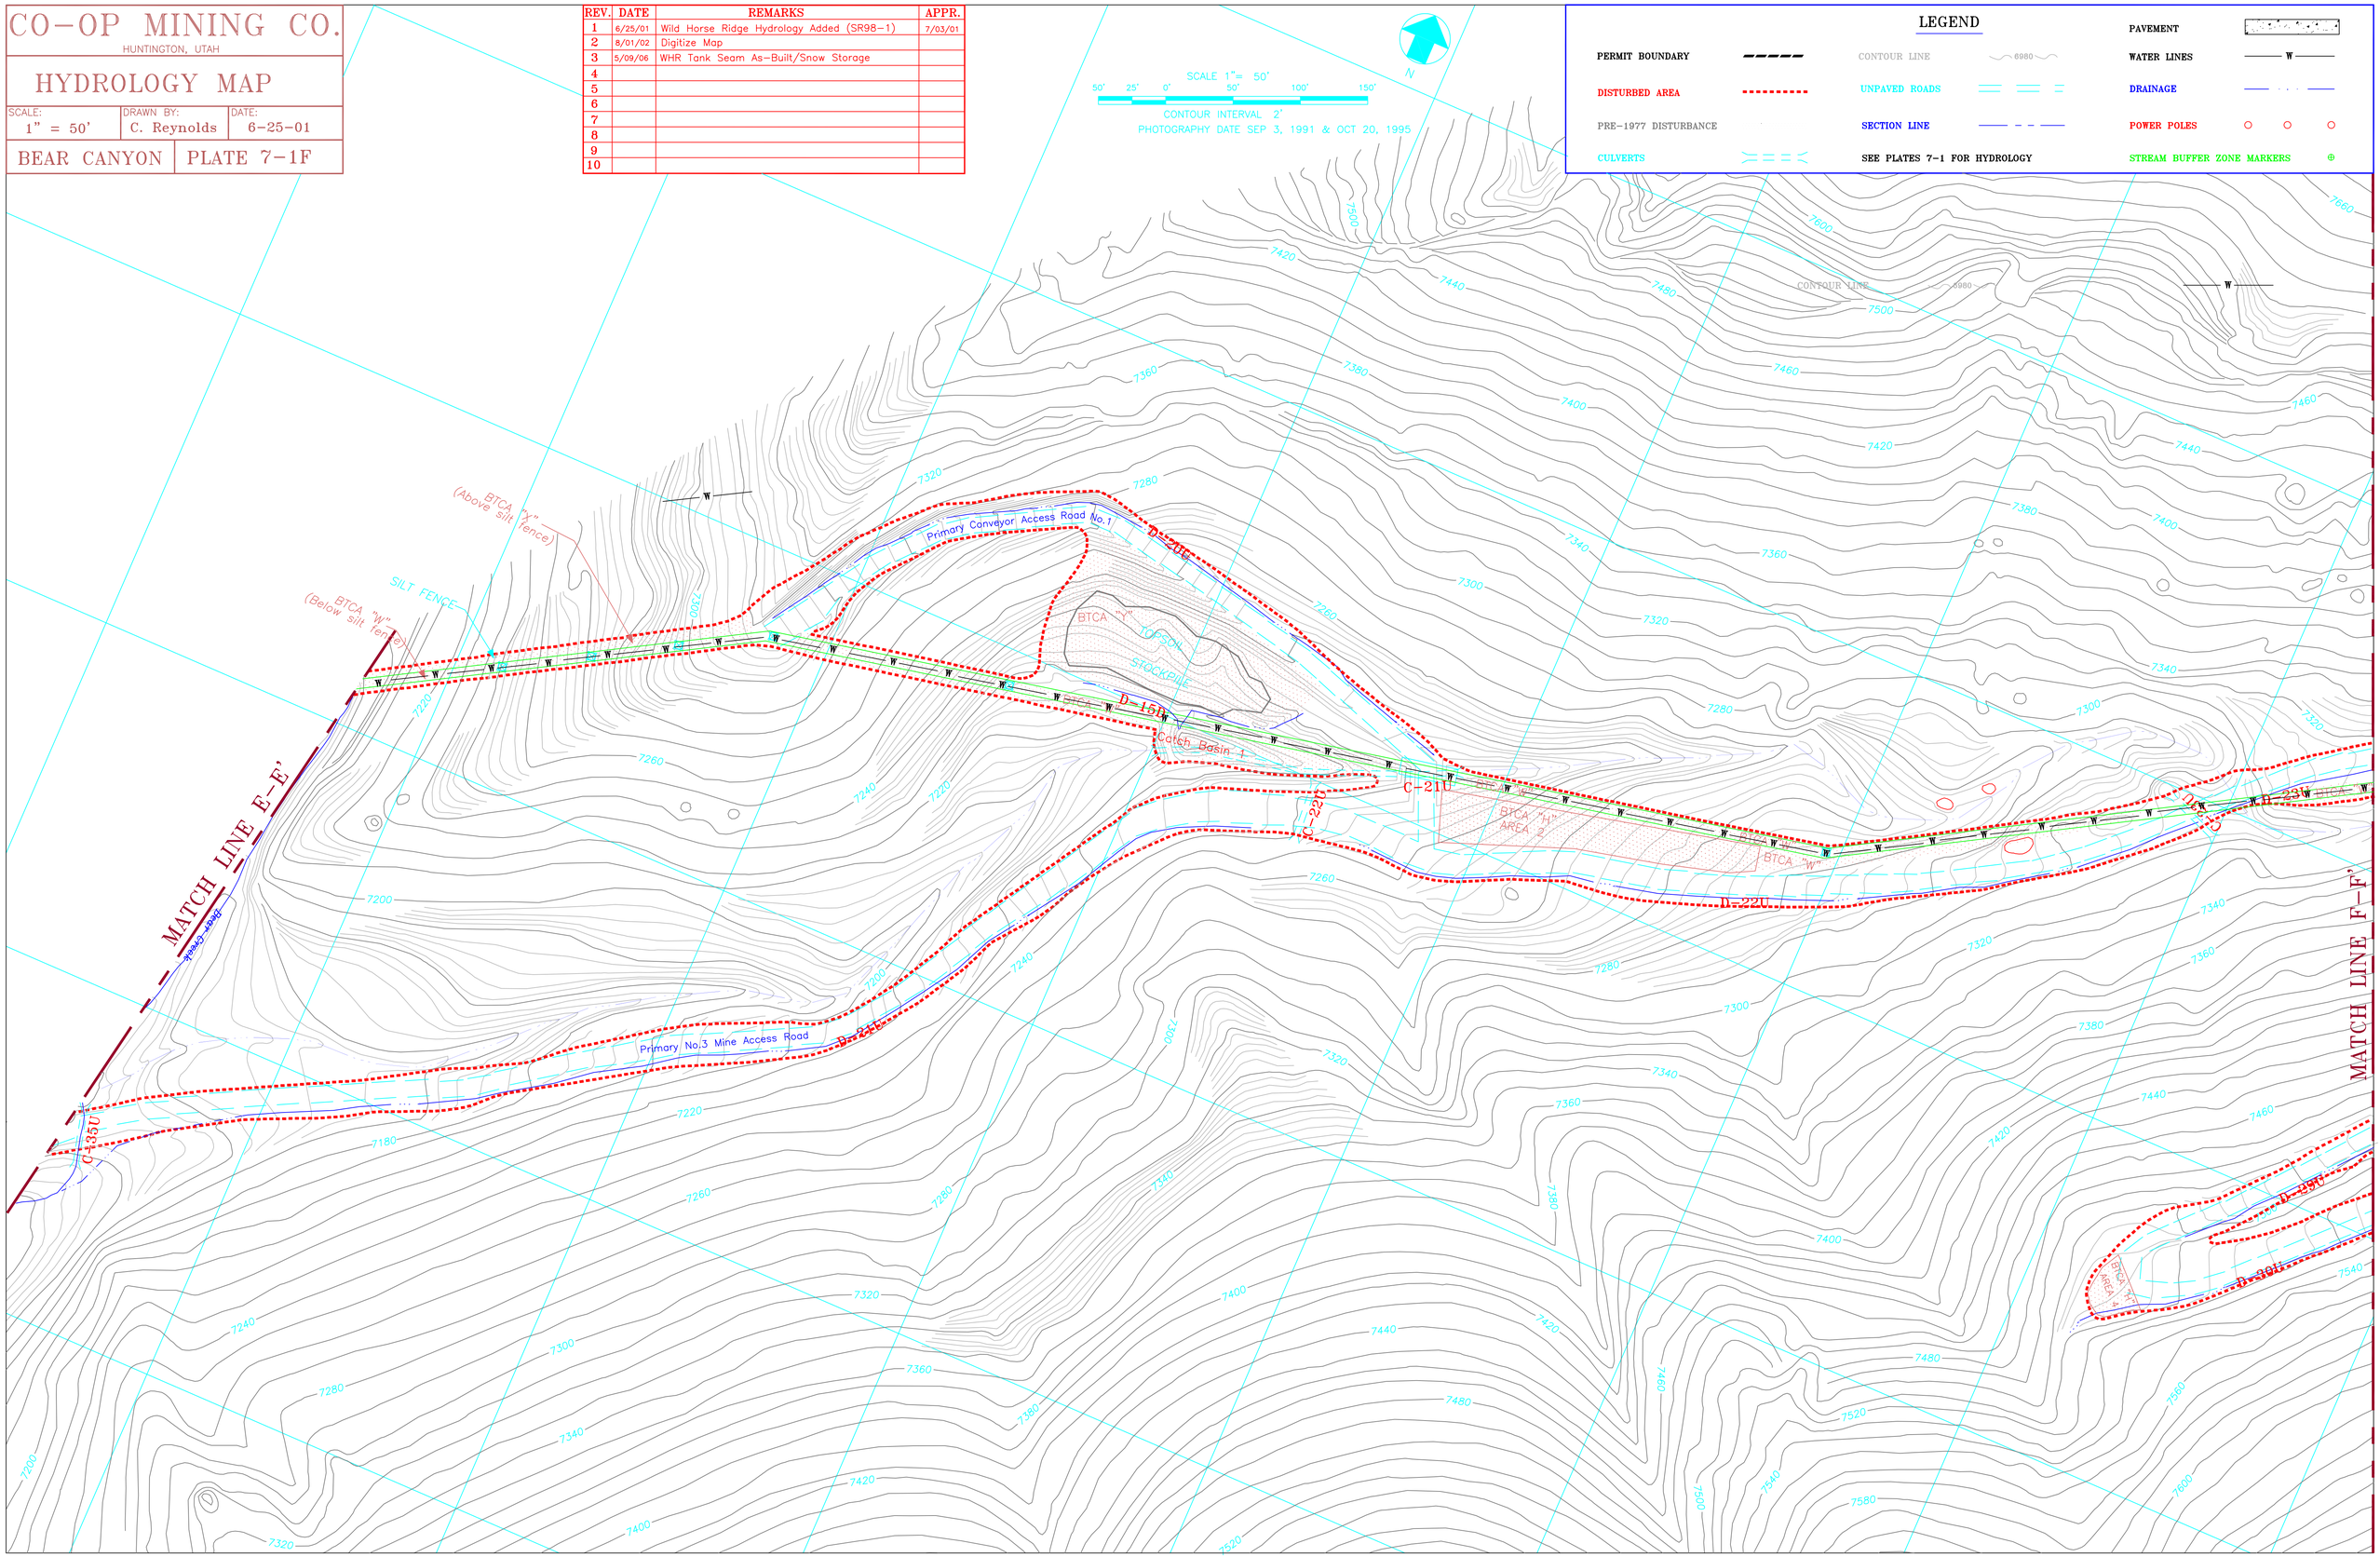
- PERMIT BOUNDARY
- DISTURBED AREA
- PRE-1977 DISTURBANCE
- CULVERTS
- CONTOUR LINE (6980)
- UNPAVED ROADS
- SECTION LINE
- SEE PLATES 7-1 FOR HYDROLOGY
- PAVEMENT
- WATER LINES (W)
- DRAINAGE
- POWER POLES
- STREAM BUFFER ZONE MARKERS